


DATUM ELEV = 145.00

DATUM ELEV = 145.00

DATUM ELEV = 145.00

DATUM ELEV = 145.00

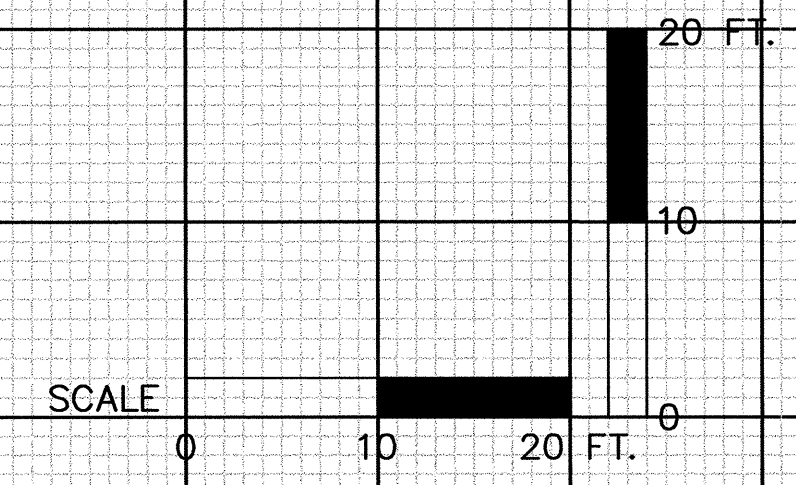

**ERDMAN ANTHONY**  
CONSULTING ENGINEERS  
Rochester, New York    Camp Hill, Pennsylvania  
Boston, Massachusetts

AS-BUILT REVISIONS		REVISED SEWER DESIGN	
NO.	DATE	DESCRIPTION	DATE
1.	8/29/06	CHANGES MADE PER AS-BUILTS MARK UPS	4/4/03

SHELBURNE - SOUTH BURLINGTON  
STA. 399+40 TO STA. 400+48  
SURVEYED BY V.S.C. INC. DATE \_\_\_\_\_  
DRAWN BY E.A.A. INC. DATE \_\_\_\_\_  
TRACED BY E.A.A. INC. DATE \_\_\_\_\_  
PROJECT NH-EGC-019-4(28)  
CROSS-SECTION DWG. NO. 103  
SHEET 195R OF 283