
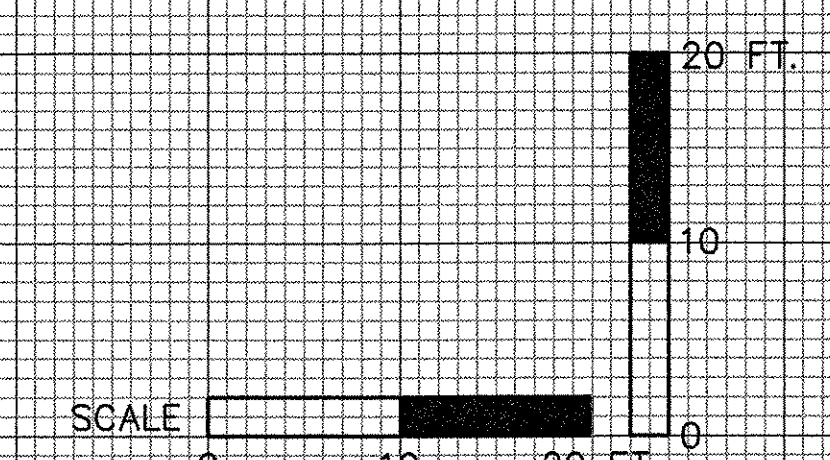


DATUM ELEV = 145.00

DATUM ELEV = 145.00

DATUM ELEV = 145.00

DATUM ELEV = 145.00

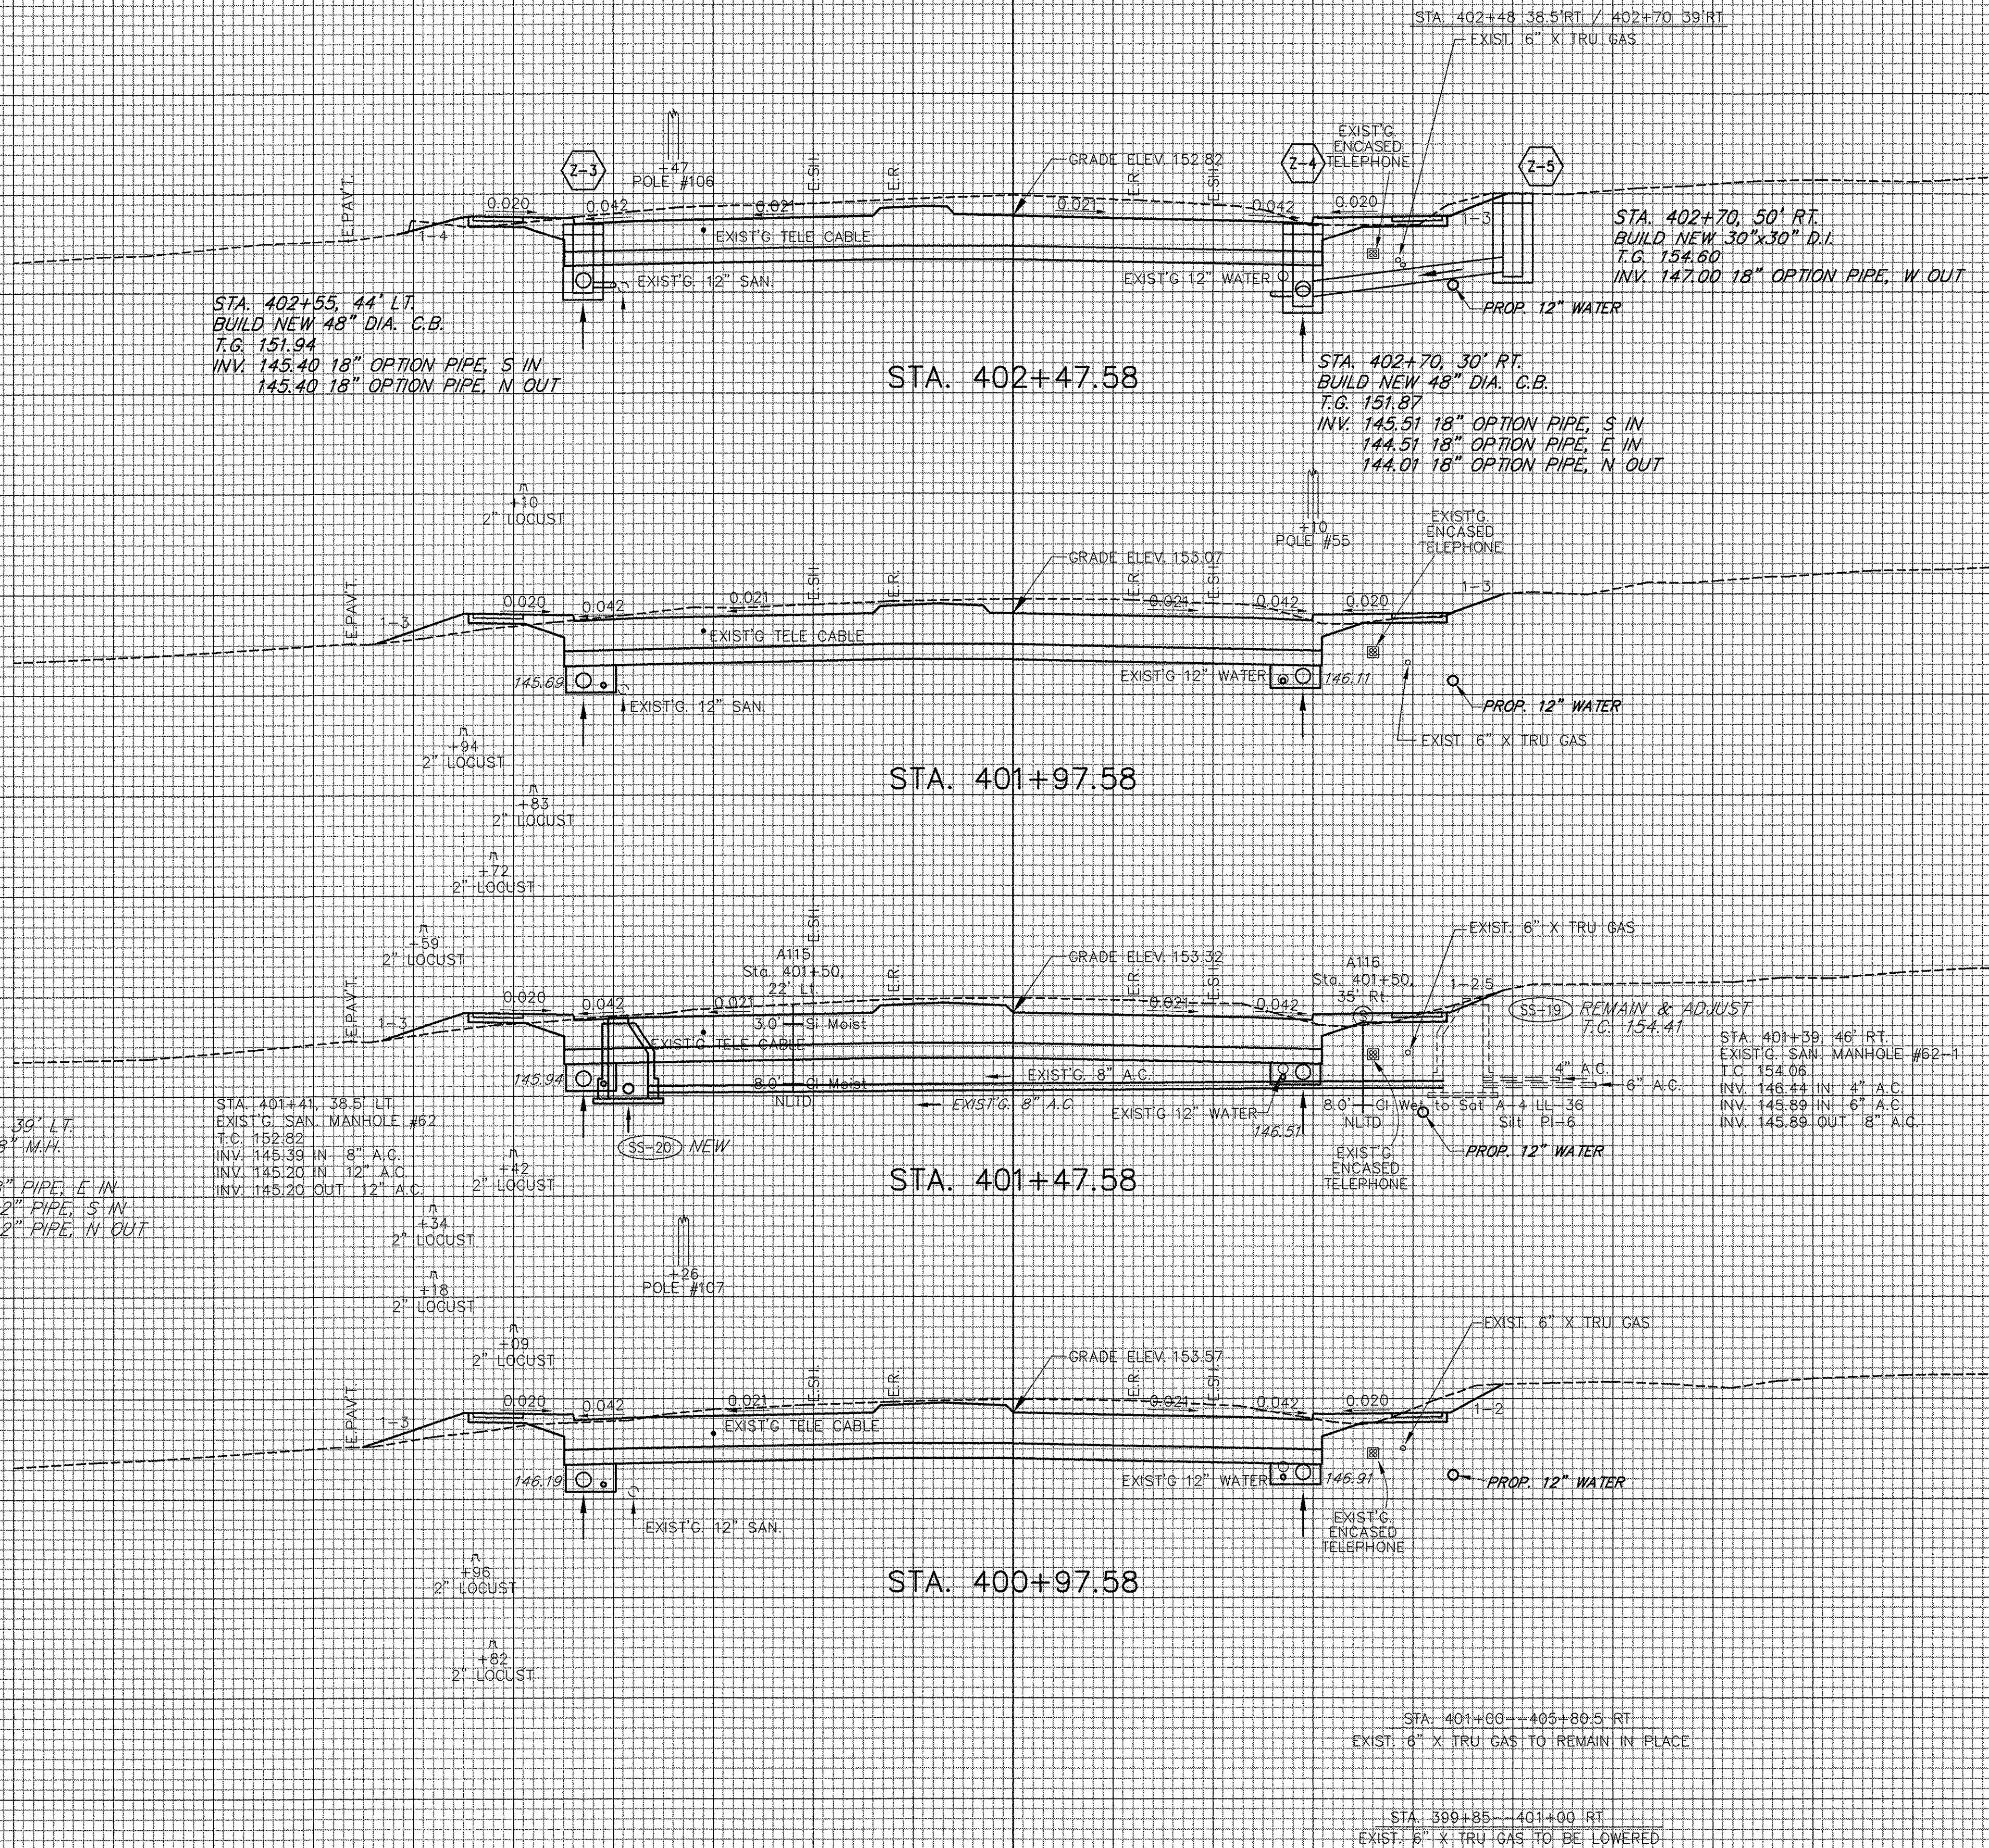

SHELburne - SOUTH BURLINGTON
 STA. 400+98 TO STA. 402+48
 SURVEYED BY V.S.C. INC. DATE _____
 DRAWN BY E.A.A. INC. DATE _____
 TRACED BY E.A.A. INC. DATE _____
 PROJECT NH-EGC-019-4(28)
 CROSS-SECTION DWG. NO. 104
 SHEET 196 OF 283