


DATUM ELEV = 145.00

DATUM ELEV = 145.00

DATUM ELEV = 145.00

DATUM ELEV = 145.00

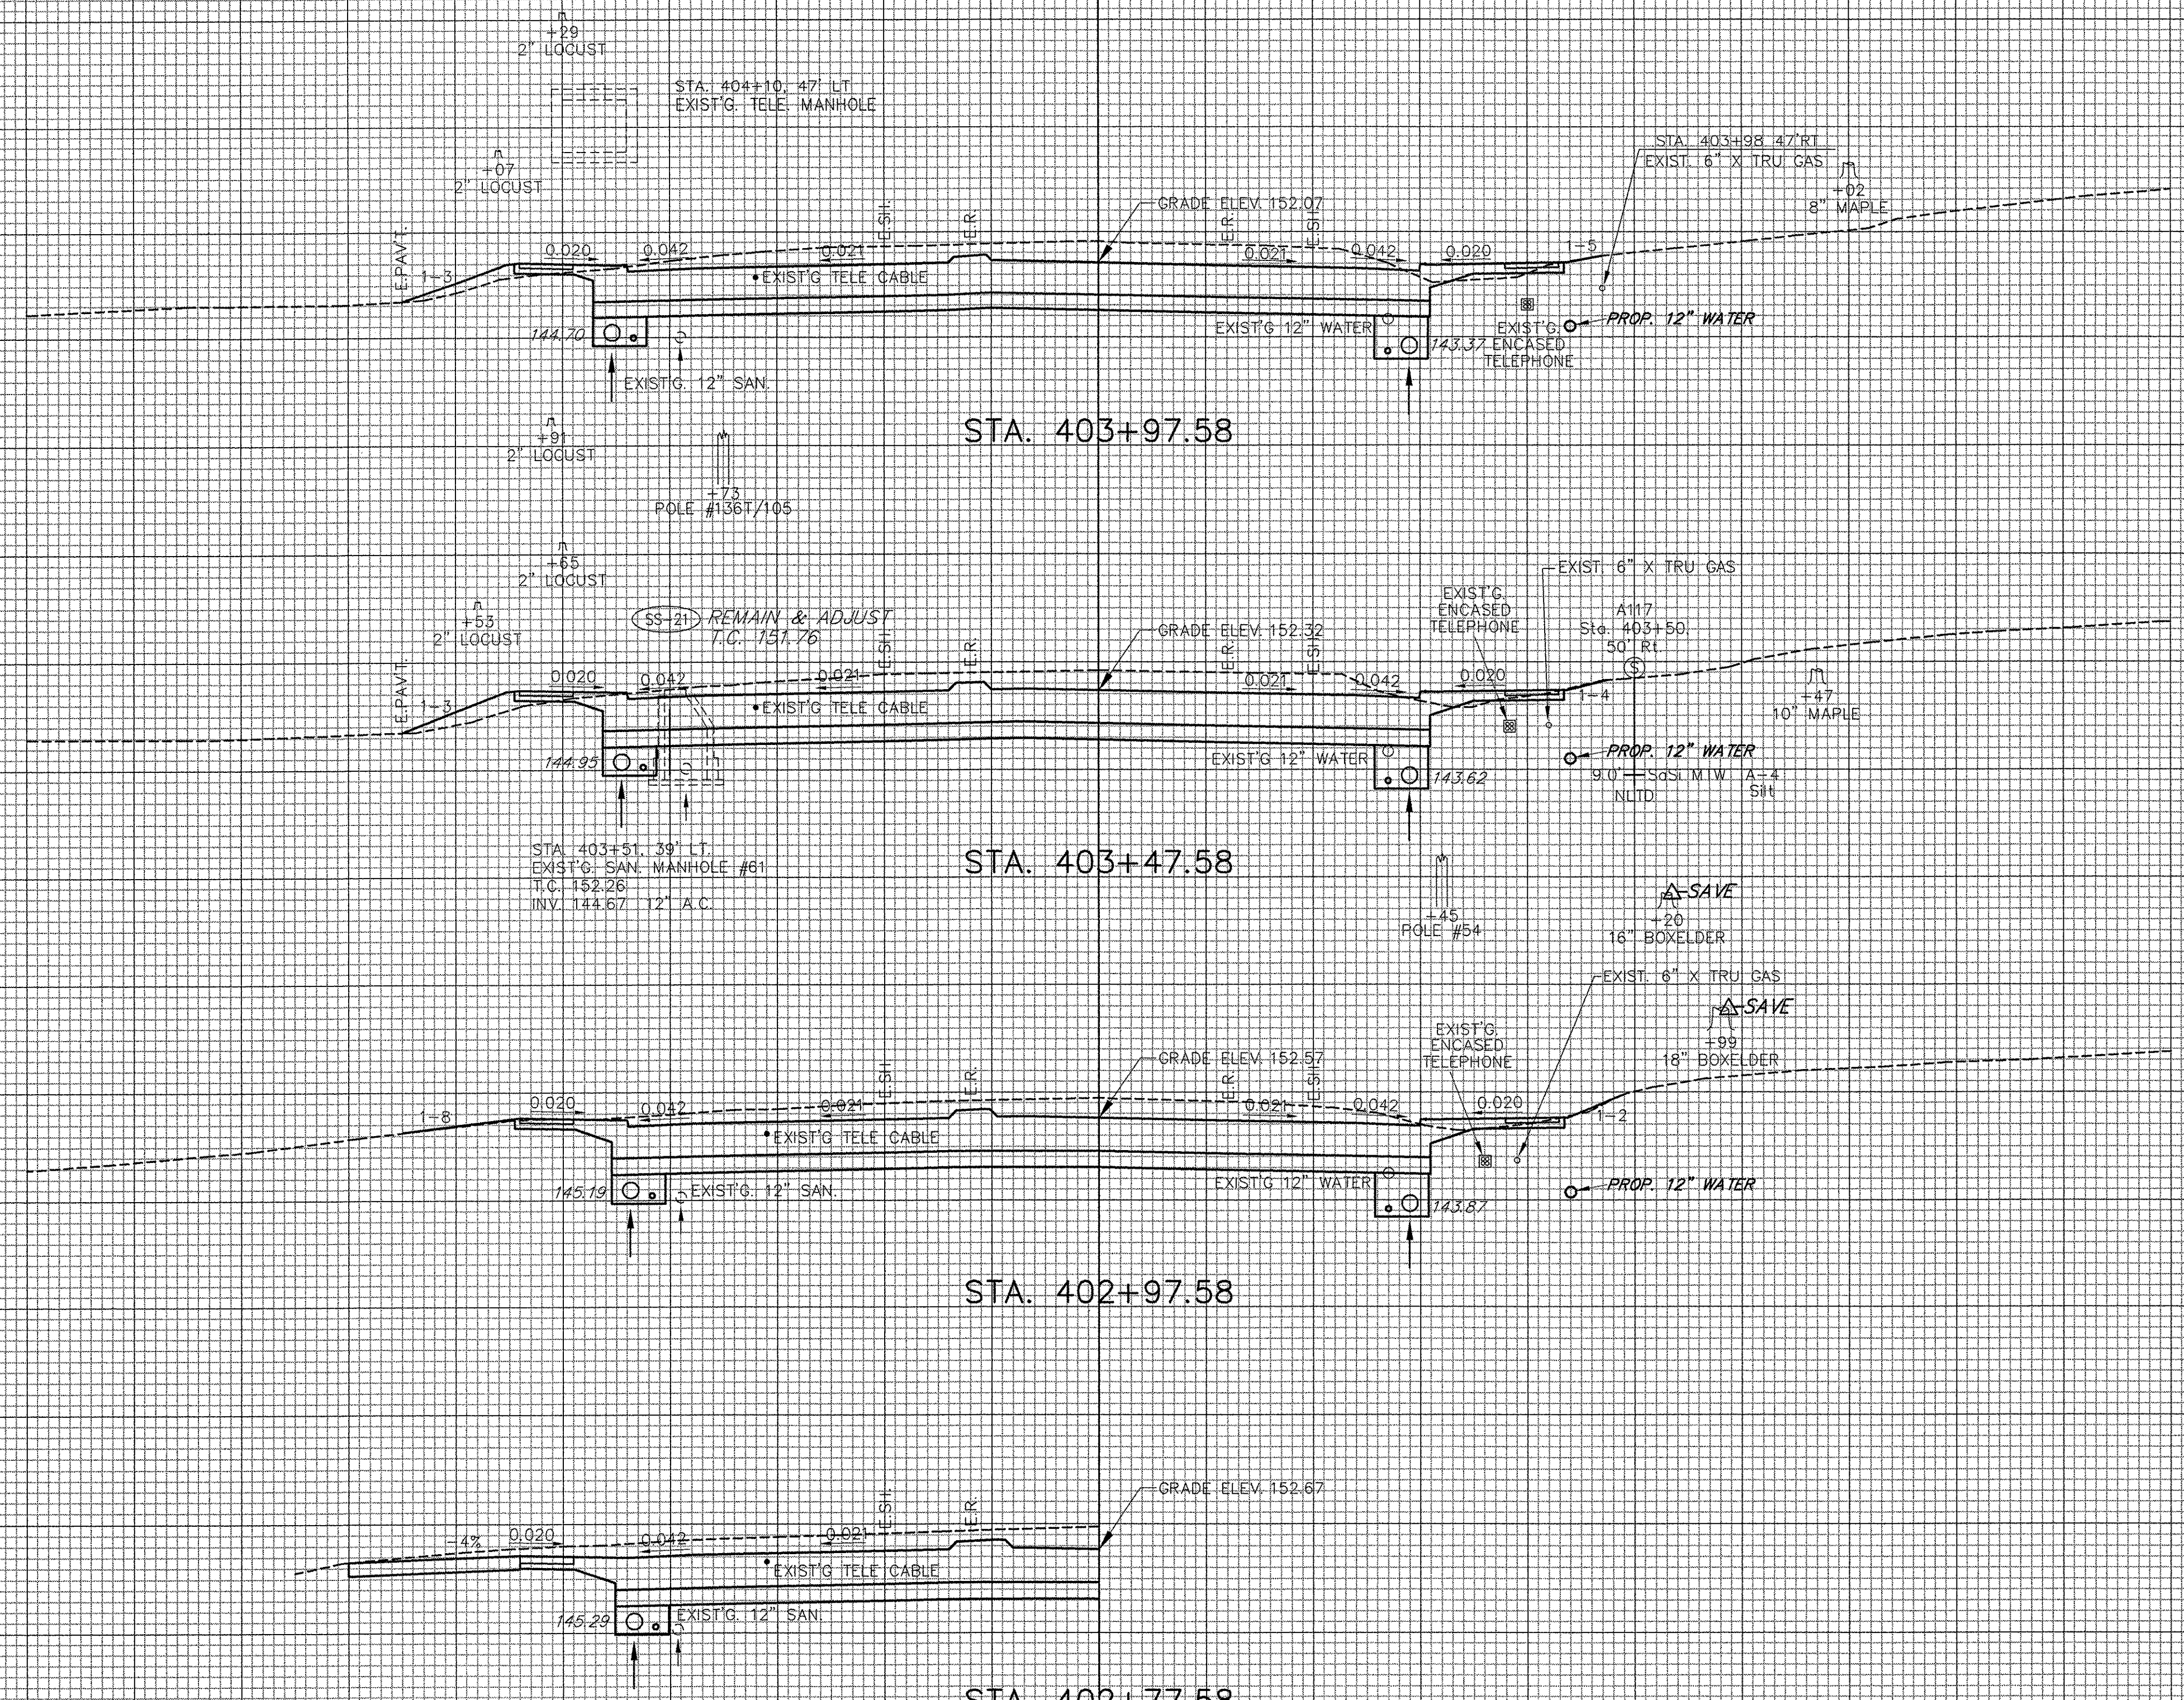


STA. 403+97.58

STA. 403+47.58

STA. 402+97.58

STA. 402+77.58

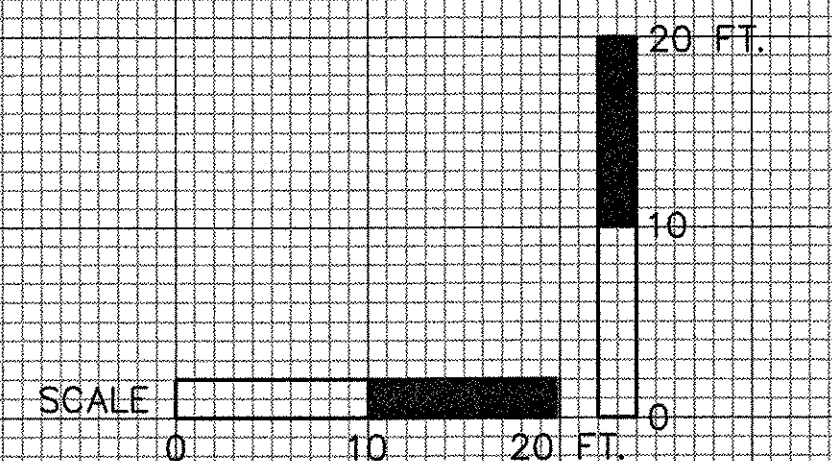

STA. 401+00 - 405+80.5 RT  
EXIST. 6" X TRU GAS TO REMAIN IN PLACE

SHELburne - SOUTH BURLINGTON

STA. 402+78 TO STA. 403+98

SURVEYED BY V.S.C. INC. DATE \_\_\_\_\_  
DRAWN BY E.A.A. INC. DATE \_\_\_\_\_  
TRACED BY E.A.A. INC. DATE \_\_\_\_\_

PROJECT NH-EGC-019-4(28)  
CROSS-SECTION DWG. NO. 105

SHEET 197 OF 283

**ERDMAN ANTHONY**  
CONSULTING ENGINEERS  
Rochester, New York    Camp Hill, Pennsylvania  
Boston, Massachusetts

130    120    110    100    90    80    70    60    50    40    30    20    10    0    10    20    30    40    50    60    70    80    90    100    110    120

4/4/03