

DATUM ELEV = 145.00

DATUM ELEV = 145.00


DATUM ELEV = 145.00

DATUM ELEV = 145.00

STA. 405+24, 48.5' LT.
BUILD NEW 48" DIA. C.B.
T.G. 150.60
INV. 144.06 18" OPTION PIPE, S IN
144.06 18" OPTION PIPE, N OUT

STA. 405+24, 30' RT.
BUILD NEW 48" DIA. C.B.
T.G. 150.60
INV. 142.73 18" OPTION PIPE, S IN
142.73 18" OPTION PIPE, N OUT

CONSTRUCT GREEN MOUNTAIN DR.
STA. 405+96.25 = 390+00.00

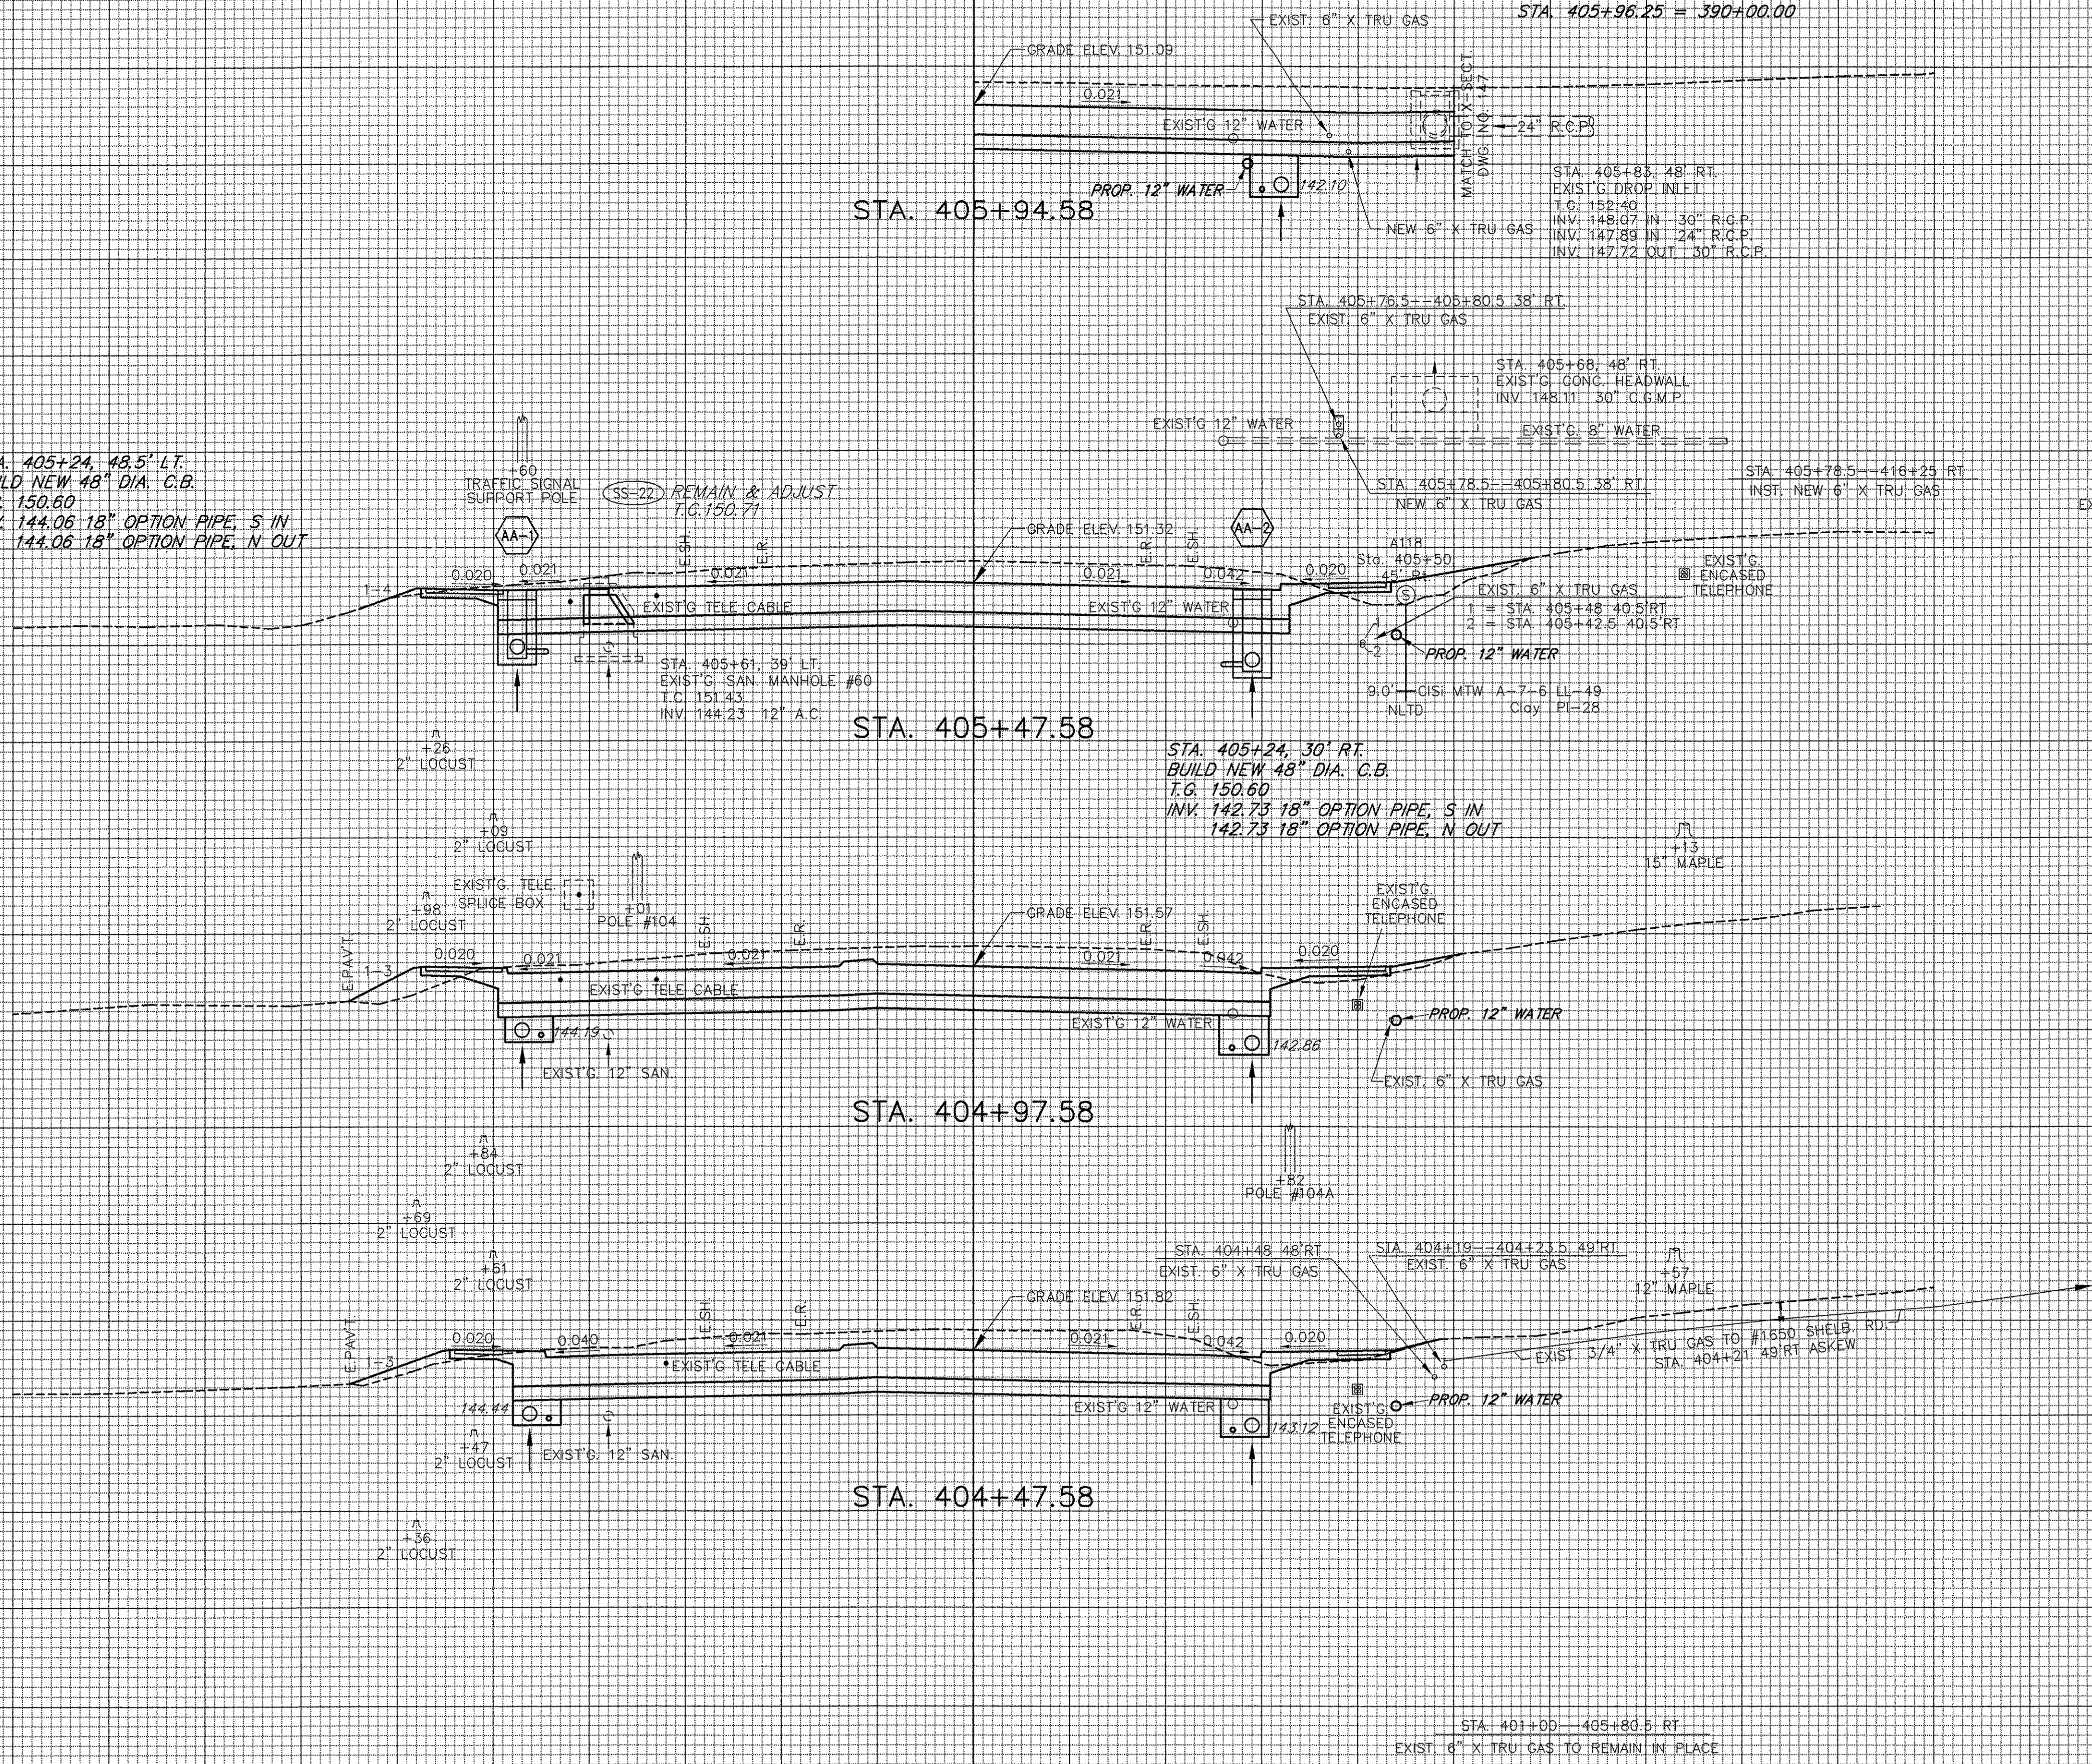

STA. 405+82.5--428+86 RT.
EXIST'G 6" X TRU GAS TO BE RETIRED IN PLACE

