


DATUM ELEV = 145.00

DATUM ELEV = 145.00

DATUM ELEV = 145.00

DATUM ELEV = 145.00

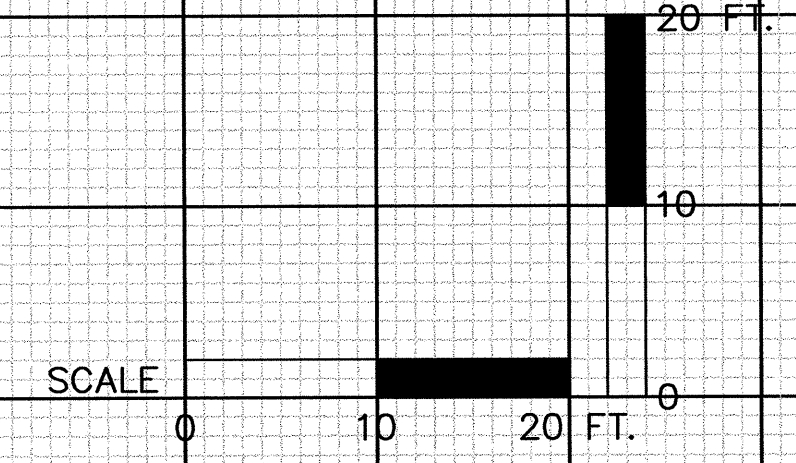

**ERDMAN ANTHONY**  
CONSULTING ENGINEERS  
Rochester, New York    Camp Hill, Pennsylvania  
Boston, Massachusetts

130    120    110    100    90    80    70    60    50    40    30    20    10    0    10    20    30    40    50    60    70    80    90    100    110    120

AS-BUILT REVISIONS  
NO. DATE DESCRIPTION  
1. 8/29/06 CHANGES MADE PER AS-BUILTS MARK UPS

REVISED SEWER DESIGN  
4/4/03

SHELburne - SOUTH BURLINGTON  
STA. 405+98 TO STA. 406+98  
SURVEYED BY V.S.C. INC. DATE \_\_\_\_\_  
DRAWN BY E.A.A. INC. DATE \_\_\_\_\_  
TRACED BY E.A.A. INC. DATE \_\_\_\_\_  
PROJECT NH-EGC-019-4(28)  
CROSS-SECTION DWG. NO. 107  
SHEET 199R OF 283