

DATUM ELEV = 145.00

DATUM ELEV = 145.00

DATUM ELEV = 145.00

DATUM ELEV = 145.00

STA. 408+45, 44' LT.  
 BUILD NEW 48" DIA. C.B.  
 T.G. 149.74  
 INV. 143.20 3218" OPTION PIPE, N IN  
 143.20 2618" OPTION PIPE, S OUT

STA. 407+99, 23.5' LT.  
 EXIST'G. DROP INLET  
 T.G. 152.44  
 INV. 147.26 IN 18" C.M.P.  
 INV. 147.25 IN 18" R.C.P.  
 INV. 147.25 OUT 18" R.C.P.

STA. 407+75, 44' LT.  
 BUILD NEW 48" DIA. C.B.  
 T.G. 149.55  
 INV. 142.83 9418" OPTION PIPE, N IN  
 142.83 9418" OPTION PIPE, S OUT

STA. 408+47.58


STA. 407+97.58

STA. 407+47.58

STA. 407+37.58

STA. 405+82.5 - 428+86 RT  
 EXIST. 6" X TRU GAS TO BE RETIRED IN PLACE

STA. 405+78.5 - 416+00 RT  
 INST. NEW 6" X TRU GAS

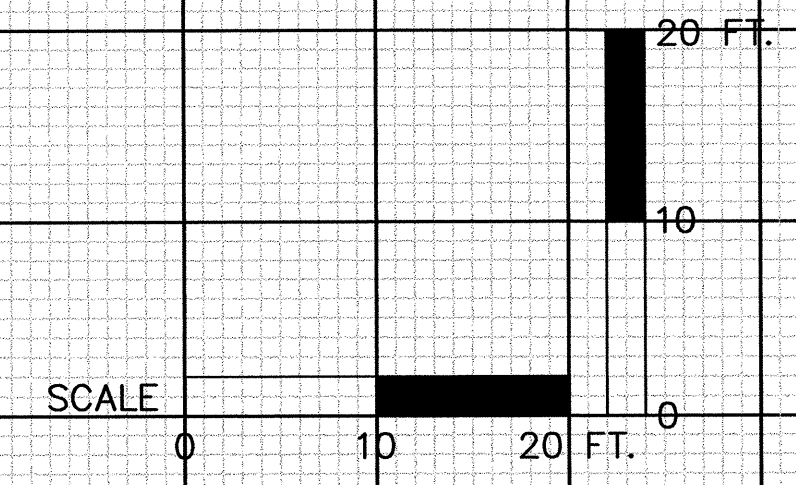

SHELBURNE - SOUTH BURLINGTON  
 STA. 407+38 TO STA. 408+48  
 SURVEYED BY V.S.C. INC. DATE \_\_\_\_\_  
 DRAWN BY E.A.A. INC. DATE \_\_\_\_\_  
 TRACED BY E.A.A. INC. DATE \_\_\_\_\_  
 PROJECT NH-EGC-019-4(28)  
 CROSS-SECTION DWG. NO. 108  
 SHEET 200R OF 283

**ERDMAN ANTHONY**  
 CONSULTING ENGINEERS  
 Rochester, New York Camp Hill, Pennsylvania  
 Boston, Massachusetts

AS-BUILT REVISIONS  
 NO. DATE DESCRIPTION  
 1. 8/29/06 CHANGES MADE PER AS-BUILTS MARK UPS  
 REVISED SEWER DESIGN  
 4/4/03