

DATUM ELEV = 145.00

DATUM ELEV = 145.00

DATUM ELEV = 145.00


DATUM ELEV = 145.00

STA. 409+54.58

STA. 409+47.58

STA. 408+97.58

STA. 408+77.58

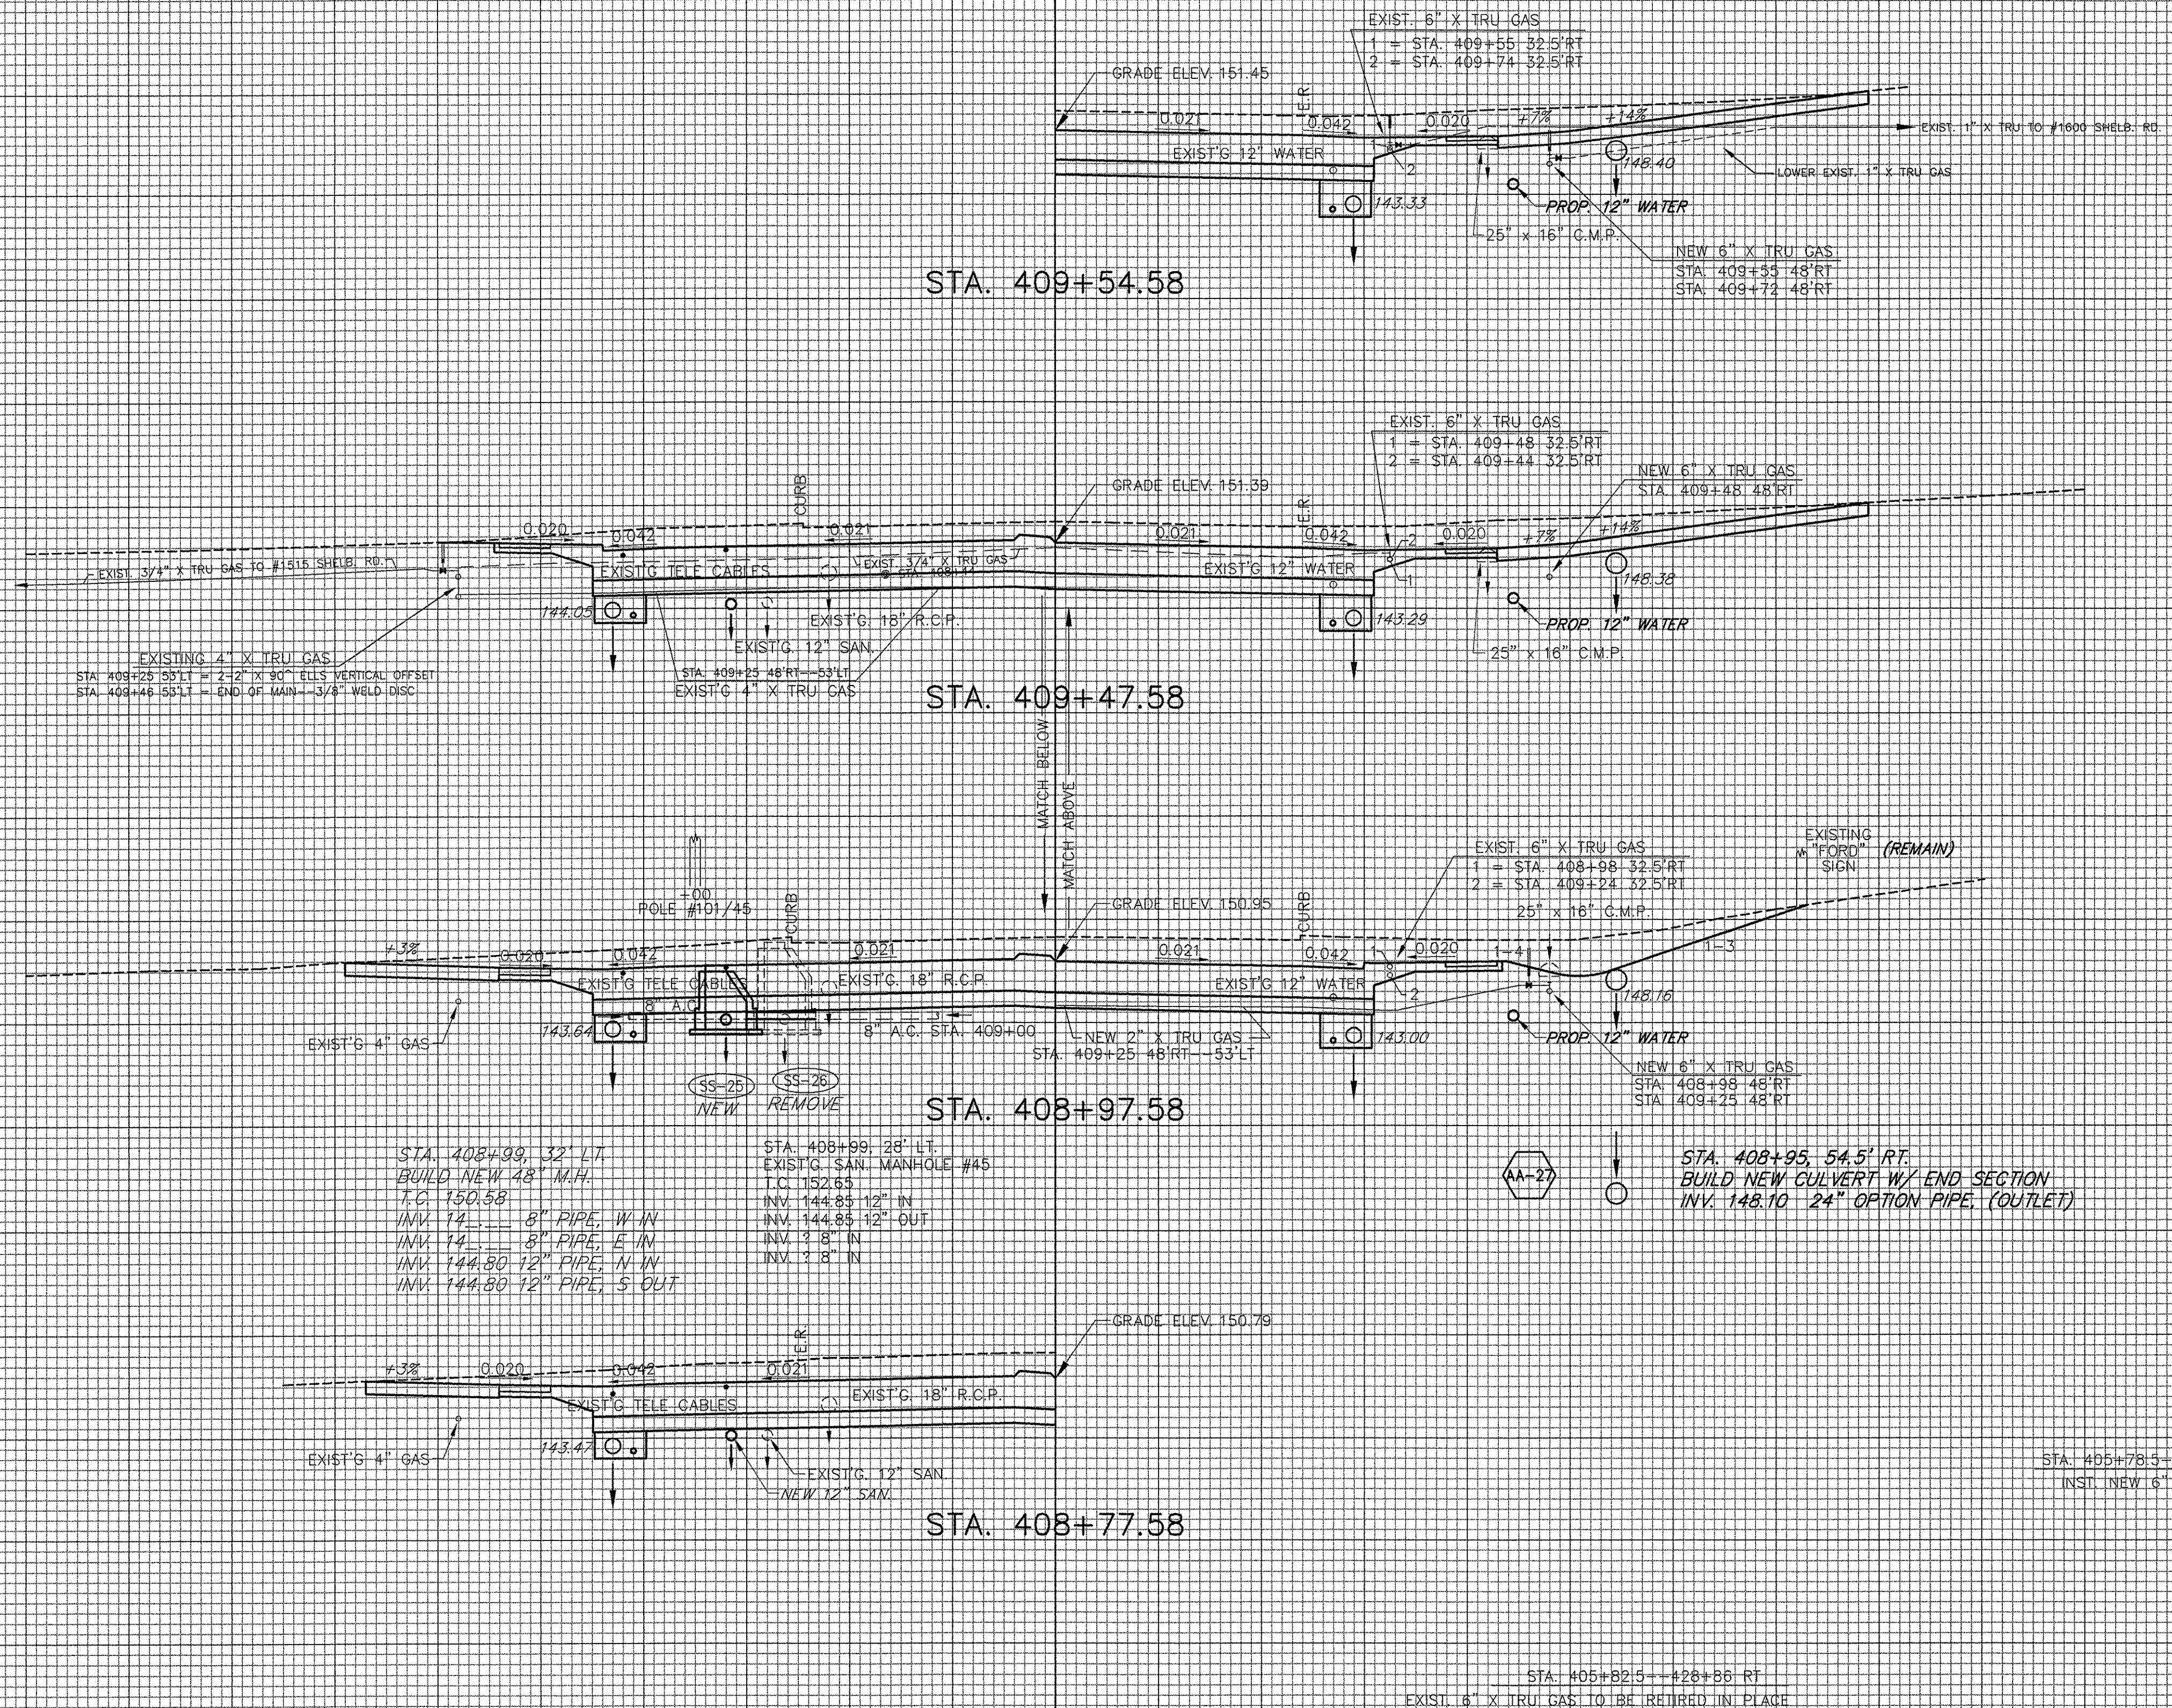

STA. 408+99.32 LT.
 BUILD NEW 48" M.H.
 T.C. 150.58
 INV. 14.88 8" PIPE, W-IN
 INV. 14.88 8" PIPE, E-IN
 INV. 144.80 12" PIPE, N-IN
 INV. 144.80 12" PIPE, S-OUT

STA. 408+99.28 LT.
 EXIST'G SAN. MANHOLE #45
 T.C. 152.63
 INV. 144.85 12" IN
 INV. 144.85 12" OUT
 INV. 9.8" IN
 INV. 9.8" IN

STA. 408+95.54 RT.
 BUILD NEW CULVERT W/ END SECTION
 INV. 148.10 24" OPTION PIPE, (OUTLET)

