

DATUM ELEV = 145.00

DATUM ELEV = 145.00

DATUM ELEV = 145.00

DATUM ELEV = 145.00

STA. 409+54.58

STA. 409+47.58

STA. 408+97.58

STA. 408+77.58

EXISTING 4" X TRU GAS  
STA. 409+29 53'LT = 2'-2" X 90" ELLS VERTICAL OFFSET  
STA. 409+46 53'LT = END OF MAIN--3/4" WELD DISC

3 33  
STA. 408+99 32' LT.  
BUILD NEW 48" M.H.  
T.C. 150.58  
INV. 144.95 8" PIPE, W IN  
INV. 144.95 8" PIPE, E IN  
INV. 144.80 12" PIPE, M IN  
INV. 144.80 12" PIPE, S OUT

STA. 408+99, 28' LT.  
EXIST'G. SAN. MANHOLE #45  
T.C. 152.83  
INV. 144.83 12" IN  
INV. 144.83 12" OUT  
INV. ? 8" IN  
INV. ? 8" IN


STA. 408+95, 54.5' RT.  
BUILD NEW CULVERT W/ END SECTION  
INV. 149.10 24" OPTION PIPE, (OUTLET)  
148.51

**ERDMAN ANTHONY**  
CONSULTING ENGINEERS  
Rochester, New York    Camp Hill, Pennsylvania  
Boston, Massachusetts

130    120    110    100    90    80    70    60    50    40    30    20    10    0    10    20    30    40    50    60    70    80    90    100    110    120

AS-BUILT REVISIONS		REVISED SEWER DESIGN
NO.	DATE	DESCRIPTION
1.	8/29/06	CHANGES MADE PER AS-BUILTS MARK UPS

4/4/03

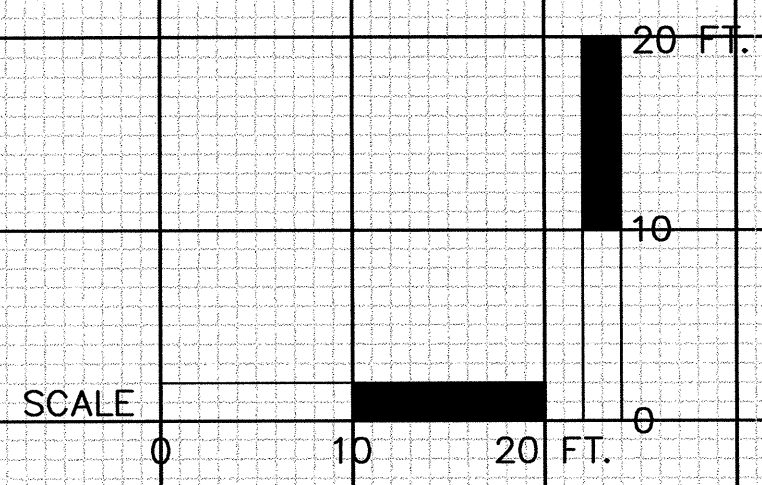

SHELburnE - SOUTH BURLINGTON  
 STA. 408+78 TO STA. 409+55  
 SURVEYED BY V.S.C. INC. DATE \_\_\_\_\_  
 DRAWN BY E.A.A. INC. DATE \_\_\_\_\_  
 TRACED BY E.A.A. INC. DATE \_\_\_\_\_  
 PROJECT NH-EGC-019-4(28)  
 CROSS-SECTION DWG. NO. 109  
 SHEET 201R OF 283