
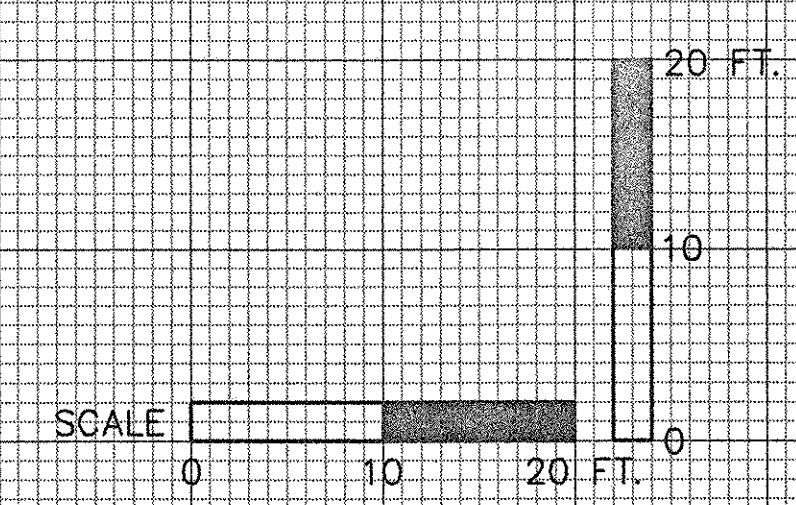


DATUM ELEV = 150.00

DATUM ELEV = 150.00

DATUM ELEV = 150.00

DATUM ELEV = 150.00

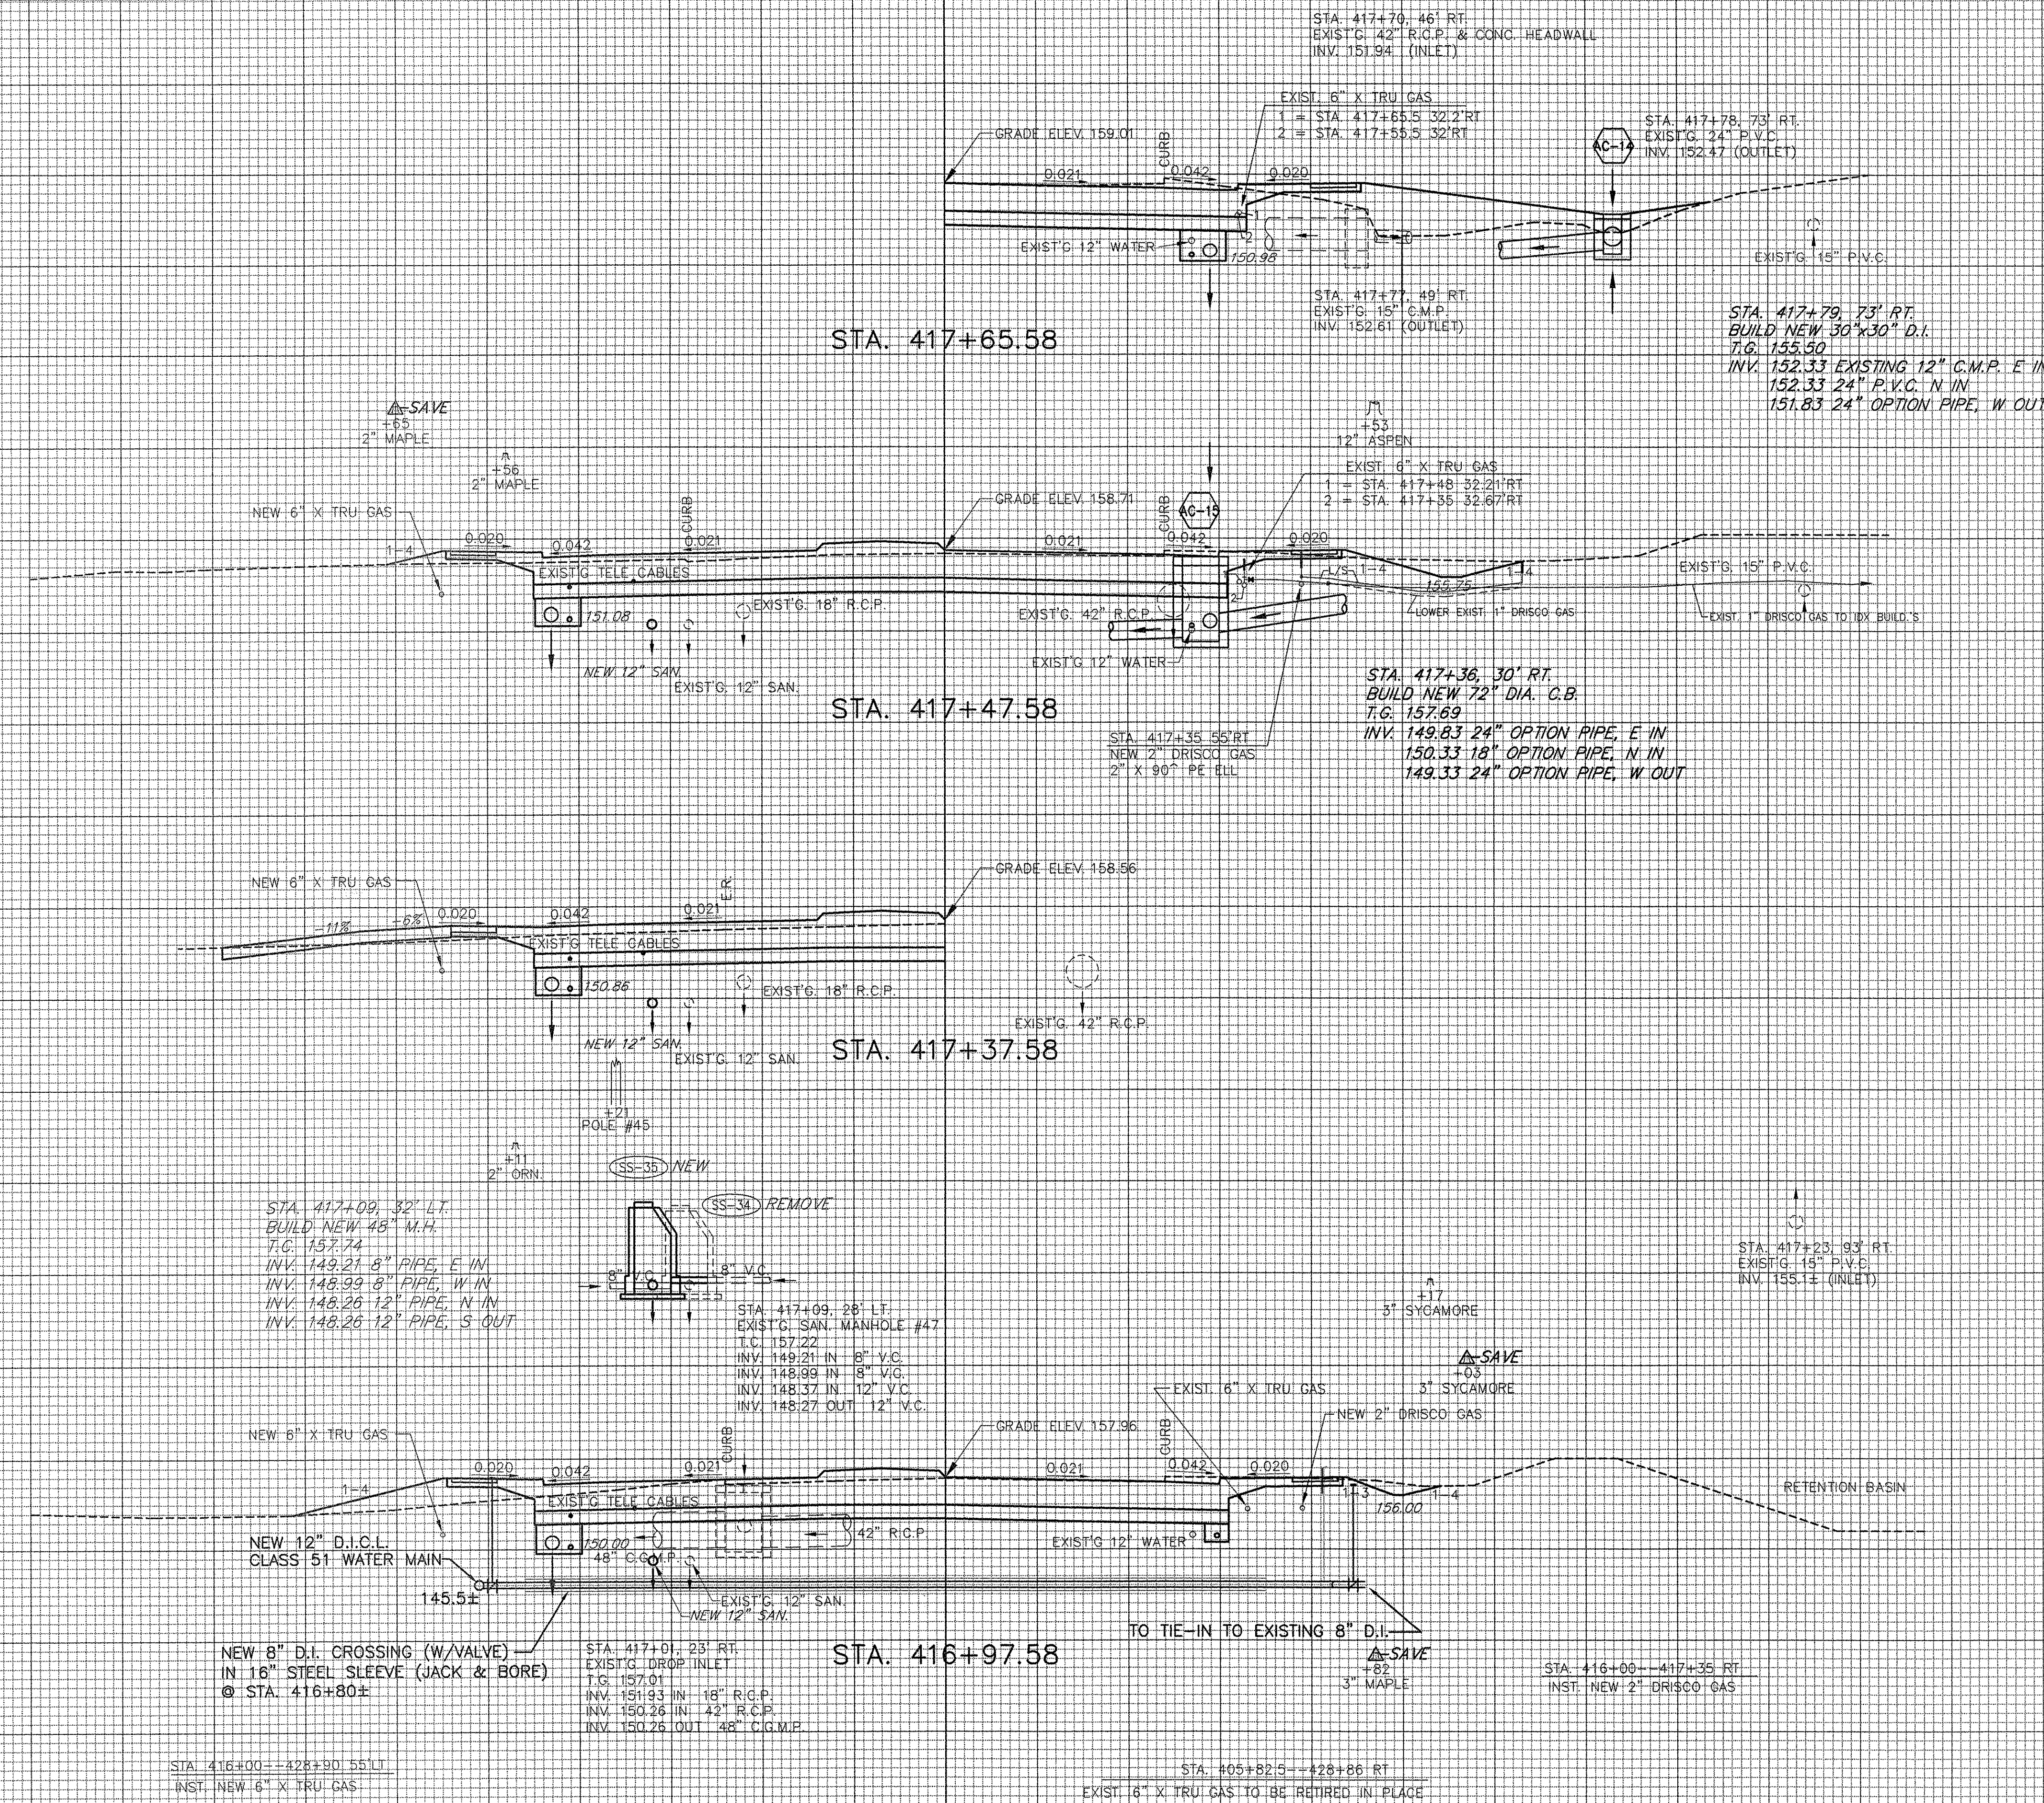

SHELBURNE - SOUTH BURLINGTON

STA. 416+98 TO STA. 417+66

SURVEYED BY V.S.C. INC. DATE _____

DRAWN BY E.A.A. INC. DATE _____

TRACED BY E.A.A. INC. DATE _____

PROJECT NH-EGC-019-4(28)

CROSS-SECTION DWG. NO. 115

SHEET 207 OF 283