


DATUM ELEV = 160.00

DATUM ELEV = 160.00

DATUM ELEV = 155.00

DATUM ELEV = 155.00

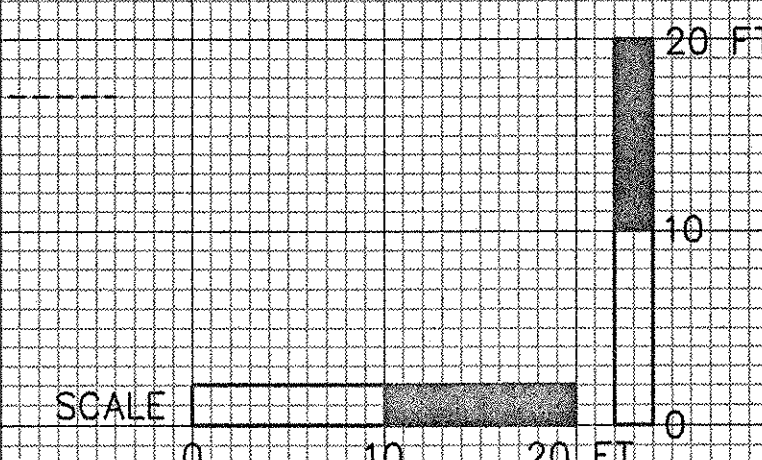

ERDMAN ANTHONY
CONSULTING ENGINEERS
Rochester, New York Camp Hill, Pennsylvania
Boston, Massachusetts

130 120 110 100 90 80 70 60 50 40 30 20 10 0 10 20 30 40 50 60 70 80 90 100 110 120

4/4/03

SHELBURNE - SOUTH BURLINGTON
STA. 419+48 TO STA. 420+88
SURVEYED BY V.S.C. INC. DATE _____
DRAWN BY E.A.A. INC. DATE _____
TRACED BY E.A.A. INC. DATE _____
PROJECT NH-EGC-019-4(28)
CROSS-SECTION DWG. NO. 117
SHEET 209 OF 283