
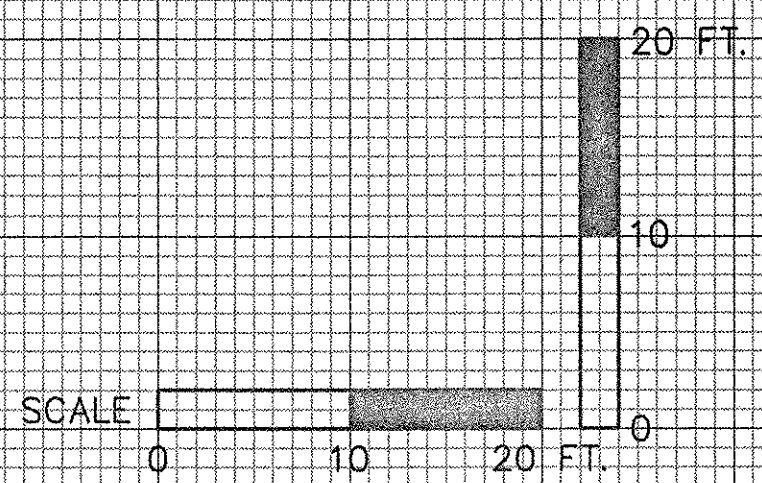


DATUM ELEV = 170.00

DATUM ELEV = 170.00

DATUM ELEV = 170.00

DATUM ELEV = 170.00

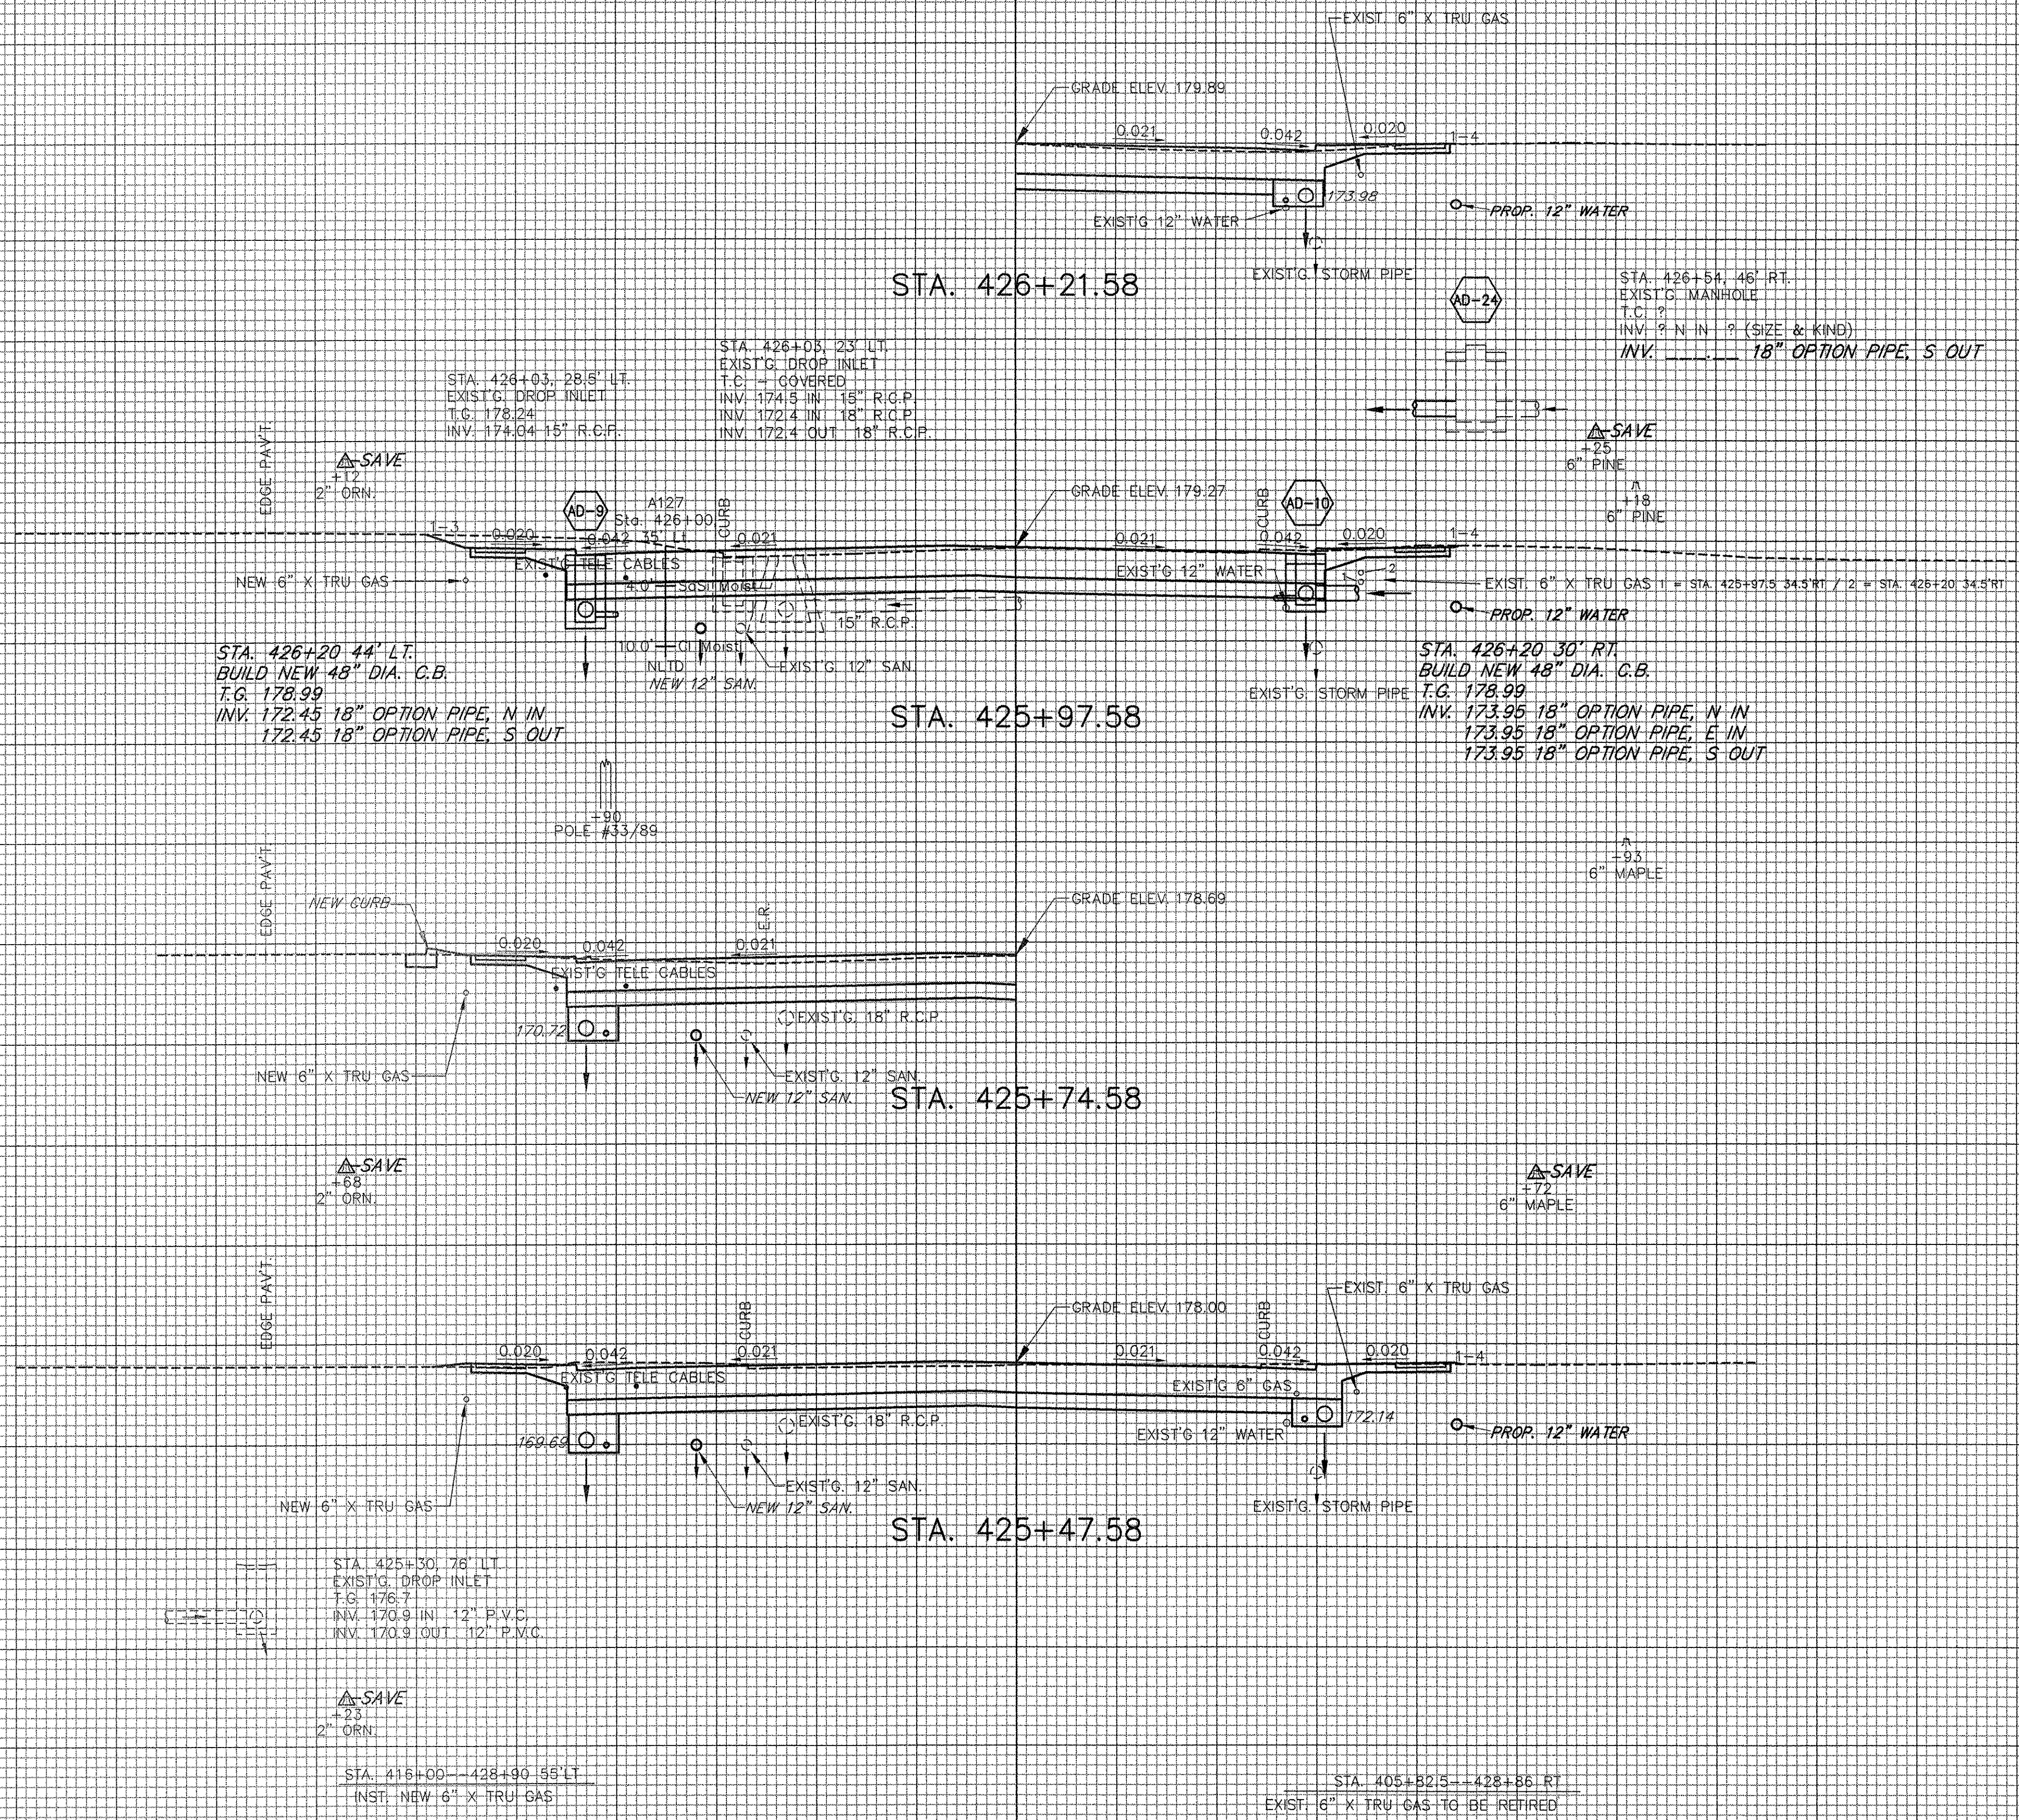

SHELburnE - SOUTH BURLINGTON

STA. 425+48 TO STA. 426+22

SURVEYED BY V.S.C. INC. DATE _____
 DRAWN BY E.A.A. INC. DATE _____
 TRACED BY E.A.A. INC. DATE _____

PROJECT NH-EGC-019-4(28)

CROSS-SECTION DWG. NO. 121

SHEET 213 OF 283