


DATUM ELEV = 160.00

DATUM ELEV = 160.00

DATUM ELEV = 165.00

DATUM ELEV = 165.00

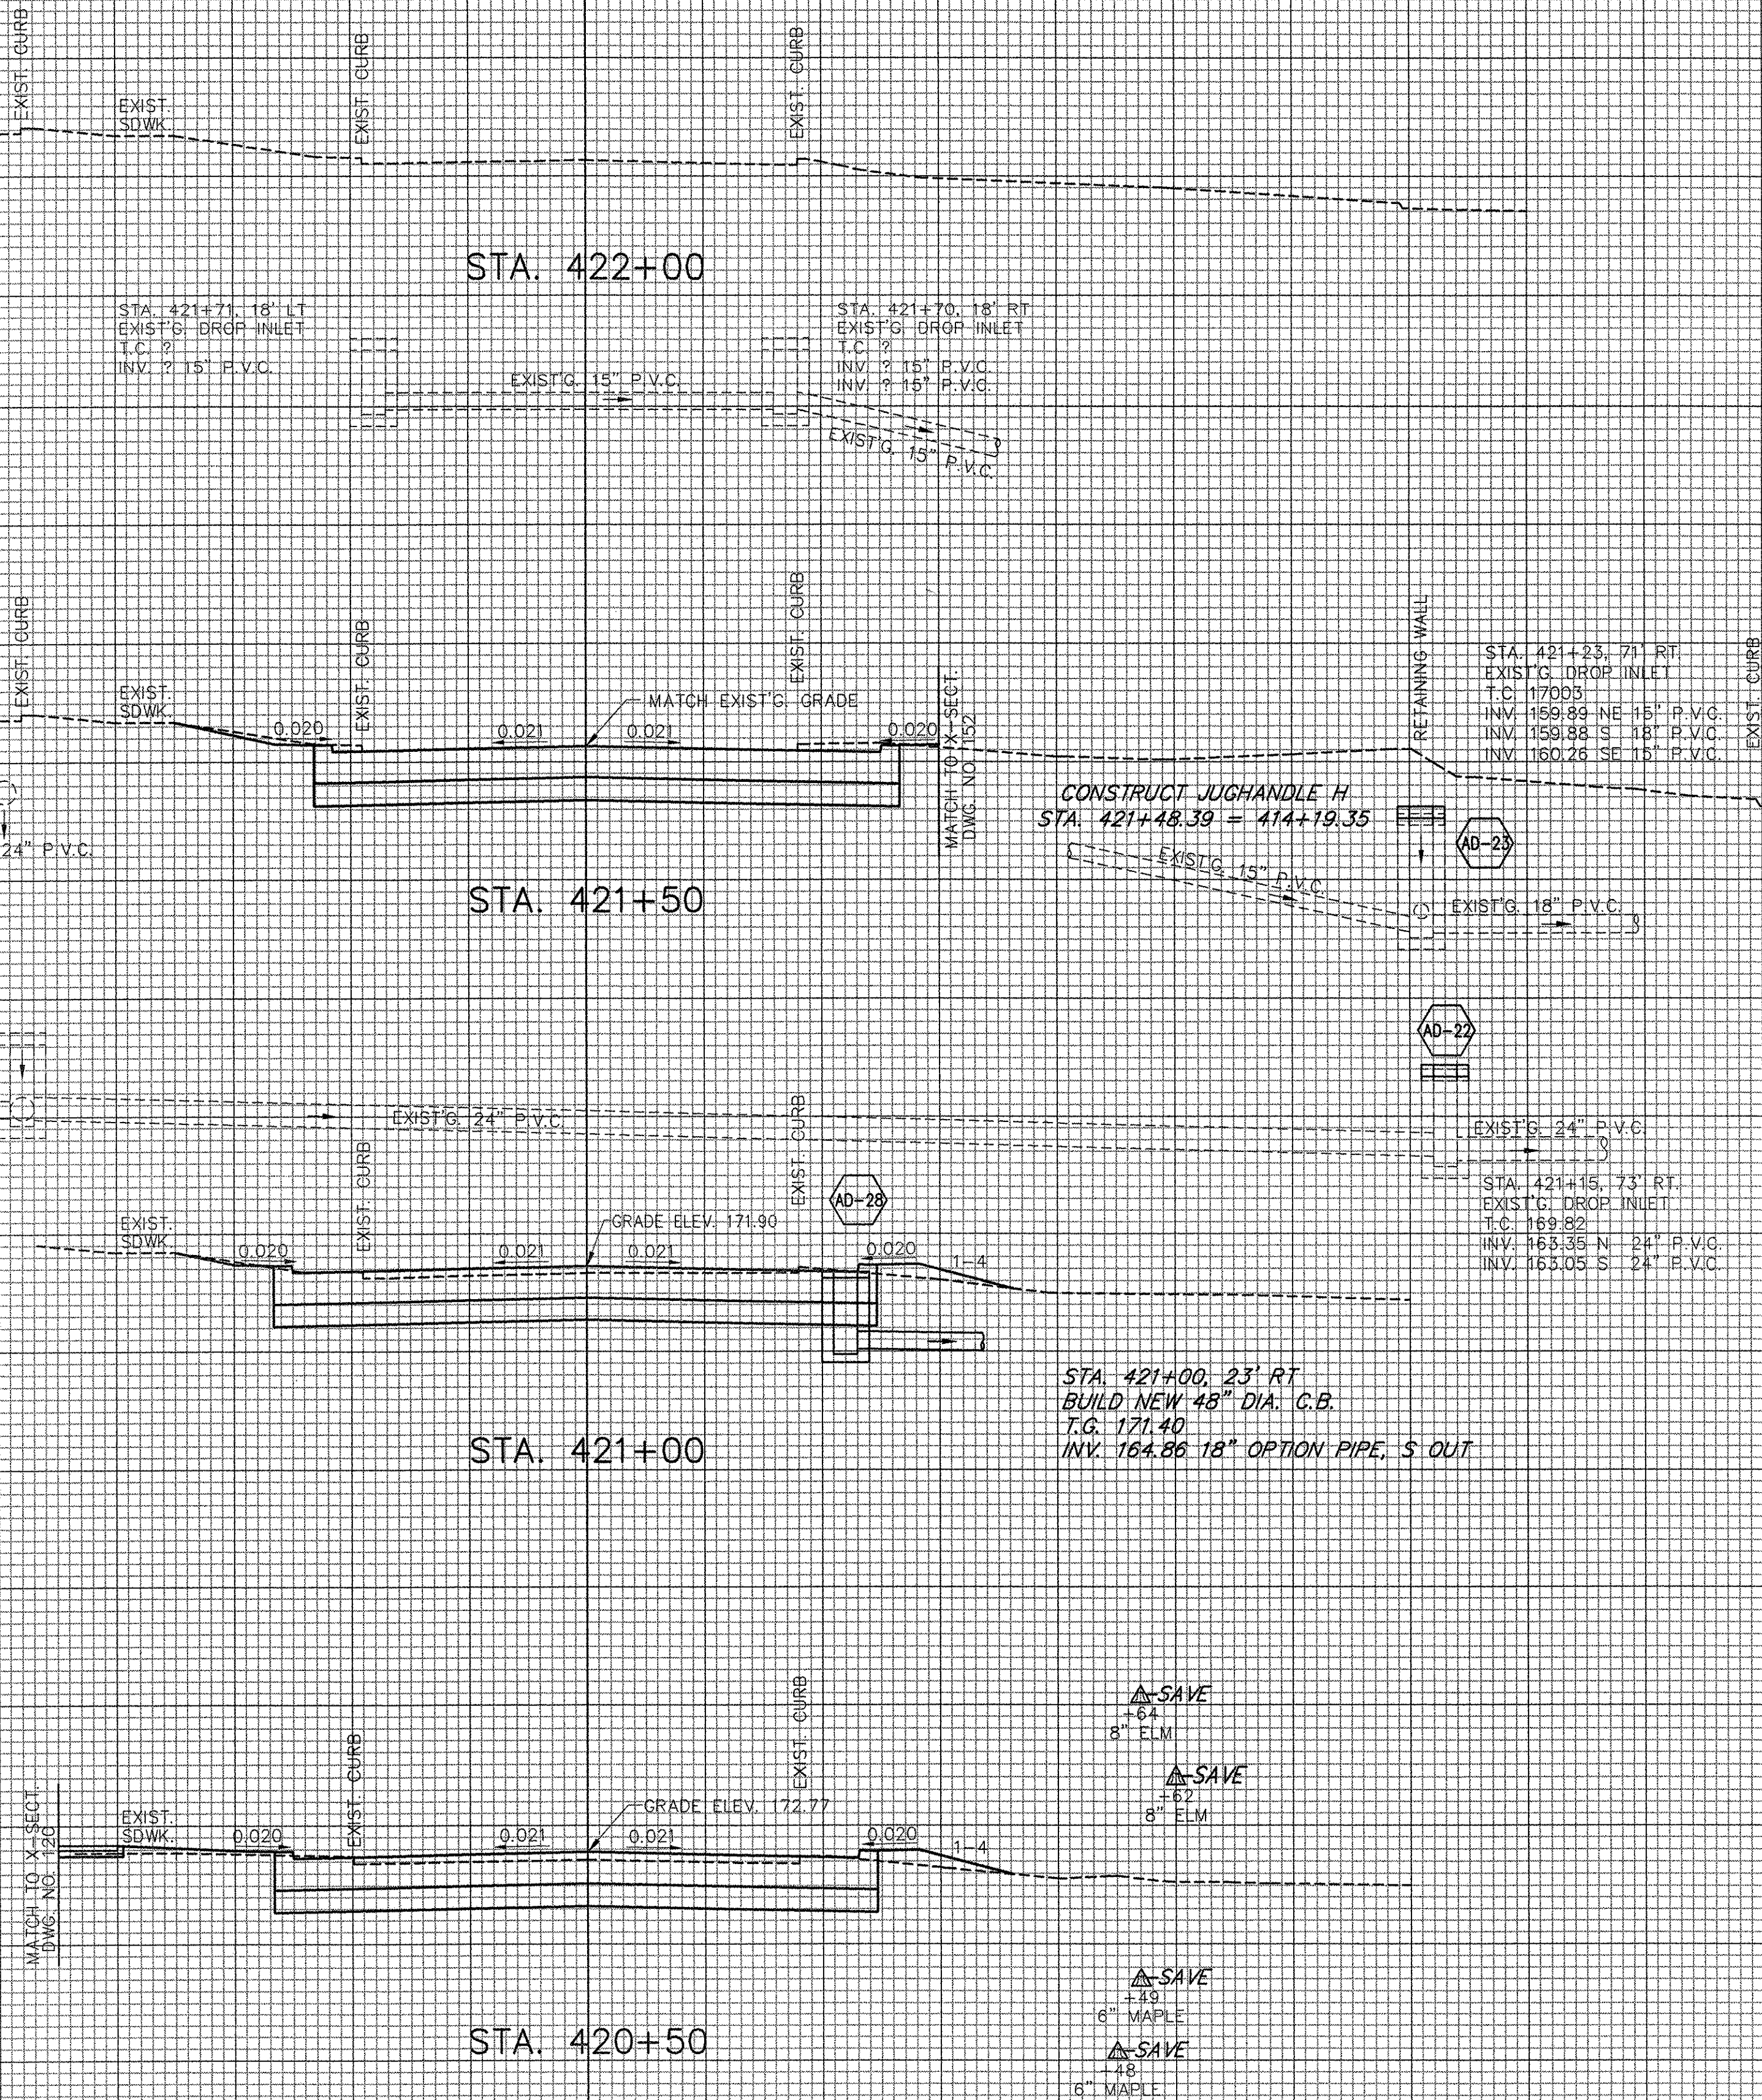

SEE MAINLINE SECTIONS
STA. 424+47.58

CONSTRUCT JUGHANDLE H
STA. 421+48.39 = 414+19.35


STA. 421+00, 23' RT
BUILD NEW 48" DIA. C.B.
T.G. 171.40
INV. 164.86 18" OPTION PIPE, S OUT

SAVE
+64
8" ELM

SAVE
+82
8" ELM

SAVE
+83
6" MAPLE

SAVE
+48
6" MAPLE

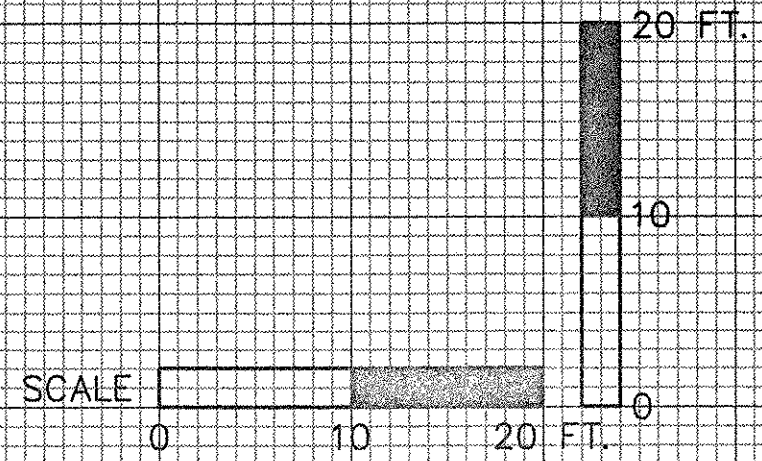

IDX DRIVE

SHELburnE - SOUTH BURLINGTON

STA. 420+50 TO STA. 421+50

SURVEYED BY	V.S.C. INC.	DATE	
DRAWN BY	E.A.A. INC.	DATE	
TRACED BY	E.A.A. INC.	DATE	

PROJECT NH-EGC-019-4(28)
 CROSS-SECTION DWG. NO. 150
 SHEET 222 OF 283