



U.S. ROUTE 7 SHELBURNE ROAD

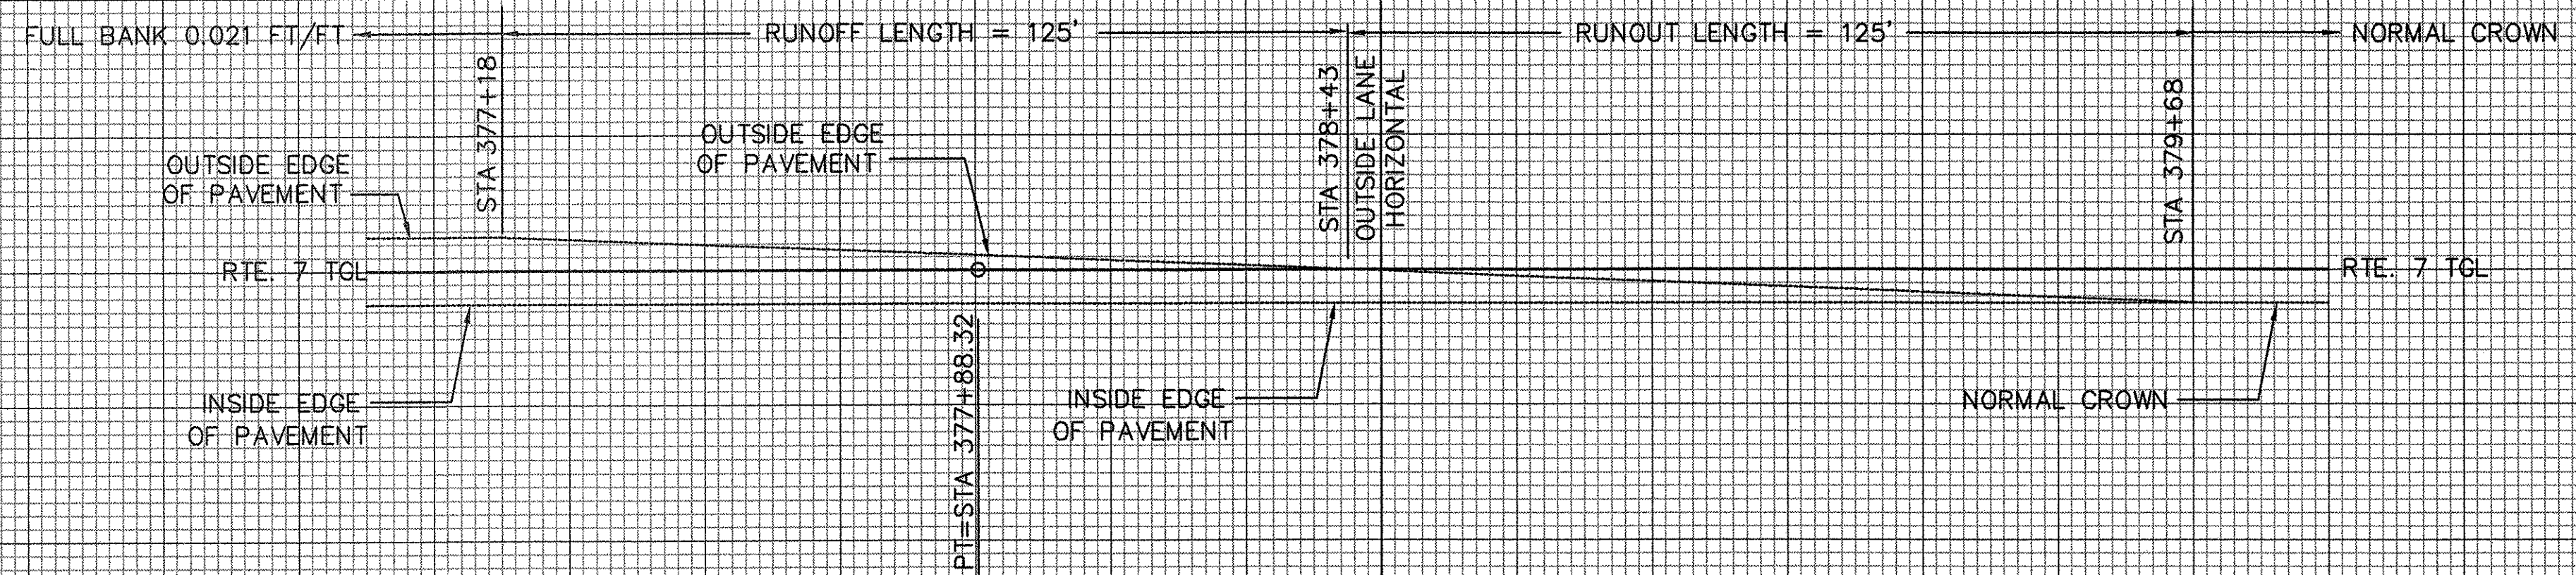

U.S. ROUTE 7 SHELBURNE ROAD

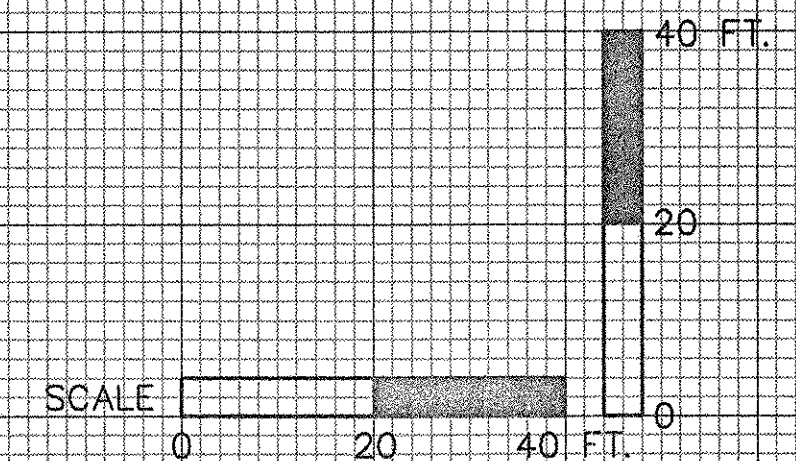

SHELBURNE - SOUTH BURLINGTON  
 STA. 370+17 TO STA. 379+68  
 SURVEYED BY V.S.C. INC. DATE \_\_\_\_\_  
 DRAWN BY E.A.A. INC. DATE \_\_\_\_\_  
 TRACED BY E.A.A. INC. DATE \_\_\_\_\_  
 PROJECT NH-EGC-019-4(28)  
 BANKING DWG. NO. 1  
 SHEET 233 OF 283