


BOUYEA LANE

MITSUBISHI

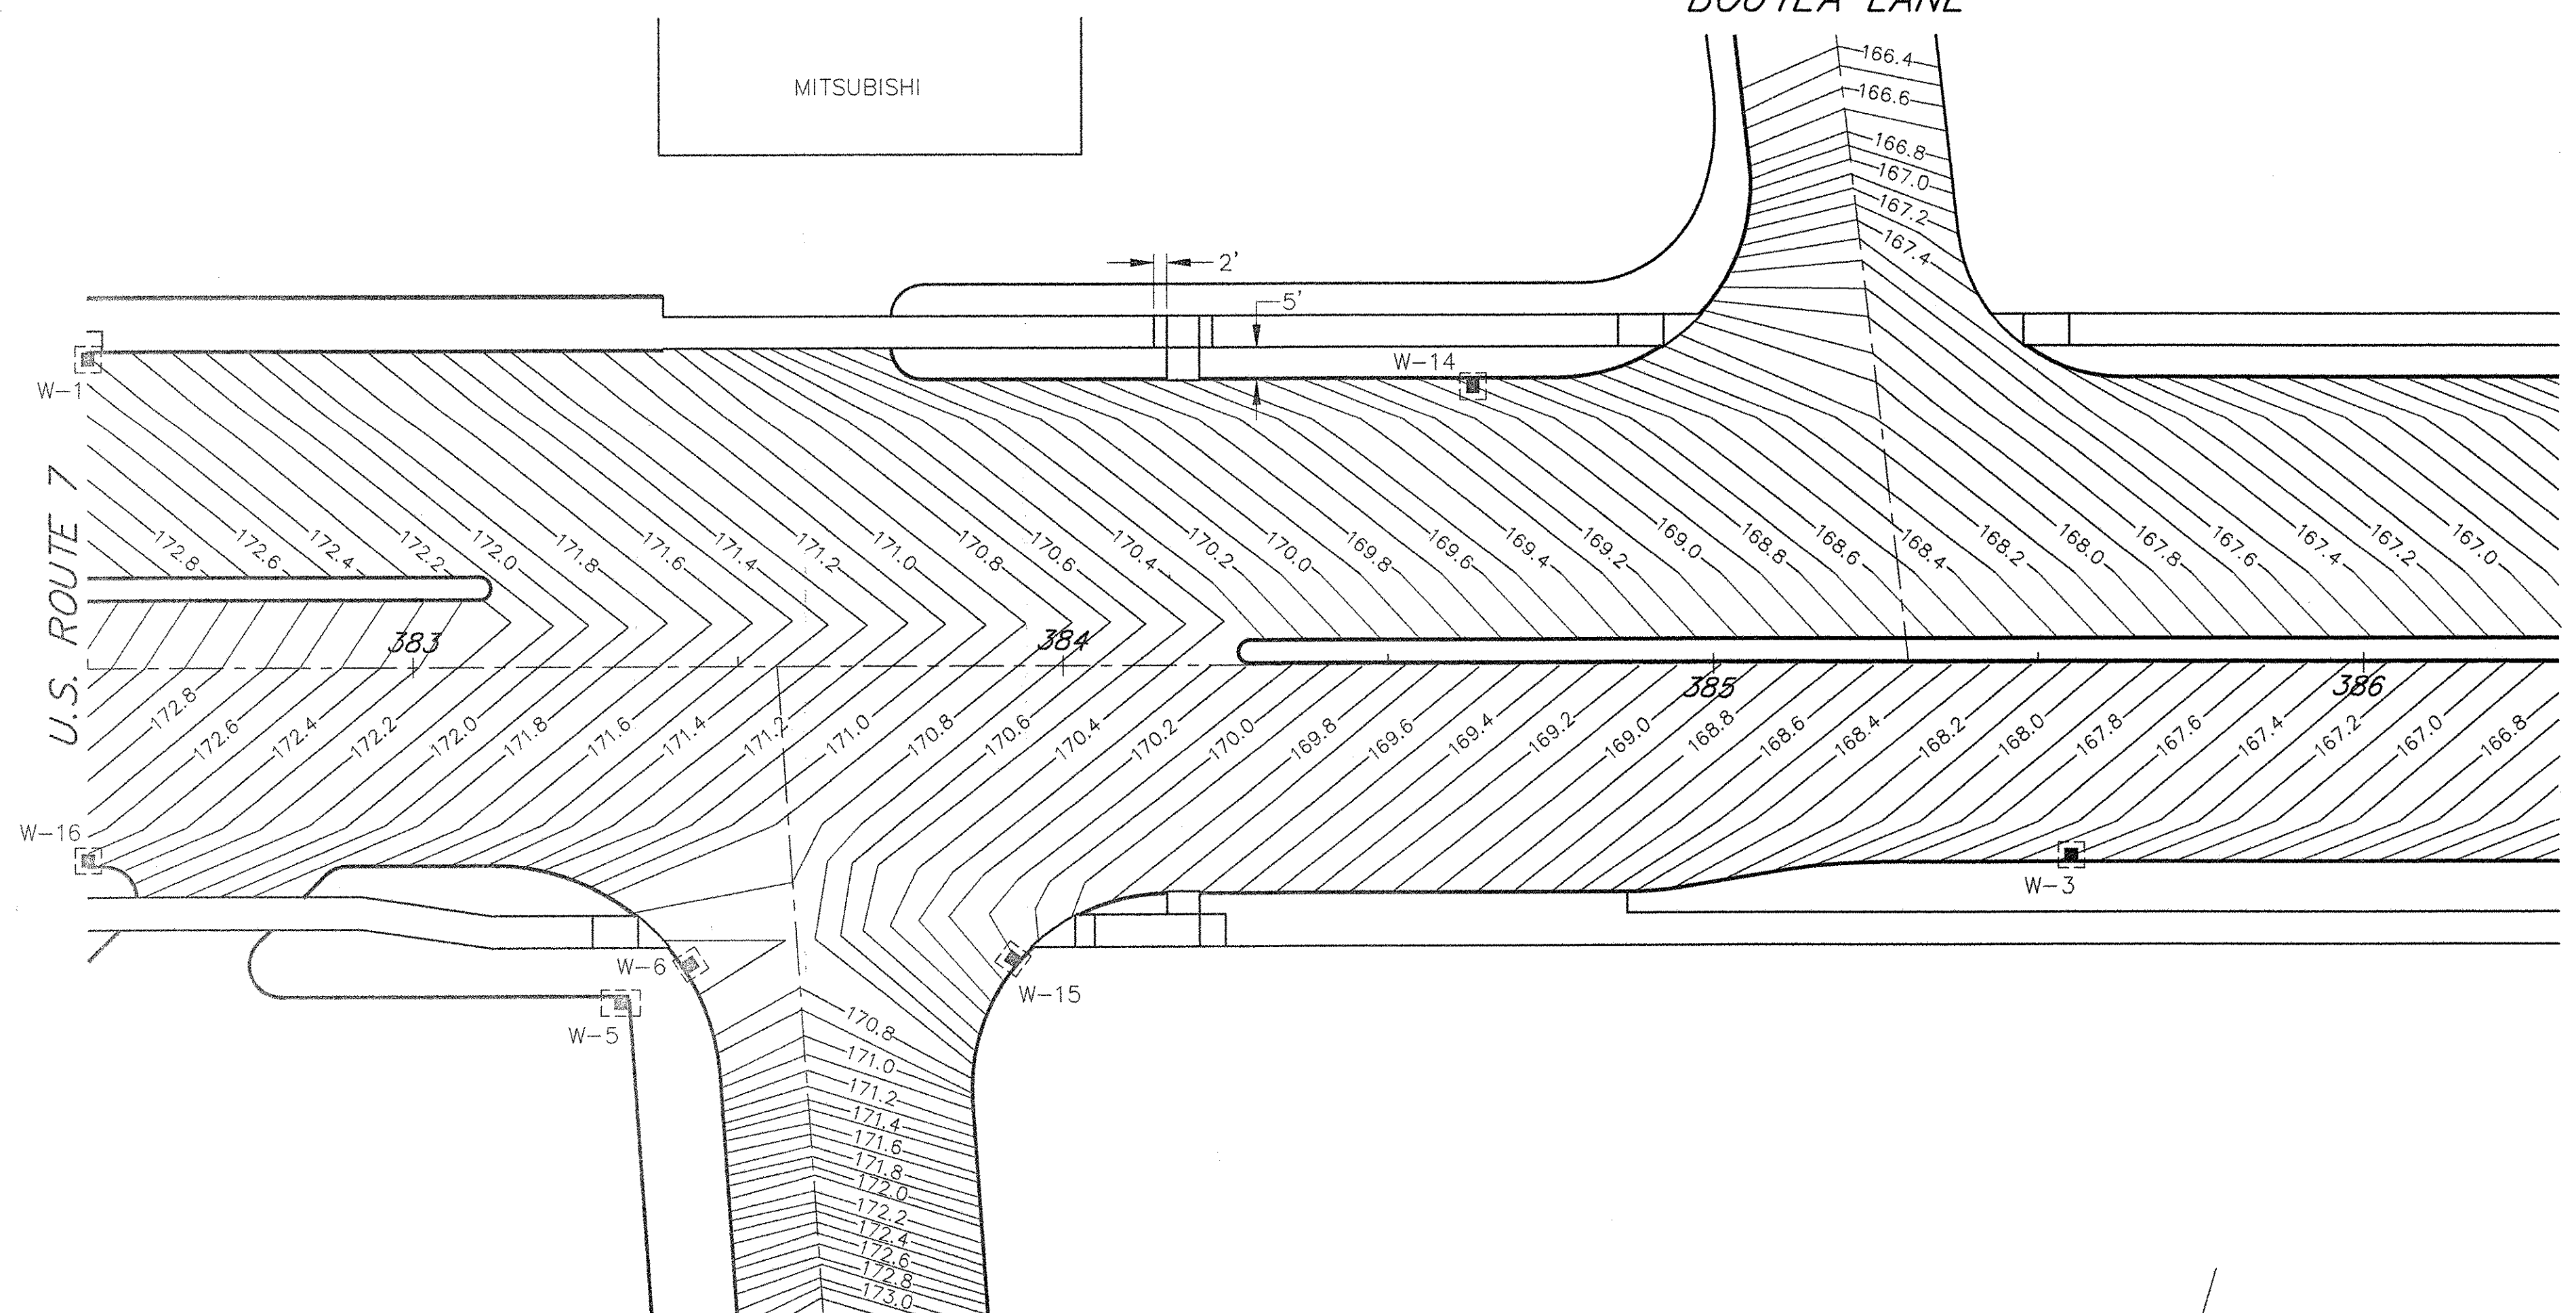

U.S. ROUTE 7

W-1

W-16

W-6

W-5

W-15

W-14

W-3

ALLEN ROAD

BOUYEA LANE

NISSAN

U.S. ROUTE 7

X-4

X-5

HARBOR VIEW ROAD

BARTLETT BAY ROAD

U.S. ROUTE 7

AA-1

AA-2

AA-4

AA-7

SHELBURNE - SOUTH BURLINGTON

SURVEYED BY V.S.C. INC. DATE _____


DRAWN BY E.A.A. INC. DATE _____

TRACED BY E.A.A. INC. DATE _____

PROJECT NH-EGC-019-4(28)

CONTOUR DRAWING NO. 1

SHEET NO. 234 OF 283

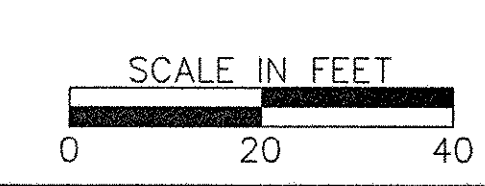

4/4/03

DATUM
VERTICAL NGVD 1929
HORIZONTAL NAD 1927

END APPROACH
& TAPER
BEGIN PROJECT
STA. 376+20.00

TOWN OF SHELBURNE
CITY OF SOUTH BURLINGTON