



DATUM ELEV. = 140.0

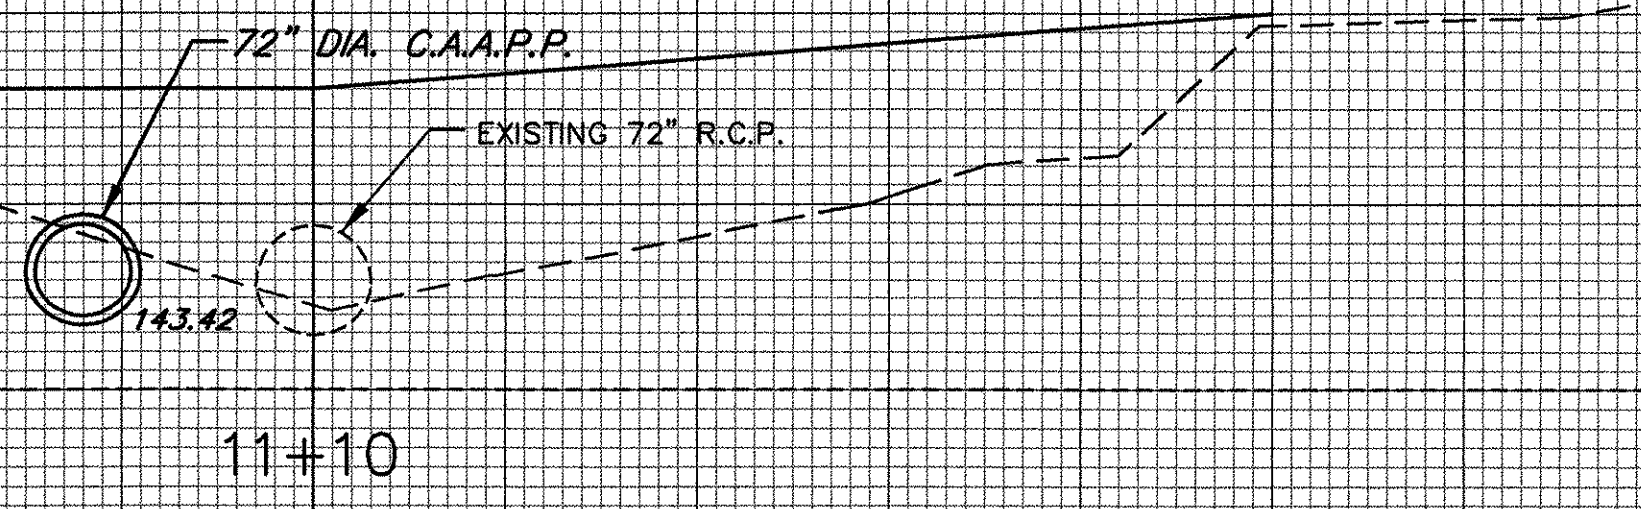


11+10

DATUM ELEV. = 140.0

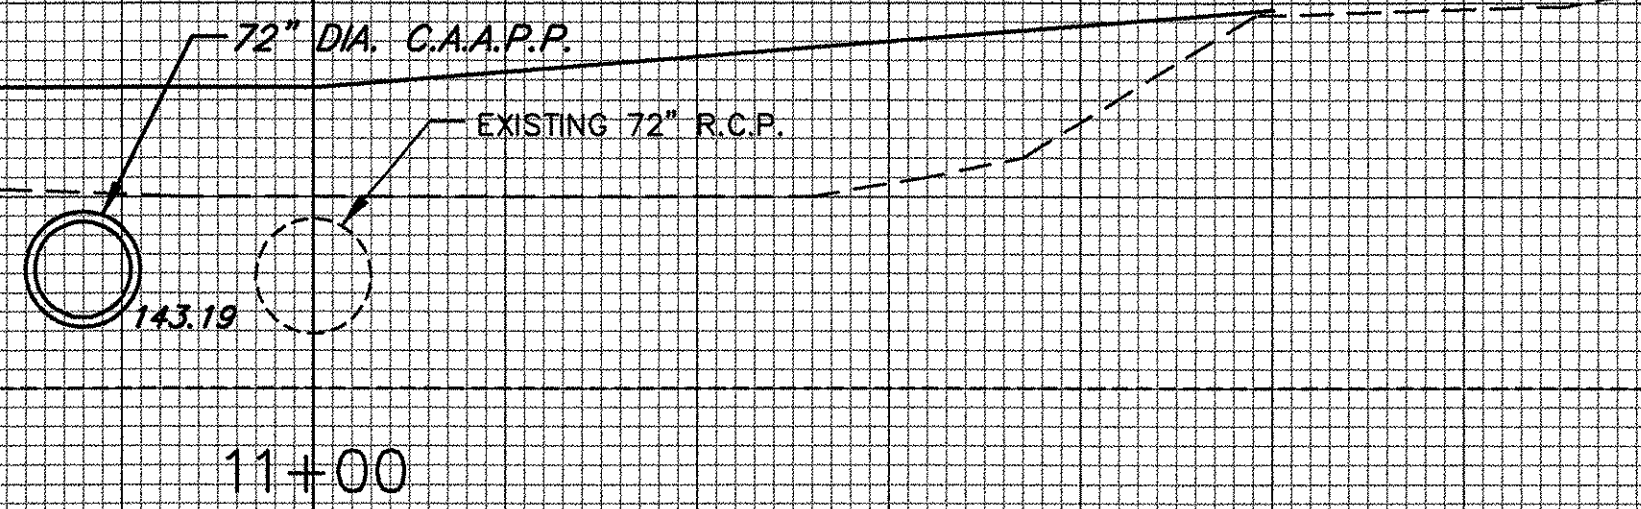


11+00

DATUM ELEV. = 140.0

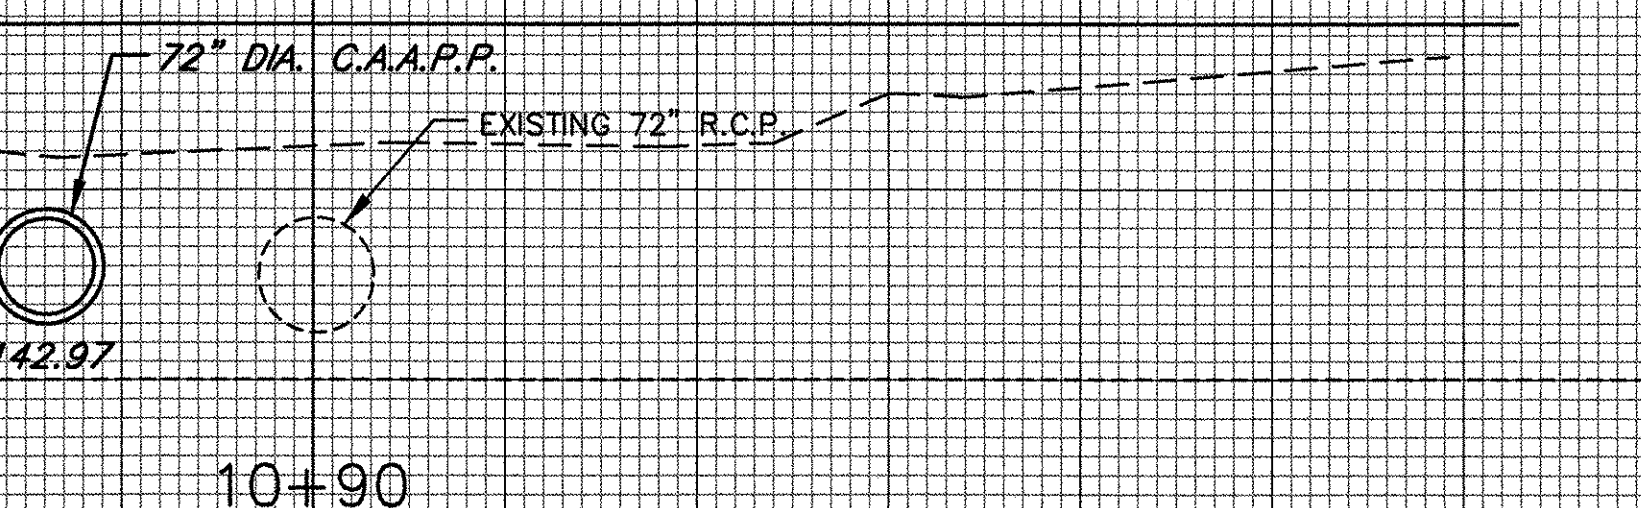


10+90

DATUM ELEV. = 140.0

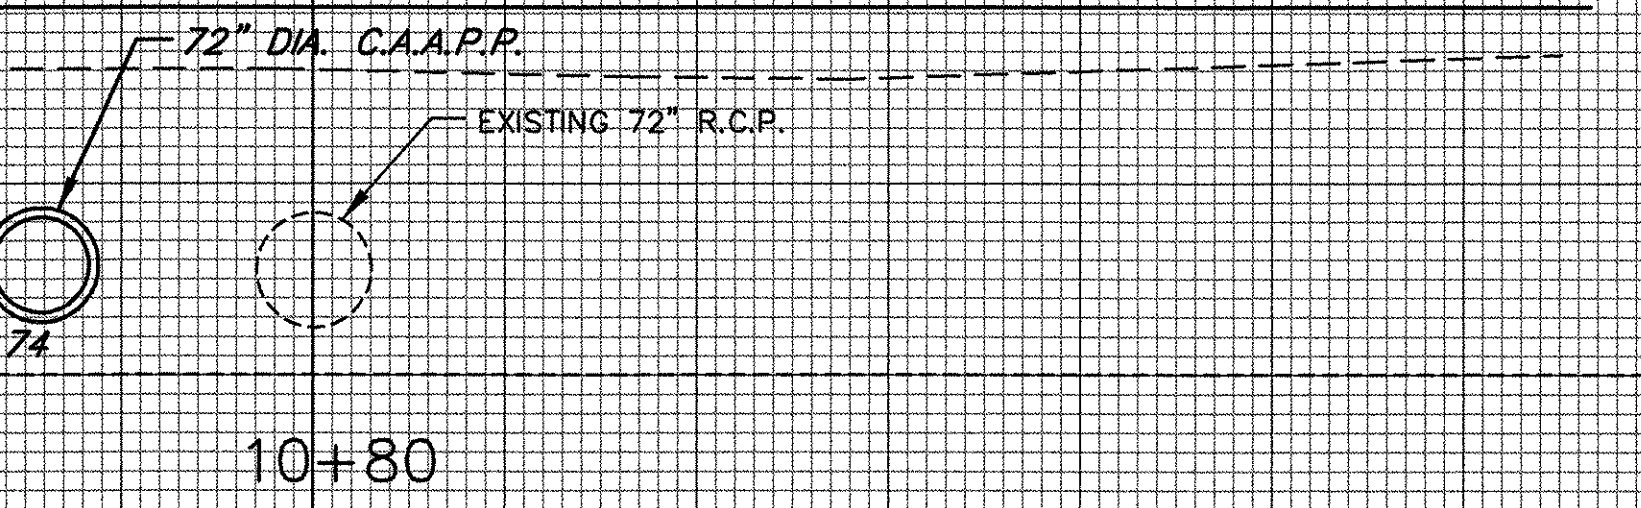

10+80

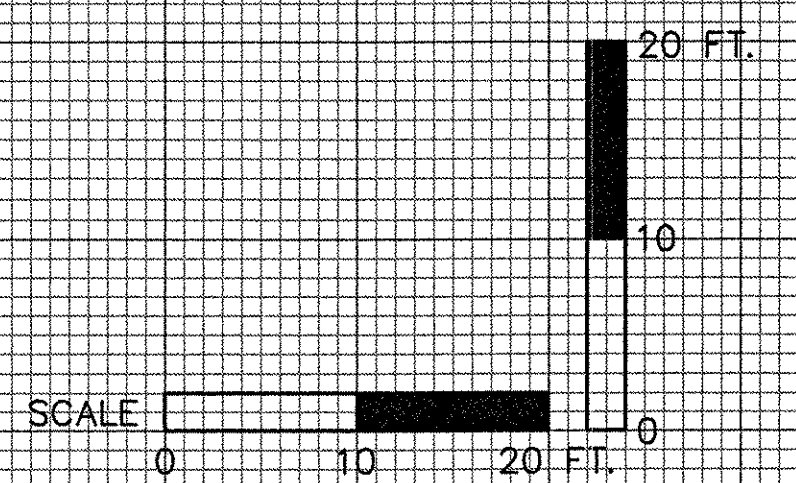

**BARTLETT BROOK CULVERT X-SECTIONS**  
 LOOKING UPSTREAM  
 SHELBURNE - SOUTH BURLINGTON  
 STA. 10+80 TO STA. 11+10  
 SURVEYED BY V.S.C. INC. DATE \_\_\_\_\_  
 DRAWN BY E.A.A. INC. DATE \_\_\_\_\_  
 TRACED BY E.A.A. INC. DATE \_\_\_\_\_  
 PROJECT F-EGC-019-4(28)  
 CROSS-SECTION DWG. NO. PC4  
 SHEET 239 OF 283