



Dedicated to Quality  
 Water and Service

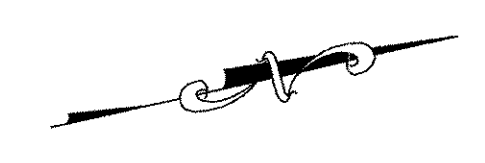

SCALE: 1" = 20'


REVISIONS		
REV. #	DATE	BY

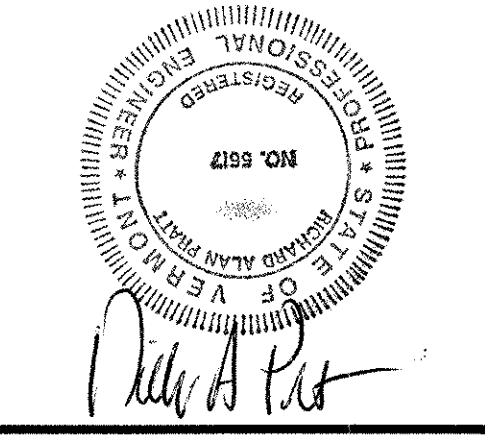

CONTRACT #63  
 WATER MAIN RELOCATION  
 U.S. ROUTE 7  
 "SHELBURNE ROAD"  
 SOUTH BURLINGTON,  
 VERMONT  
 PLAN VIEW  
 STA. 393+00 TO 399+00

DATE: APRIL, 2002  
 DESIGNED BY: RAP  
 DRAWN BY: EJP  
 CHECKED BY: RAP  
 APPROVED BY: RAP  
 FILE NAME: 2000\_C63-pl3(27)  
 SHEET 6 OF 18  
 DRAWING No.

PL3  
 247 OF 283

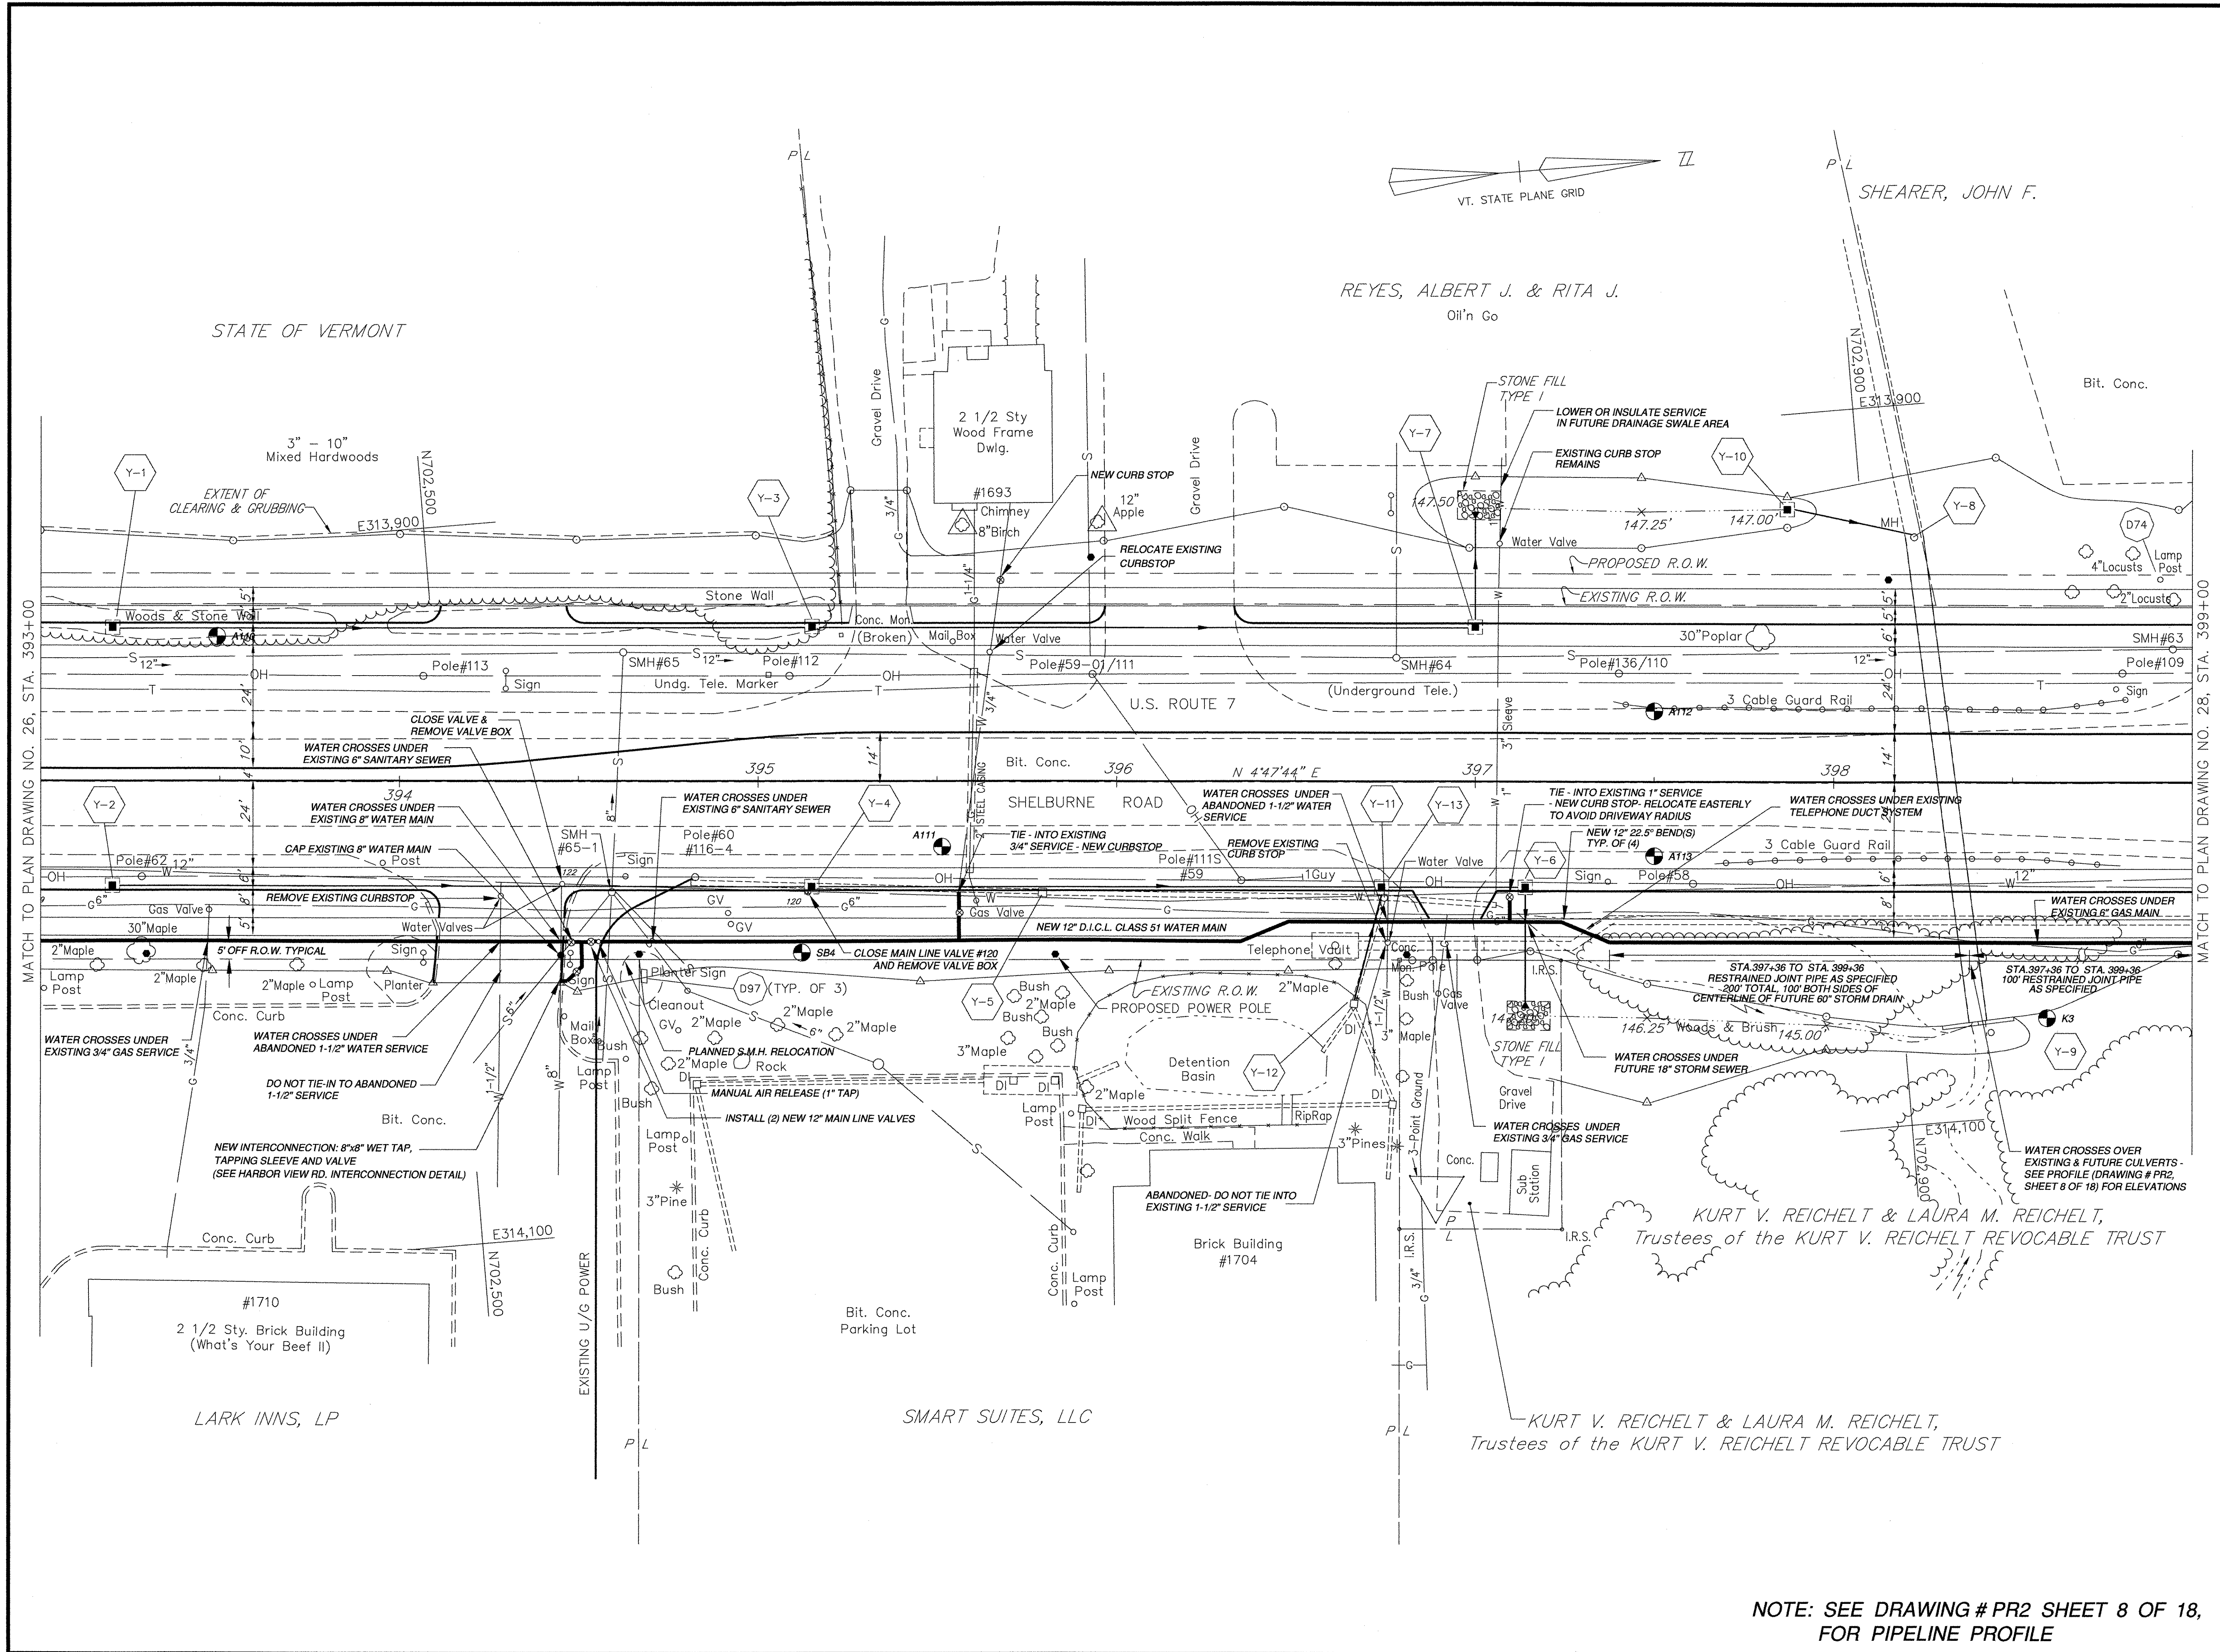

NOTE: SEE DRAWING # PR2 SHEET 8 OF 18,  
 FOR PIPELINE PROFILE