




Dedicated to Quality
 Water and Service

END PROJECT

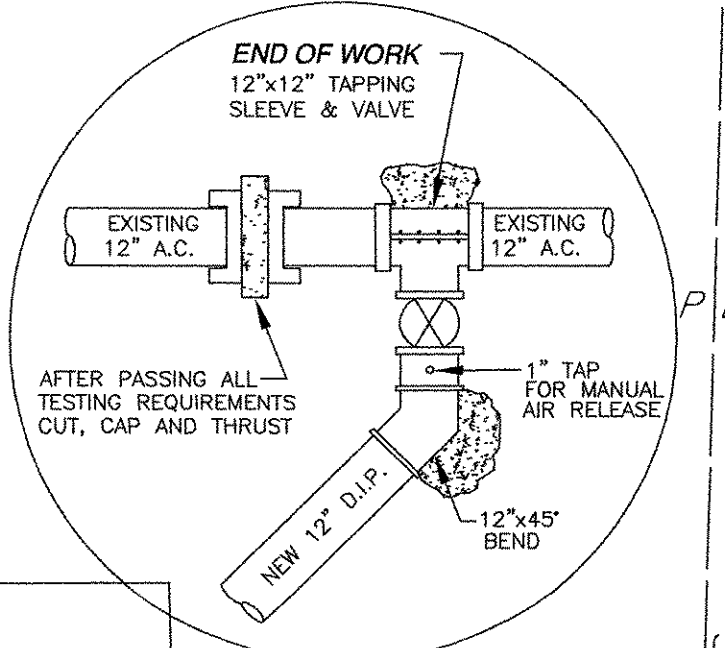

NOTE:
 TEST PIT REQUIRED TO CONFIRM
 MAIN SIZE, DEPTH AND LOCATION
 PRIOR TO WET TAP


INTERCONNECTION DETAIL
 NOT TO SCALE

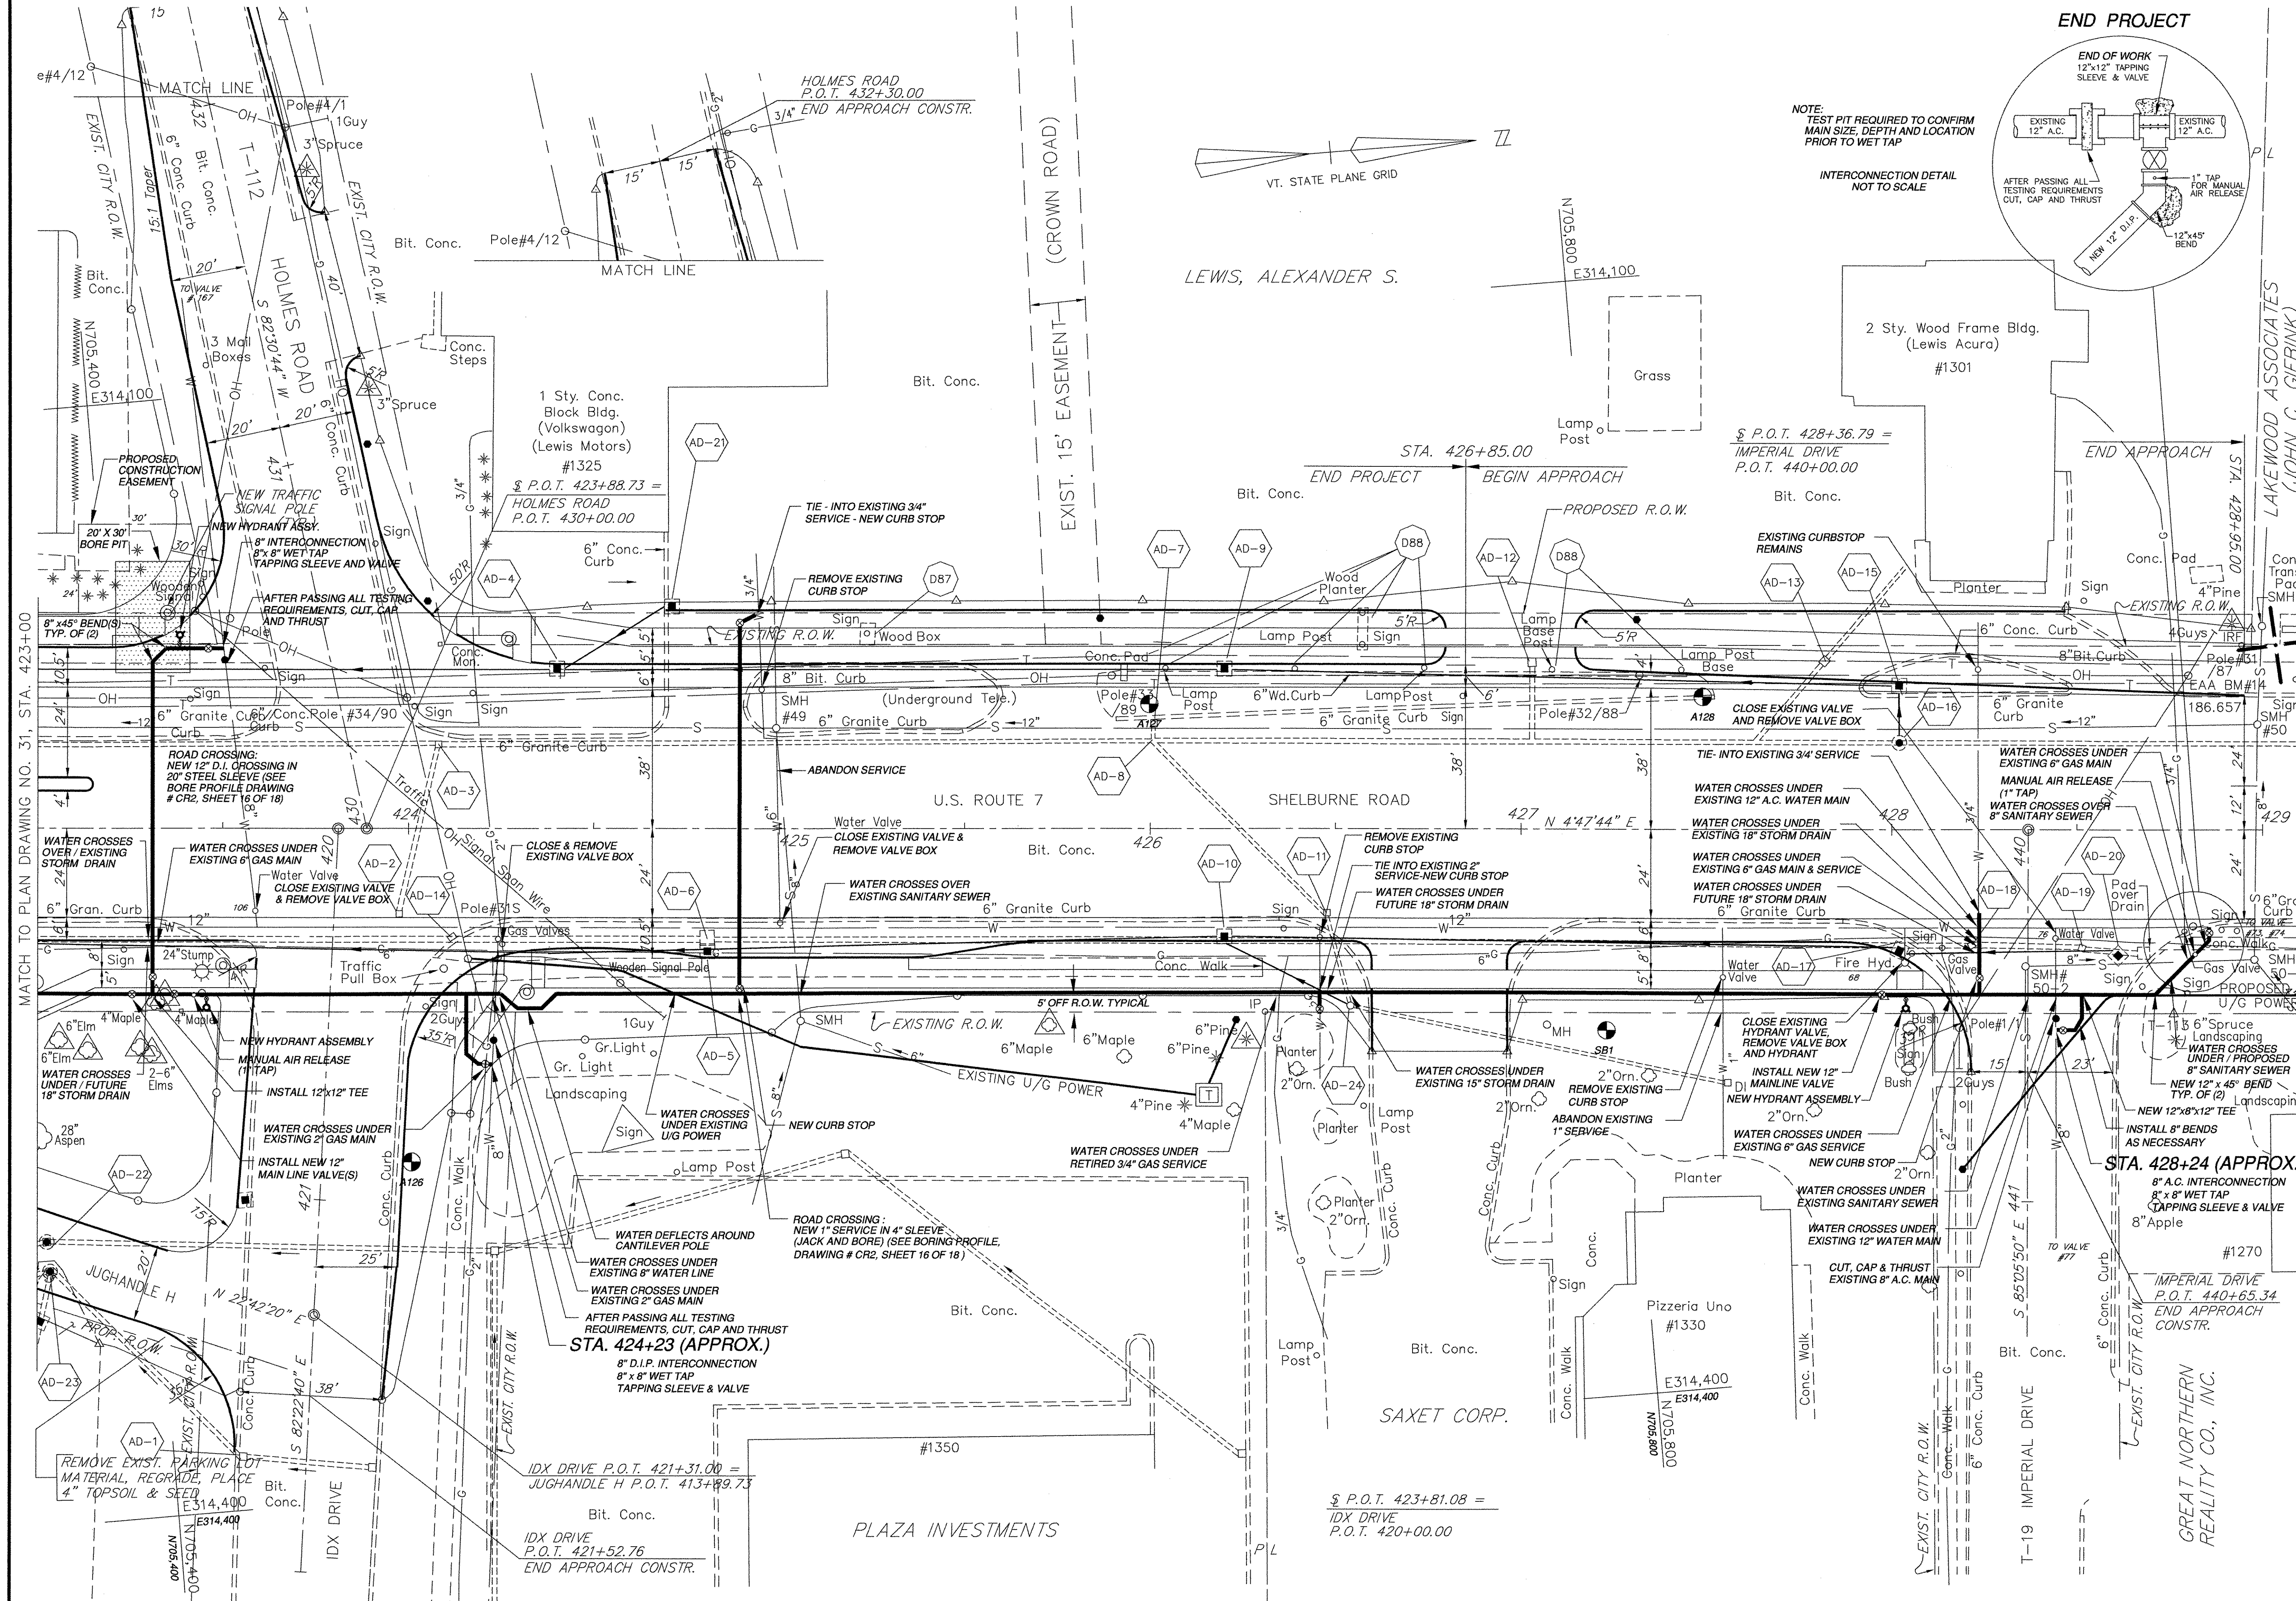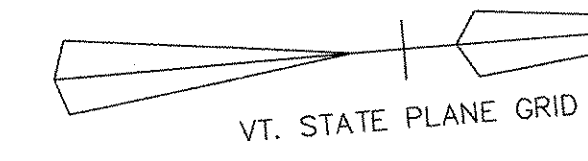

SCALE: 1" = 20'

REVISIONS

REV. #	DATE	BY

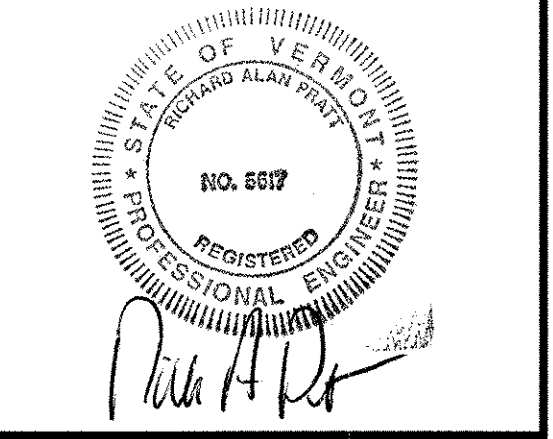

CONTRACT #63

WATER MAIN RELOCATION
 U.S. ROUTE 7
 "SHELBURNE ROAD"

SOUTH BURLINGTON,
 VERMONT

PLAN VIEW
 STA. 423+00 TO 429+00

DATE:	APRIL, 2002
DESIGNED BY:	SGW
DRAWN BY:	EJP
CHECKED BY:	RAP
APPROVED BY:	RAP
FILE NAME:	2000C63-pl8(32)
SHEET	13 OF 18
DRAWING No.	

NOTE: SEE DRAWING PR4, SHEET 14 OF 18,
 FOR PIPELINE PROFILE