

STA. 400+71.85 RT--WEST BRTLT :  
 NEW 4" DRISCO 8000 PE GAS 8/21/97  
 W/BUTT FUSION JOINTS--L/S.

ND. 28 STA. 405+00 SHEL. RD.  
 SEE BARTLETT BAY ROAD SHEET 2


MATCH TO PLAN DRAWING

EXIST. 6" X TRU STEEL

MDT PARTNERSHIP

POMERLEAU, ANTONIO

STA. 409+11.17 53'LT  
 STA. 409+10.4--409+15.67 53'LT  
 ① 4"x4"x4" PE TEE W/4"x2" PE RED. HEADED NORTH.  
 1'3"-1/2" SOUTH OF TEE--4" PE BUTT FUSION.  
 8/21/97. 4'2" NORTH OF TEE--FUTURE 2" TIE-IN.  
 4'6" NORTH OF TEE--END MAIN W/2" PURGE PT.  
 CAP. LOCATOR BOX(2) W/WIRE OVER TEE & END.  
 8/21/97.

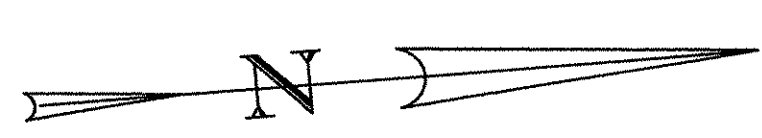

LASH, MILLICENT C.

1 Sty. Metal Bldg.  
 (Audio Video Authority)  
 #1519-1517

2 Sty. Brick Bldg.  
 (Town & Country Furniture)  
 #1515

1 Sty. Brick Bldg.  
 (Jiffy Lube)  
 #1525

4" DRISCO 8000 GAS 8/21/97

U.S. ROUTE 7

SHELBURNE ROAD

EXIST. 6" X TRU STEEL

STA. 406+27.34.7 RT ASKEW RTE. 7  
 STA. 390+34.7 LT GRN. MTN.  
 ① 2" NOBLOW TEE HEADED EAST. 2' EAST OF TEE--  
 2" LUB. PLUG VALVE. 4' EAST OF TEE--2" INS.  
 COUP. & D-1 T.S.. 9/21/78.

- STA. 405+00--405+80.5 RT : EXIST. 6" X TRU STEEL GAS TO REMAIN IN PLACE. INSTALLED OCTOBER OF 1969 W/WELD JOINTS. .188 W.T..
- STA. 405+78.5--411+00 RT : PROPOSED NEW 6" X TRU STEEL .188 W.T. GAS W/WELD JOINTS.
- STA. 409+11.7 53'RT--409+05 27.2'LT : NEW 4" DRISCO PE 8000 GAS 8/21/97--BUTT FUSION JOINTS--L/S. RT OF B/L TO BE LOWERED--LT OF B/L TO REMAIN.
- STA. 406+21.78--409+11.17 LT : NEW 4" DRISCO 8000 PE GAS 8/21/97--BUTT FUSION JOINTS--L/S. TO REMAIN IN PLACE.
- STA. 409+11.17--409+15.67 53'LT : NEW 2" DRISCO 8000 PE GAS 8/21/97--BUTT FUSION JOINTS--L/S. TO REMAIN IN PLACE.
- STA. 409+05 48'RT--27.2'RT : PROPOSED NEW 4" DRISCO 8100 PE GAS. BUTT/ELECTRO FUSION JOINTS--L/S.
- STA. 409+15.5--409+46 53'LT : PROPOSED NEW 2" DRISCO 8100 PE GAS. BUTT/ELECTRO FUSION JOINTS--L/S.
- STA. 390+40.52--392+50 LT GRN MTN. : PROPOSED NEW 2" X TRU STEEL SCH. 40 GAS W/WELD JOINTS.
- STA. 405+82.5--411+00 RT : EXIST. 6" X TRU STEEL GAS TO BE RETIRED IN PLACE. INST. OCTOBER OF 1969 W/WELD JOINTS. .188 W.T.
- STA. 390+34.7--392+46 LT GRN MTN. : EXIST. 2" X TRU STEEL SCH. 40 GAS TO BE RETIRED IN PLACE. INST. 9/21/78 W/WELDS & POST'S.

#1620 SHELBURNE RD.  
 (Heritage Toyota)  
 GAS OFF GREEN MTN. DR.

#1620-1600-1580 SHELBURNE RD.  
 NORDIC FORD/TOYOTA  
 ALLSON PARTNERSHIP

THREE GAS SERVICES--TWO OFF SHEL. RD.  
 & ONE OFF GREEN MTN. DR.

- PROPOSED NEW GAS
- - - EXIST. GAS TO BE LOWERED
- EXIST. GAS TO BE RETIRED

VAOT PROJ. # NH-EGC-019-4(28)  
 GAS DESIGN & ASBUILT BY M.A. OF VGS.

**VERMONT GAS SYSTEMS, INC.**  
**NATURAL GAS PIPELINE**  
**PRESSURE: MEDIUM**  
**SHELBURNE RD. ROUTE 7**  
**SO. BURLINGTON**  
 DWN. BY: ERDMAN ANTHONY  
**DATE: FEBRUARY, 1996**  
**SCALE: 1"=20'** **SHEET: 29**