


⑦ STA. 418+42.5 LT : END OF 2" DRISCO 8000 PE GAS w/2" PURGE PT. CAP ON 11/87. LOCATOR BOX w/WIRE OVER END.

TO #1459 REAR

CRANE, EDWARD B., Trustee,
EDWARD B. CRANE LIVING TRUST

TWO O'BRIENS PROPERTIES, LLC

SOCINSKI, ANTHONY A.

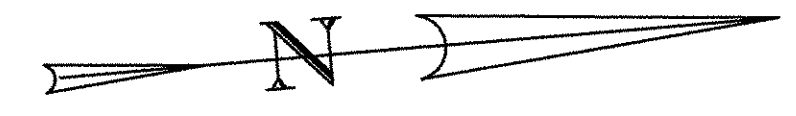

⑧ STA. 422+43.1 LT : END OF 2" DRISCO 8000 PE GAS w/2" PURGE PT. CAP ON 5/27/94. LOCATOR BOX w/WIRE OVER END.

MATCH TO PLAN DRAWING NO. 30 STA. 417+00

MATCH TO PLAN DRAWING NO. 32 STA. 423+00

① STA. 417+35 RT RTE. 7 = 0+13.4-0+16 RT IDX
TAPPED EXIST. 6" X TRU STEEL INST. OCTOBER OF 1969 w/1-1/4" NOBLOW CURB VALVE TEE w/1 STEEL-PE TRANS. FIT. HEADED EAST ON 11/21/85. 3' EAST OF TEE-CAPPED EXIST. 1" DRISCO 8000 PE GAS INST. 11/21/85 ON 10/21/99 STUBBING MAIN. LOCATOR BOX w/WIRE OVER CAP. WELD/BUTTFUSIONS. TO BE RETIRED w/6" X TRU MAIN.

② STA. 420+48.6 RT ROUTE 7
APPRX. TIE-IN & EXT. SOUTH OCTOBER 1969. NORTH OF HERE INSTALLED NOVEMBER OF 1968. TIED-IN w/6" DRESSER COUP. OCTOBER OF 1969.

③ STA. 420+79.2 28.5' LT : TAPPED EXIST. 2" X TRU STEEL INST. 11/23/68 w/1-1/4" NOBLOW CURB VALVE TEE ON 11/6/69.

④ STA. 0+16-2+41.6 RT IDX : RETIRED 1" DRISCO 8000 PE GAS TO IDX ON 10/21/99. INST. 11/21/85 w/BUTT FUSION JOINTS.

④ STA. 420+79.4 38.3' LT : TAPPED EXIST. 2" X TRU STEEL INST. 11/23/68 w/2" BOTTOM OUT STOP. FIT. w/2"x90" WELD STEEL ELL & 2" STEEL-PE TRANS. FIT. HEADED NORTH. 2'9" NORTH OF TEE-TWO 2"x90" PE ELLS-1'4" HORIZ. OFFSET-EAST. 9" NORTH OF EAST ELL-2" PE BALL VALVE. LOCATOR BOX w/WIRE OVER TEE. COMPLETED 5/27/94.

VAOT PROJ. # NH-EGC-019-(428)
GAS DESIGN & ASBUILT BY M.A. OF VGS.

⑤ STA. 420+79.2 77.2' LT-76.2' LT-75.2' LT : END OF EXIST. 2" X TRU STEEL GAS INST. 11/23/68-2" WELD CAP. 1' EAST OF 2" CAP-3/4" PUNCH-IT-TEE (INST. 11/23/68) HEADED NORTH & CAPPED 6" NORTH OF 2" MAIN ON 3/17/80. 2' EAST OF 2" CAP-3/4" PUNCH-IT-TEE (INST. 11/23/68) HEADED SOUTH-6" SOUTH OF TEE-3/4"x90" WELD ELL & 3/4" X TRU STEEL SERVICE WEST TO #1335 SHELBN. RD. ON 12/30/80.

⑥ STA. 419+53.1 LT : TIED-IN TO EXIST. 1-1/4" X TRU STEEL GAS (INST. 11/6/69) w/1-1/4" POSI-1/4" STEEL-PE TRANS. FIT. & 1-1/4"x2" PE EXPANDER HEADED SOUTH ON 11/87. LOCATOR BOX w/WIRE NEAR TIE-IN.

- STA. 417+00-423+00 55' LT RTE. 7 : PROPOSED NEW 6" X TRU STEEL .188 W.T. GAS w/WELD JOINTS.
- STA. 417+00-420+48.6 RT RTE. 7 : EXIST. 6" X TRU STEEL .188 W.T. GAS TO BE RETIRED IN PLACE. INST. OCTOBER OF 1969 w/WELD JOINTS UNLESS OTHERWISE STATED.
- STA. 420+48.6-423+00 RT RTE. 7 : EXIST. 6" X TRU STEEL .188 W.T. GAS TO BE RETIRED IN PLACE. INST. NOVEMBER OF 1968 w/WELD JOINTS UNLESS OTHERWISE STATED.
- STA. 420+73.8 RT-LT ASKEW RTE. 7 : EXIST. 2" X TRU STEEL SCH. 40 GAS TO BE RETIRED IN PLACE. INST. 11/23/68 w/WELD JOINTS.
- STA. 418+42.5-419+53.1 LT RTE. 7 : EXIST. 2" DRISCO 8000 PE GAS TO BE RETIRED IN PLACE. INST. 11/87 w/BUTT FUSION JOINTS UNLESS OTHERWISE STATED.
- STA. 419+53.1-420+79.2 LT RTE. 7 : EXIST. 1-1/4" X TRU STEEL SCH. 40 GAS TO BE RETIRED IN PLACE. INST. 11/6/69 w/WELD JOINTS UNLESS OTHERWISE STATED.
- STA. 420+79.4-422+43.1 LT RTE. 7 : EXIST. 2" DRISCO PE 8000 GAS TO BE RETIRED IN PLACE. INST. 5/27/94 w/BUTT FUSION JOINTS UNLESS OTHERWISE STATED.

VERMONT GAS SYSTEMS, INC.
NATURAL GAS PIPELINE
PRESSURE: MEDIUM
SHELBURNE RD. ROUTE 7
SO. BURLINGTON
 DWN. BY: ERDMAN ANTHONY
DATE: FEBRUARY, 1996
SCALE: 1"=20' **SHEET: 31**