


STATE OF VERMONT

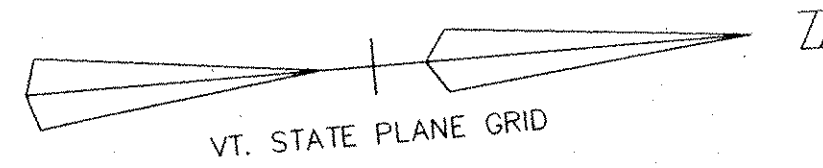

SHEARER, JOHN F.

REYES, ALBERT J. & RITA J.

NOTE: P51 WILL HAVE 6' OF FILL AND SO-VZ ANCHOR WILL HAVE 3' OF FILL ADD ROD EXTENTION LEAVING 3' + OUT OF GROUND

(R)P62/VZ116-3		
Install	Remove	Transfer
55' #1 POLE 1-SGL X-ARM 130' OF 3# 477 PRI & 4/0 NEUT 1-25KVA XFMR + CO 1-NEUT BKT	40' POLE 1-SGL X-ARM 154' OF 3# 336 PRI & 4/0 NEUT 1-NEUT BKT	

NOTE: SEE SHEET 14 FOR INSTALL (N)P62

(R)P60/VZ116-4		
Install	Remove	Transfer
50' #2 POLE 1-SGL X-ARM 117' OF 3# 477 PRI & 4/0 NEUT 1-3# XFMR BANK, W/3-50S + 3-CO @ 120/208 1-NEUT BKT	40' POLE 1-SGL X-ARM 152' OF 3# 336 PRI & 4/0 NEUT 152' OF #6 TRI SEC 1-5" PRI RISER & 3-CO/ARR 1-NEUT BKT	

NOTE: SEE SHEET 15 FOR INSTALL (N)P60

(E)P59-02 to 52-02 /VZ100A to 109A2 34688

(E)P52-01/VZ019A1		
Install	Remove	Transfer
151' OF 3# 1/0 OH PRI & NEUT 151' OF 1/0 TRI SEC 1-(JO) ANCH & GUY	126' OF 3# 1/0 OH PRI & NEUT 126' OF 1/0 TRI SEC 1-(JO) ANCH & GUY	

(N)P51/VZ108

Install	Remove	Transfer
55' #1 POLE 1-ANGLE DBL X-AMRS 175' OF 3# 477 OH PRI & 4/0 NEUT 1-(SO-GMP) ANCH & 3-GUY 2-(SO-VZ) ANCH 2-NEUT D.E.		

(E)P59-01 to 52-01/VZ100 to 109A1 34688

(N)P51/VZ108 102033 397+90 @ 56 1/2 LT

MATCH TO PLAN DRAWING NO. 15, STA. 393+00

MATCH TO PLAN DRAWING NO. 17, STA. 399+00

U.S. ROUTE 7 SHELBURNE ROAD

D 45 4426

(R)P62/VZ116-3 34750

(R)P60/VZ116-4 34749

(R)P59/VZ115 34745

(R)P58 34744

(N)P55/VZ112 102037 393+32 @ 48 1/2 RT

(N)P54/VZ111 102036 394+62 @ 48 1/2 RT

(N)P53/VZ110 102035 395+72 @ 48 1/2 RT

(E)P53 to P52/VZ104A to 109 34745 396+82 @ 48 1/2 RT

(N)P55/VZ112		
Install	Remove	Transfer
50' #2 POLE 1-SGL X-ARM 130' OF 3# 477 PRI & 4/0 NEUT 1-NEUT BKT	35' POLE 1-SGL X-ARM 135' OF 3# 336 PRI & 4/0 NEUT 1-NEUT BKT	

NOTE: SET POLE AT 8' DEPTH FOR 1' FUTURE CUT

NOTE: SEE SHEET 17 FOR REMOVAL (R)P55

DISCONNECT & PULL BACK UNG PRI, EXPOSE/EXTEND EXIST. 5" PRI DUCT, PULL BACK IN & RETERMINATE AS REQ'D.

(N)P53/VZ110		
Install	Remove	Transfer
50' #2 POLE 1-SGL X-ARM 110' OF 3# 477 PRI & 4/0 NEUT 1-NEUT BKT	35' POLE 1-SGL X-ARM 135' OF 3# 336 PRI & 4/0 NEUT 1-NEUT BKT	

NOTE: SEE SHEET 18A FOR REMOVAL (R)P53

(E)P53 to P52/VZ109		
Install	Remove	Transfer
1-ANGLE DBL X-ARMS 1-DBL X-ARMS D.E. 3-C/O @ 12K FUSES 151' OF 3# 477 PRI & 4/0 NEUT 1-25 KVA XFMR + CO 1-NEUT BKT 1-NEUT D.E. 2-SPAN GUYS	52' OF 1/0 TRI TAPE EXIST UNG SERV	

SMART SUITES, LLC

KURT V. REICHEL & LAURA M. REICHEL, Trustees of the KURT V. REICHEL REVOCABLE TRUST

LARK INNS, LP

D 45 4288

(N)P54/VZ111

Install	Remove	Transfer
50' #2 POLE 1-SGL X-ARM 110' OF 3# 477 PRI & 4/0 NEUT 1-5" PRI RISER & 3-CO @ 100K FUSES & ARR 1-NEUT BKT	35' POLE 1-SGL X-ARM DBL D.E. W/AMPS 136' OF 3# 336 PRI & 4/0 NEUT 1-10 KVA XFMR + CO 1-NEUT BKT 1-1/2" SEC RISER	3# 1/0 UNG PRI & NEUT FROM (R)P60

NOTE: SEE SHEET 17 FOR REMOVAL (N)P54

(R)P59/VZ???

Install	Remove	Transfer
50' #2 POLE 1-SGL X-ARMS 1-DBL X-ARM D.E. 1-3-C/O @ 12K FUSES 117' OF 3# 477 PRI & 4/0 NEUT 1-NEUT D.E. 1-NEUT BKT	45' POLE 1-SGL X-ARM 1-DBL X-ARM D.E. 126' OF 3# 336 PRI & 4/0 NEUT 1-25 KVA XFMR + CO 1-(JO) ANCH & GUY 1-STREET LIGHT 1-NEUT D.E. 1-NEUT BKT	

NOTE: SEE SHEET 15 FOR INSTALL (N)P59

(N)P52-30/VZ109A 102034

(R)P58/VZ???

Install	Remove	Transfer
50' #2 POLE 1-SGL X-ARMS 130' OF 3# 477 PRI & 4/0 NEUT 1-3# XFMR BANK, W/3-15s + 3-CO @ 120/208 1-NEUT BKT	40' POLE 1-SGL X-ARMS 158' OF 3# 336 PRI & 4/0 NEUT 1-NEUT BKT	

NOTE: SEE SHEET 15 FOR INSTALL (N)P58

(N)P52-30/VZ109A

Install	Remove	Transfer
45' #3 POLE 1-(SO-GMP) ANCH & 2-GUYS 1-(SO-VZ) ANCH		

NOTE: FRONT ANCH FOR VERIZON ONLY

KURT V. REICHEL & LAURA M. REICHEL, Trustees of the KURT V. REICHEL REVOCABLE TRUST

2-ADDITIONAL ANCHORS WERE ADDED 4-9-09 mm

GREEN MOUNTAIN POWER CORPORATION
SOUTH BURLINGTON, VERMONT
12470Y 4W 3PH FEEDER
32G4 OVERHEAD
SHELBURNE ROAD RECONSTRUCTION
DRAWN: LAW CHECKED: MM APPROVED: WH SCALE: 1"=20'
DATE: 8-9-02 DRAWING NO: PL-27-4-16 SHEET: 16