


#1675

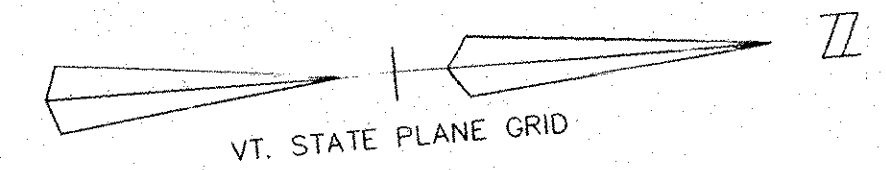

SHEARER, JOHN F.

(N)P50/VZ107  
Install Remove

50' #2 POLE  
1-SGL X-ARM  
173' OF 3# 477  
PRI & 4/O NEUT  
1-NEUT BKT

(N)P49/VZ106  
Install Remove

50' #2 POLE  
173' OF 3# 477  
PRI & 4/O NEUT  
1-150KVAR CAP  
BANK +3-CO  
1-NEUT BKT

(N)P48/VZ105  
Install Remove

50' #2 POLE  
1-SGL X-ARM  
1-1# PRI D.E. +  
CO @ 12K FUSE  
117' OF 3# 477  
PRI & 4/O NEUT  
1-(SO) ANCH &  
GUY  
1-NEUT BKT

(N)P50/VZ107  
102032  
399+66 @ 56 1/2' LT

(N)P49/VZ106  
102031  
401+39 @ 56 1/2' LT

(N)P48/VZ105  
102029  
403+12 @ 56 1/2' LT

(E)P47/VZ104  
102028

MATCH TO PLAN DRAWING NO. 16, STA. 399+00

MATCH TO PLAN DRAWING NO. 18, STA. 405+00

400  
U.S. ROUTE 7

402  
SHELBURNE ROAD

(R)P57  
34734

(R)P56  
34742

(R)P55  
34741

(R)P54  
34738

(R)P53/VZ104A  
34737

(R)P57  
Install Remove

55' #1 POLE  
1-SGL X-ARMS  
1-5" PRI UNG  
RISER &  
3-CO/ARR @  
100K FUSES  
1-25 KVA XFMR  
+ C/O  
1-2 1/2" SEC RISER  
1-NEUT BKT

NOTE: SEE  
SHEET 15 FOR  
INSTALL (R)P57

(R)P56  
Install Remove

35' POLE  
1-SGL X-ARM  
154' OF 3# 336  
PRI & 4/O NEUT  
1-150KVAR CAP  
BANK +3-CO  
1-NEUT BKT

NOTE: SEE  
SHEET 15 FOR  
INSTALL (R)P56

(R)P55  
Install Remove

50' #2 POLE  
1-SGL X-ARM  
130' OF 3# 477  
PRI & 4/O NEUT  
1-NEUT BKT

NOTE: SET  
POLE AT 8'  
DEPTH FOR 1'  
FUTURE CUT  
SEE SHEET 16  
FOR INSTALL  
(R)P55

(N)P48-01/VZ105A  
102030  
402+79 @ 48 1/2' RT

(N)P48-01/VZ105A  
Install Remove

45' #3 POLE  
1-1# PRI D.E.  
110' OF 1# 1/O  
PRI & NEUT  
1-10 KVA XFMR +  
1-CO @ 2K FUSE  
1-(SO) ANCH &  
GUY  
1-NEUT D.E.  
1-2 1/2" SEC RISER

(R)P54  
Install Remove

50' #2 POLE  
1-SGL X-ARM  
110' OF 3# 477  
PRI & 4/O NEUT  
1-5" PRI RISER  
& 3-CO/ARR  
1-NEUT BKT

NOTE: SEE  
SHEET 16 FOR  
INSTALL (R)P54


MDT PARTNERS

KURT V. REICHELDT & LAURA M. REICHELDT,  
Trustees of the KURT V. REICHELDT REVOCABLE TRUST

(E)LIGHT #1  
Install Remove

127' OF 3-#6 AL  
UNG SEC

165' OF 3-#6 AL  
UNG SEC

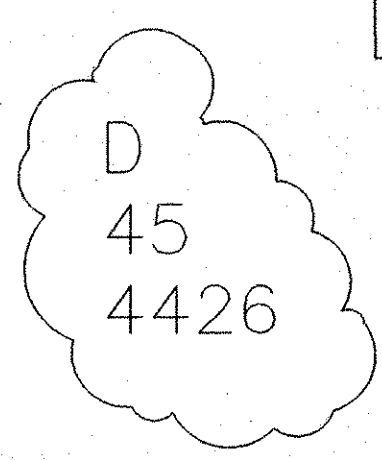

SHEET 277 OF 283

GREEN MOUNTAIN POWER CORPORATION  
SOUTH BURLINGTON, VERMONT

12470Y 4W 3PH FEEDER

**32G4  
OVERHEAD**

SHELBURNE ROAD RECONSTRUCTION

DRAWN: LAW    CHECKED: MM    APPROVED: WH    SCALE: 1"=20'  
DATE: 7-18-02    DRAWING NO. PL-28.4.17    SHEET: 17