


CONSTRUCT DRIVE	
297+33	LT - 30'
299+00	RT - 16' (GRAVEL)
300+77	RT - 16' (GRAVEL)
302+37	RT - 16' (GRAVEL)
302+69	LT - 19'
WINTER HAVEN	- 81+15 LT - 25'

CONSTRUCT APPROACH
MAPLE LEAF LANE 301+57.50 LT

DEMOLITION & DISPOSAL OF:	
D12	@ 300+00, RT (FENCE)
D19	@ 297+00, LT (FENCE & LP)
D20	@ 297+57, LT (FENCE)
D22	@ 300+86 RT
	TO 303+80 RT (FENCE)
D23	@ 302+75, RT (HOUSE)

DATUM
VERTICAL NGVD 1929
HORIZONTAL NAD 1927

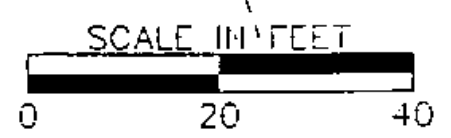

R.O.W. PLAN	
THIS SHEET TO BE USED FOR R.O.W. INFORMATION ONLY.	
SURVEYED BY V.S.C. INC. DATE	PROJECT F-EGC-019-4(19)
DRAWN BY E.A.A. INC. DATE	R.O.W. DRAWING NO. 12
TRACED BY E.A.A. INC. DATE	SHEET NO. 65 OF 129 51 OF 537