


MATCH TO R.O.W. PLAN DRAWING NO. 13, STA. 309+00

MATCH TO R.O.W. PLAN DRAWING NO. 15, STA. 315+00

CONSTRUCT DRIVE	
309+04	LT - 18'
311+98	RT - 16'
309+19	RT - 16' (GRAVEL)
311+81	LT - 30'
111+56	RT - 20'

DEMOLITION & DISPOSAL OF:	
D27 @ 308+85,	RT (HOUSE)
D31 @ 309+35,	RT (SIGN)
D32 @ 311+57,	LT (SIGN)
D33 @ 313+04,	LT (SIGN)
D34 @ 315+00,	LT (SIGN & 2 GLs)
D105 @ 312+85,	LT (STEPS TOWARDS ROAD)

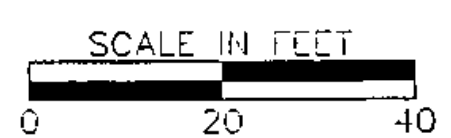

DATUM  
VERTICAL NGVD 1929  
HORIZONTAL NAD 1927

<b>R.O.W. PLAN</b>	
THIS SHEET TO BE USED FOR R.O.W. INFORMATION ONLY.	
SHELBURNE - SOUTH BURLINGTON	
SURVEYED BY V.S.C. INC. DATE _____	
DRAWN BY E.A.A. INC. DATE _____	
TRACED BY E.A.A. INC. DATE _____	
PROJECT	F-EGC-019-4(19)
R.O.W. DRAWING NO.	14
SHEET NO. 67 OF 129	53 OF 537