


**CURVE NO. C6
MAINLINE (U.S. ROUTE 7)**
 P.I. STA. 374+83.42 B.K. =
 STA. 374+82.10 AHD.
 $\Delta = 9^\circ 10' 00''$
 $D = 1' 30' 00''$
 $R = 3819.83'$ (CHORD DEF.)
 $L = 611.11'$
 $T = 306.22'$
 $E = 12.25'$
 P.C. STA. 371+77.21
 P.T. STA. 377+88.32
 BANK 0.021' PER FOOT

**CONSTRUCT APPROACH
PINE HAVEN SHORE ROAD 371+89.87 LT**

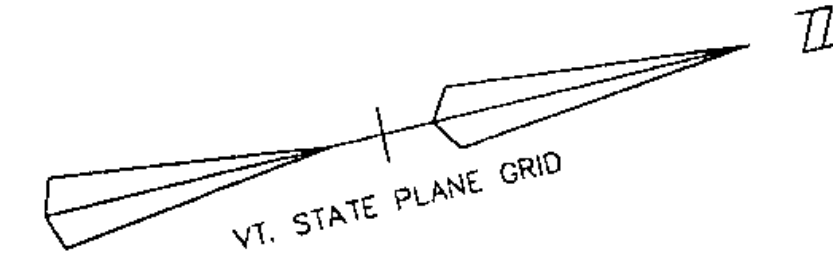

DEMOLITION & DISPOSAL OF:
 D68 @ 367+75 TO 369+80, RT
 (SIGN, STONE WALL, 3 LAMP POSTS,
 & 3 BEAR SCULPTURES)
 D69 @ 371+10, RT (SIGN & LP)
 D71 @ 370+67 TO 371+46, LT (SIGNS (2),
 LP (2), GL (2) & STONE RET. WALL)
 D111 @ 369+85, RT (PLANTER &
 SCULPTURE)
 D112 @ 372+35, LT (SIGN & 2 GLs)
 D114 @ 372+04, RT (LAMP POST)
 D116 @ 370+45 LT (WALL)
 D117 @ 374+70, RT (LAMP POST)
 D127 @ 368+98, LT (SIGN & 2 GLs)

ANDRUS, WILLIAM


HANDY, PAUL L. &
CATHERINE M.

GLASER, TOM P. & JILL F.

CLIMB HIGH, INC.

KIM E. LASH, REVOCABLE TRUST
LASH, KIM E., TRUSTEE

ROBERTS, LAWRENCE R.
& ROBERTS, SHIRLEY T.

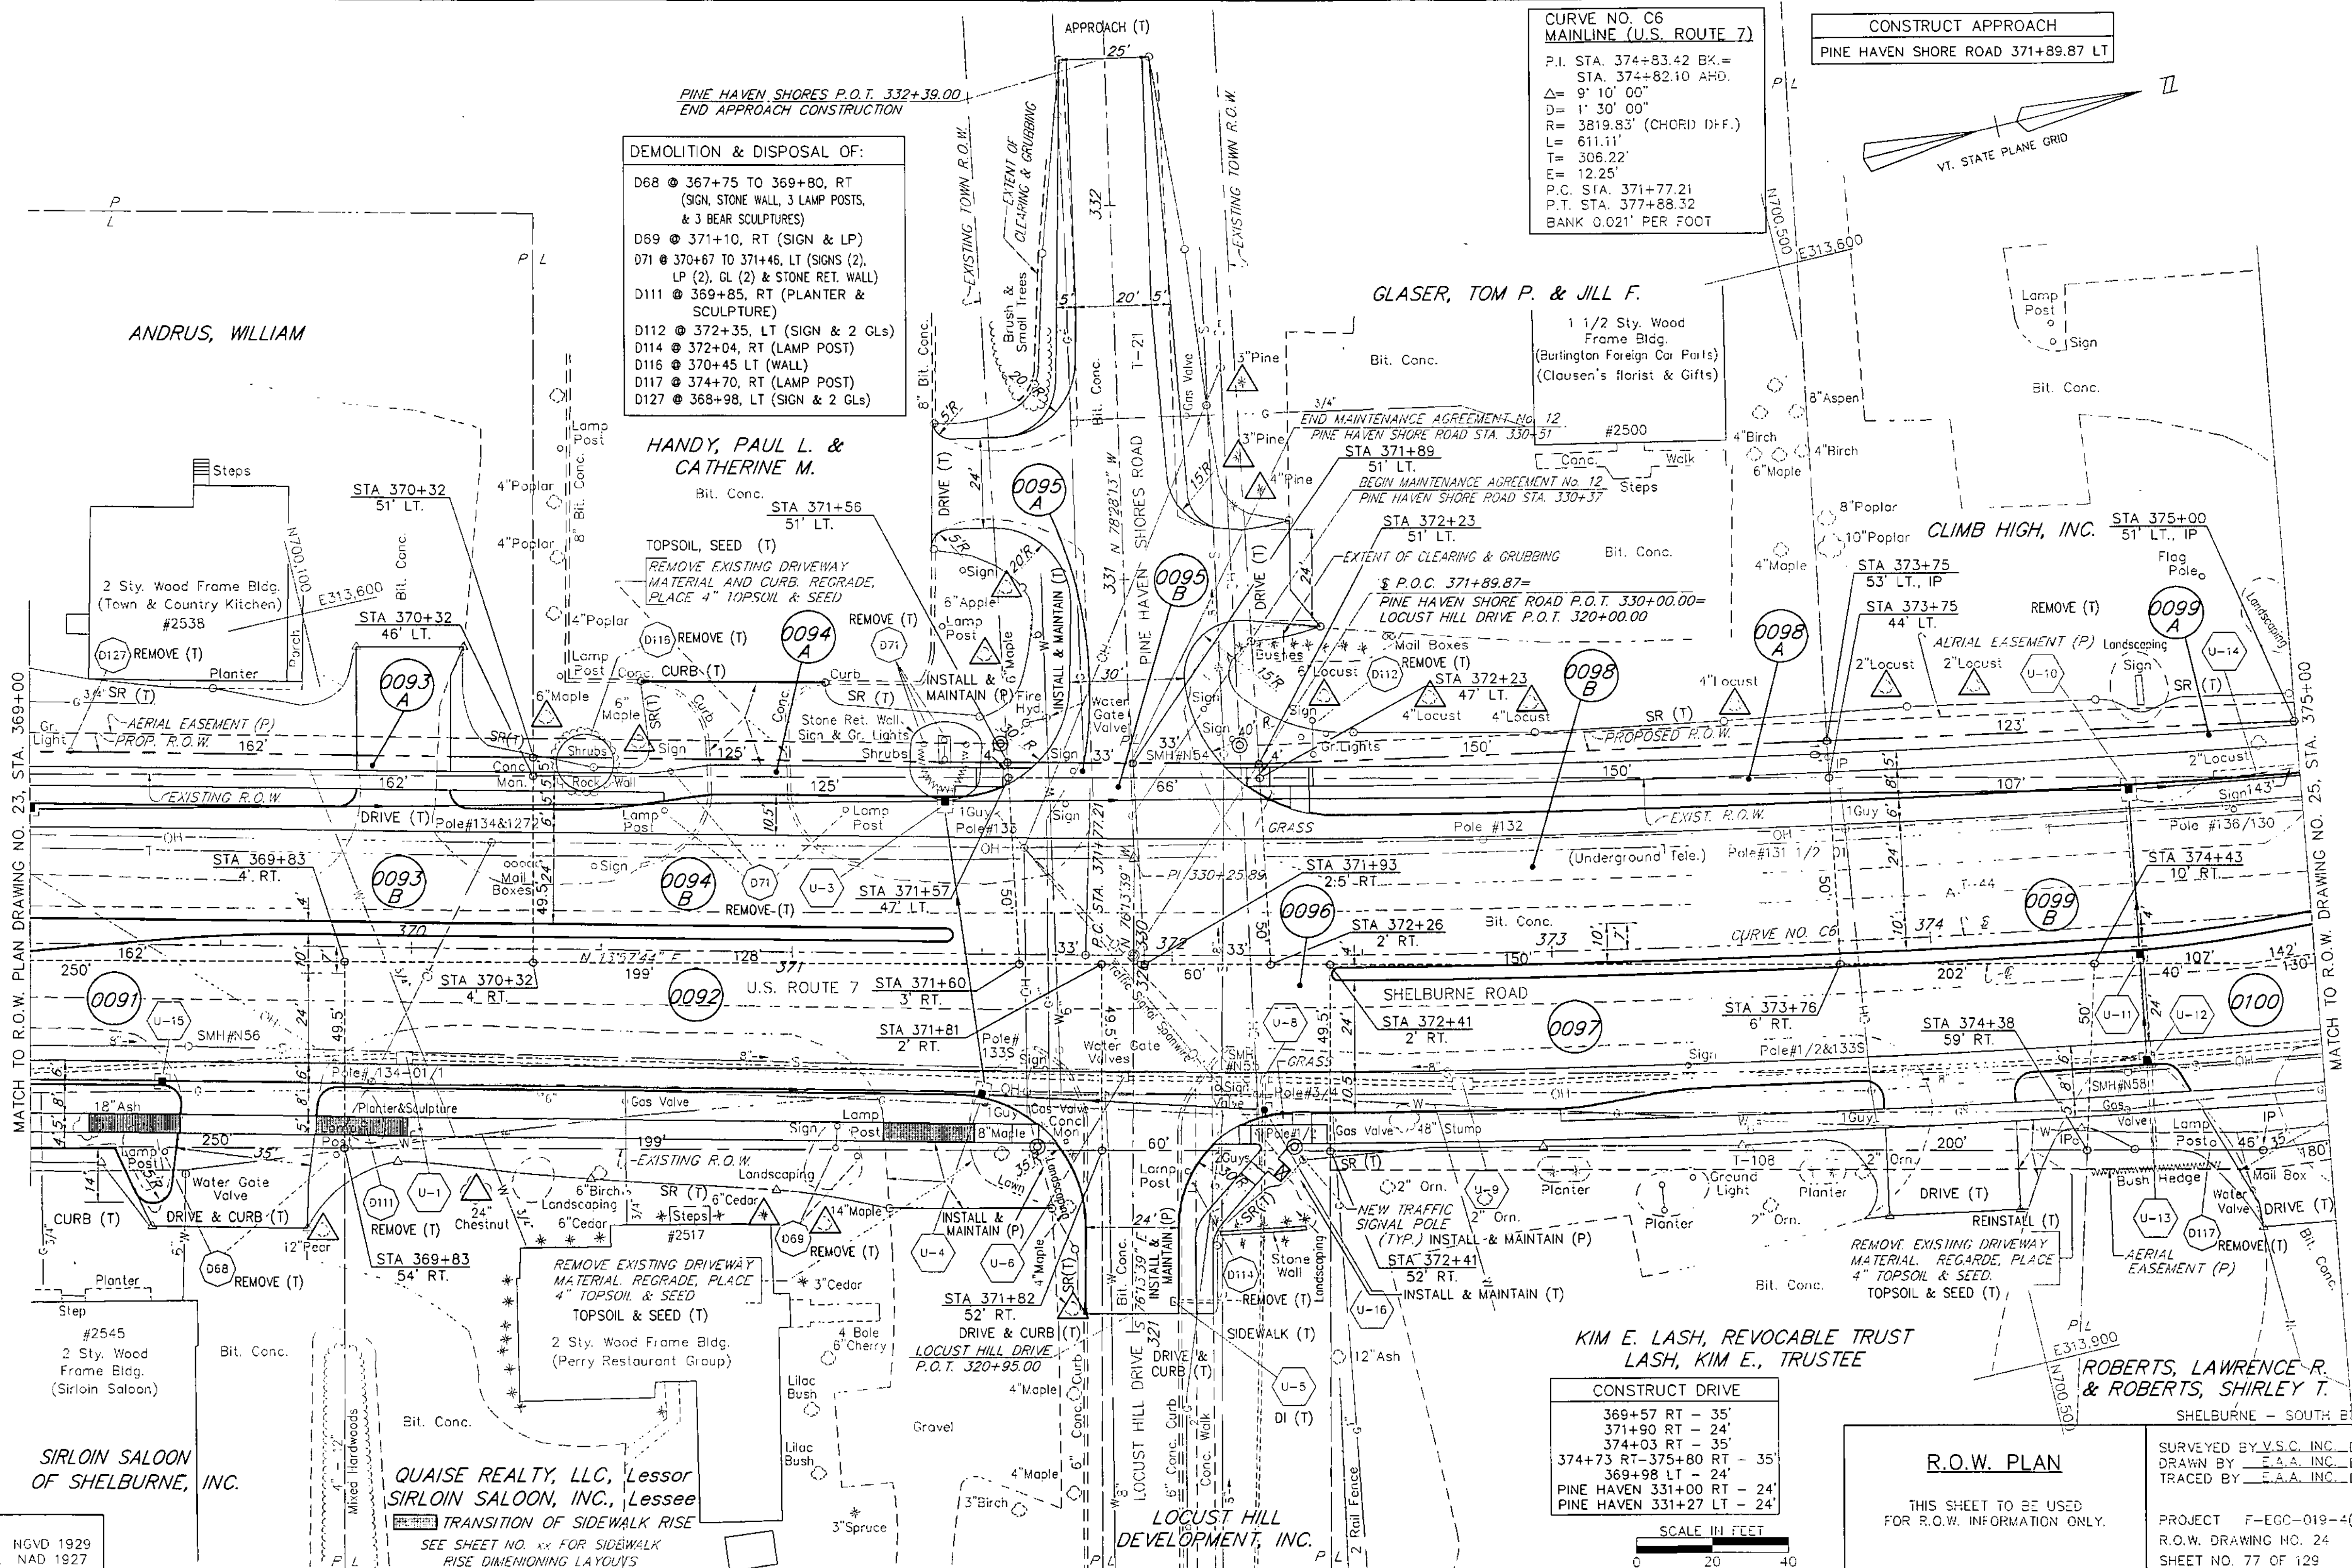

MATCH TO R.O.W. PLAN DRAWING NO. 23, STA. 369+00


MATCH TO R.O.W. DRAWING NO. 25, STA. 375+00

DATUM
VERTICAL NGVD 1929
HORIZONTAL NAD 1927

QUAISE REALTY, LLC, Lessor
SIRLOIN SALOON, INC., Lessee
TRANSITION OF SIDEWALK RISE
SEE SHEET NO. XX FOR SIDEWALK
RISE DIMENSIONING LAYOUTS

CONSTRUCT DRIVE

369+57 RT - 35'
371+90 RT - 24'
374+03 RT - 35'
374+73 RT - 375+80 RT - 35'
369+98 LT - 24'
PINE HAVEN 331+00 RT - 24'
PINE HAVEN 331+27 LT - 24'

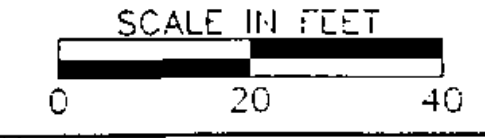

R.O.W. PLAN
 THIS SHEET TO BE USED
 FOR R.O.W. INFORMATION ONLY.

SURVEYED BY V.S.C. INC. DATE _____
 DRAWN BY E.A.A. INC. DATE _____
 TRACED BY E.A.A. INC. DATE _____

PROJECT F-EGC-019-4(19)
 R.O.W. DRAWING NO. 24
 SHEET NO. 77 OF 129 63 OF 537