


	TOTAL PERMANENT IMPACT TO WETLAND	TOTAL TEMPORARY IMPACT TO WETLAND	TOTAL PERMANENT IMPACT TO WETLAND BUFFER	TOTAL TEMPORARY IMPACT TO WETLAND BUFFER	TOTAL PERMANENT FILL IN WATERBODIES BELOW O.H.W. (CY)	TOTAL TEMPORARY FILL IN WATERBODIES BELOW O.H.W. (CY)
WETLAND C	1.27 AC. (CLASS III)	0	0	0	0	0
WETLAND D	0.25 AC. (CLASS III)	0	0	0	0	0

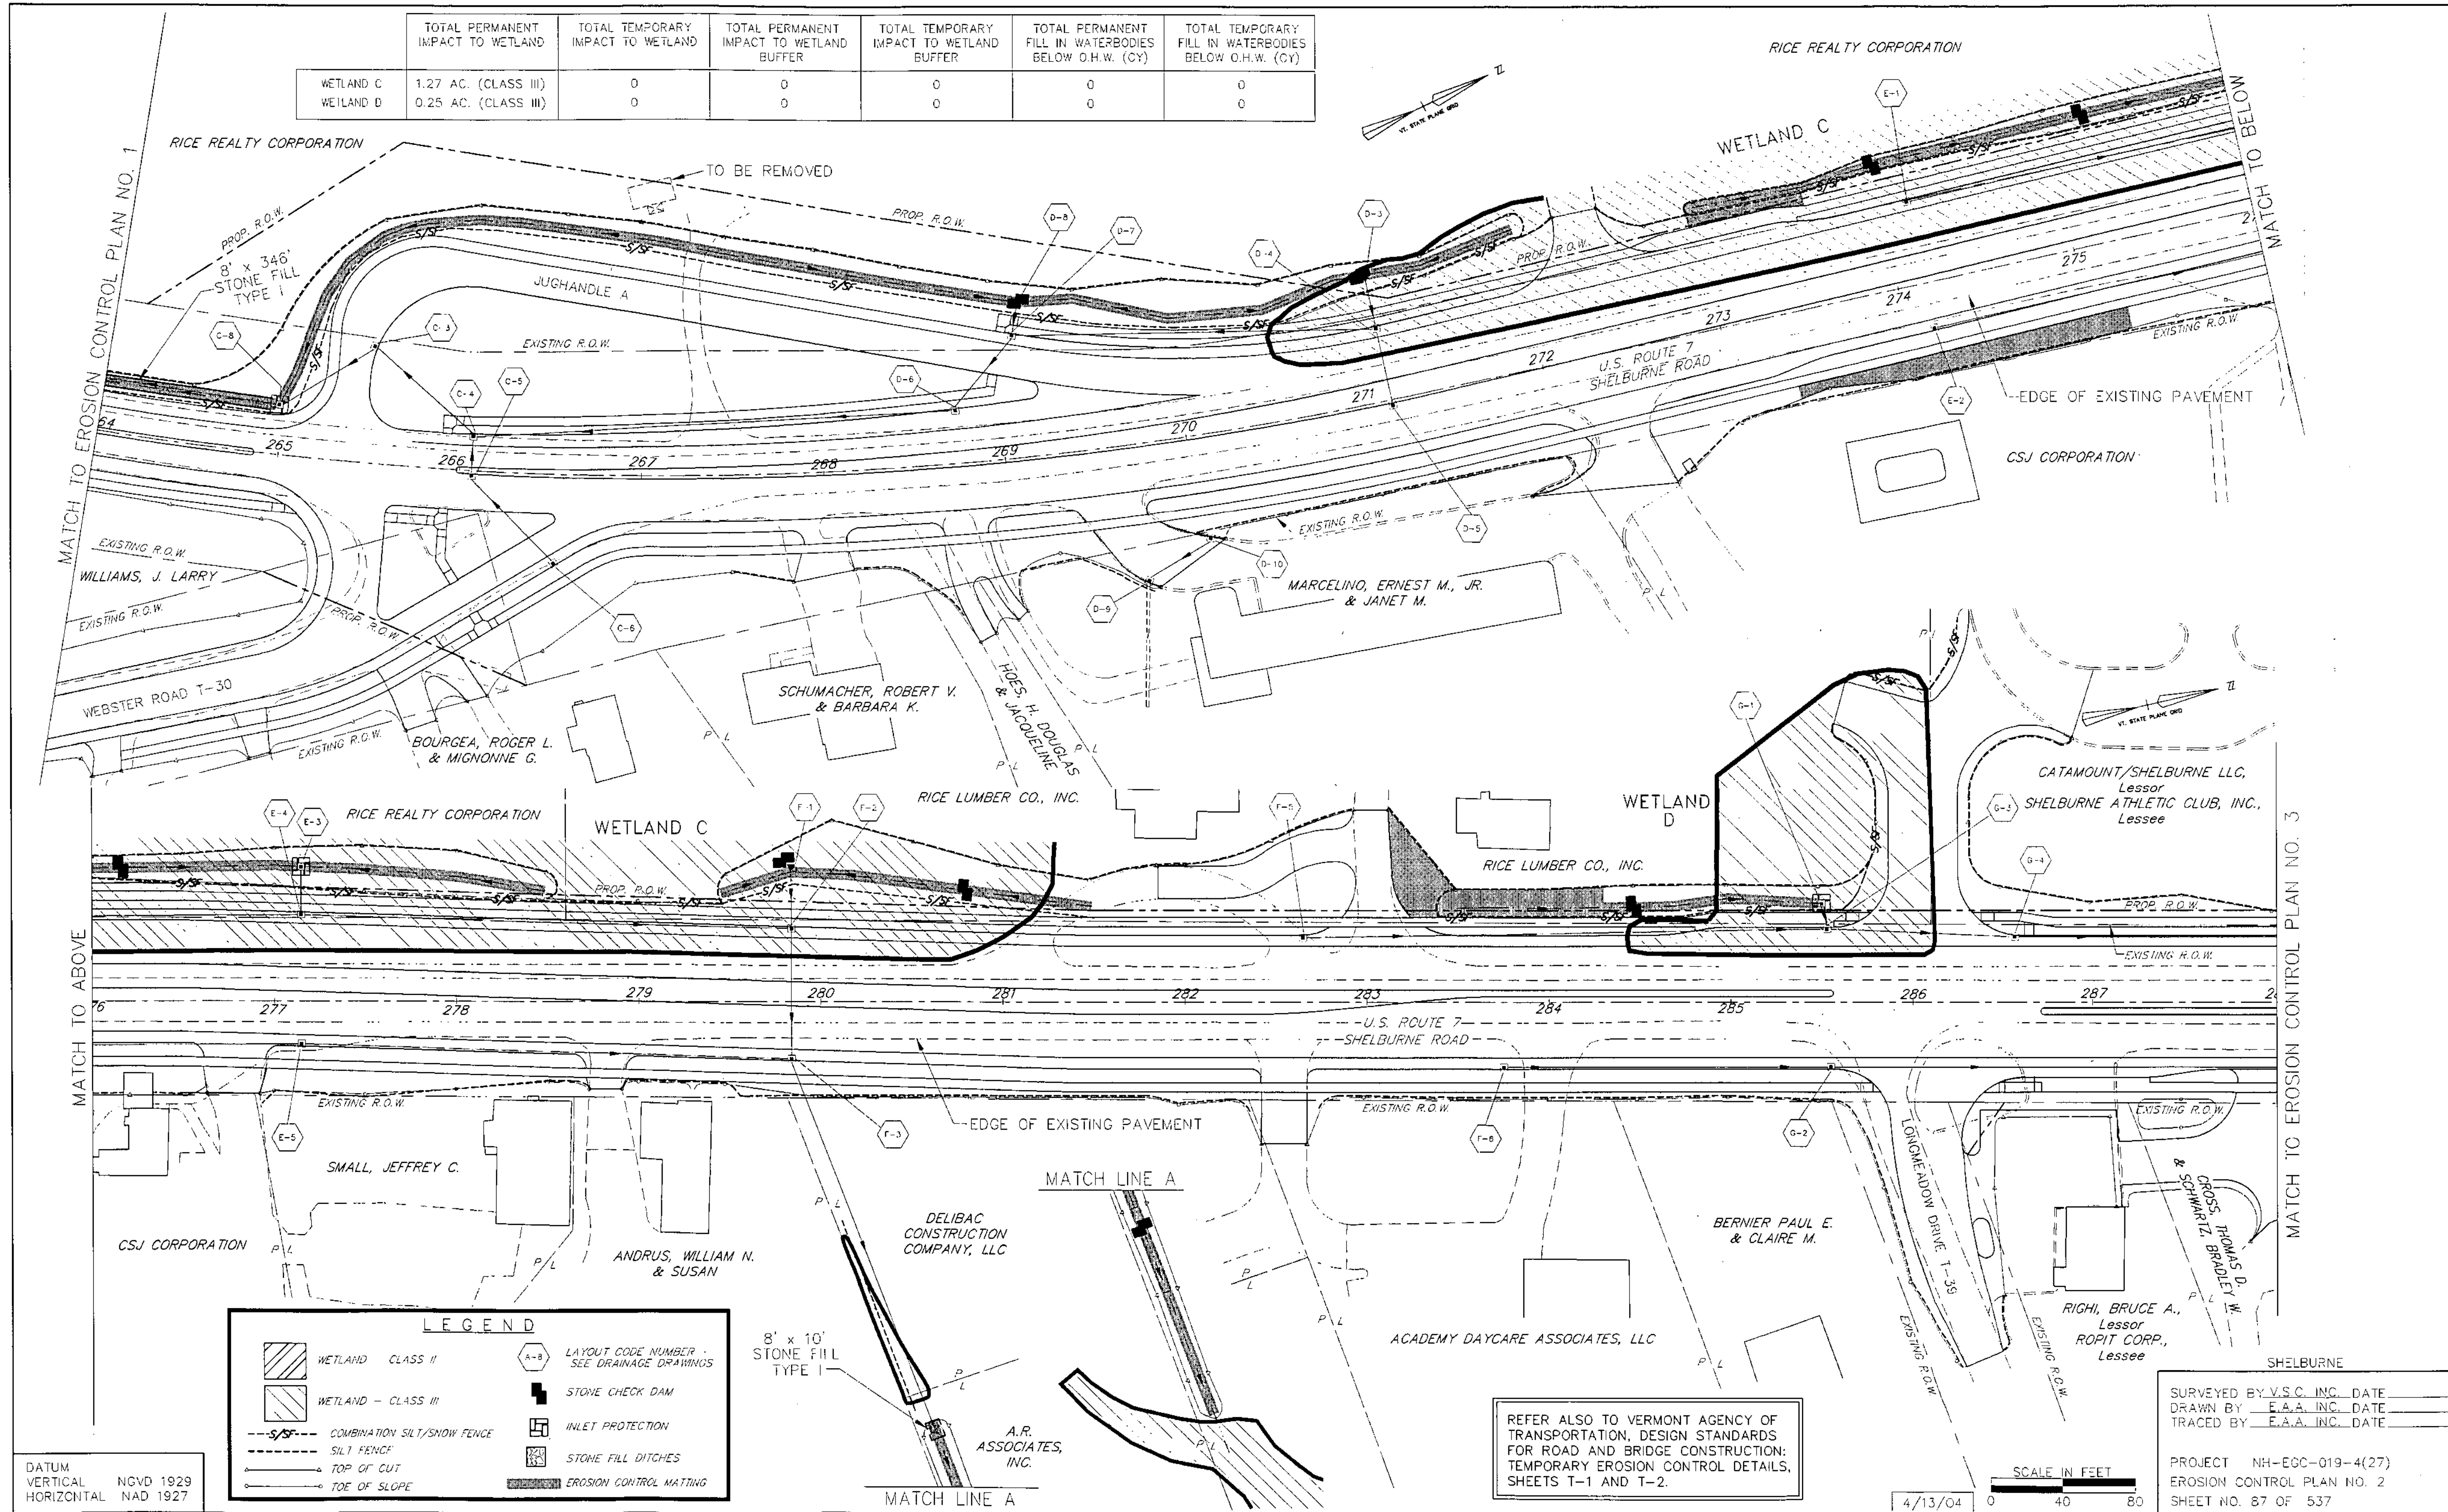

LEGEND

	WETLAND CLASS II		LAYOUT CODE NUMBER - SEE DRAINAGE DRAWINGS
	WETLAND - CLASS III		STONE CHECK DAM
	COMBINATION SILT/SNOW FENCE		INLET PROTECTION
	SILT FENCE		STONE FILL DITCHES
	TOP OF CUT		EROSION CONTROL MATTING
	TOE OF SLOPE		

REFER ALSO TO VERMONT AGENCY OF TRANSPORTATION, DESIGN STANDARDS FOR ROAD AND BRIDGE CONSTRUCTION: TEMPORARY EROSION CONTROL DETAILS, SHEETS T-1 AND T-2.

SURVEYED BY V.S.C. INC. DATE _____
 DRAWN BY E.A.A. INC. DATE _____
 TRACED BY E.A.A. INC. DATE _____

PROJECT NH-EGC-019-4(27)
 EROSION CONTROL PLAN NO. 2
 SHEET NO. 87 OF 537

DATUM
 VERTICAL NGVD 1929
 HORIZONTAL NAD 1927

SCALE IN FEET
 0 40 80
 4/13/04