


CATAMOUNT/SHELBURNE LLC

HANDY, GABRIEL G.
HANDY, DIANE L.
GABRIEL G. HANDY, Trustee of the
DDH-GSH REVOCABLE TRUST

SPENCER, ROBERT R.
& CYNTHIA G.B.

MATCH TO PLAN DRAWING NO. 6, STA. 291+00

MATCH TO PLAN DRAWING NO. 8, STA. 297+00

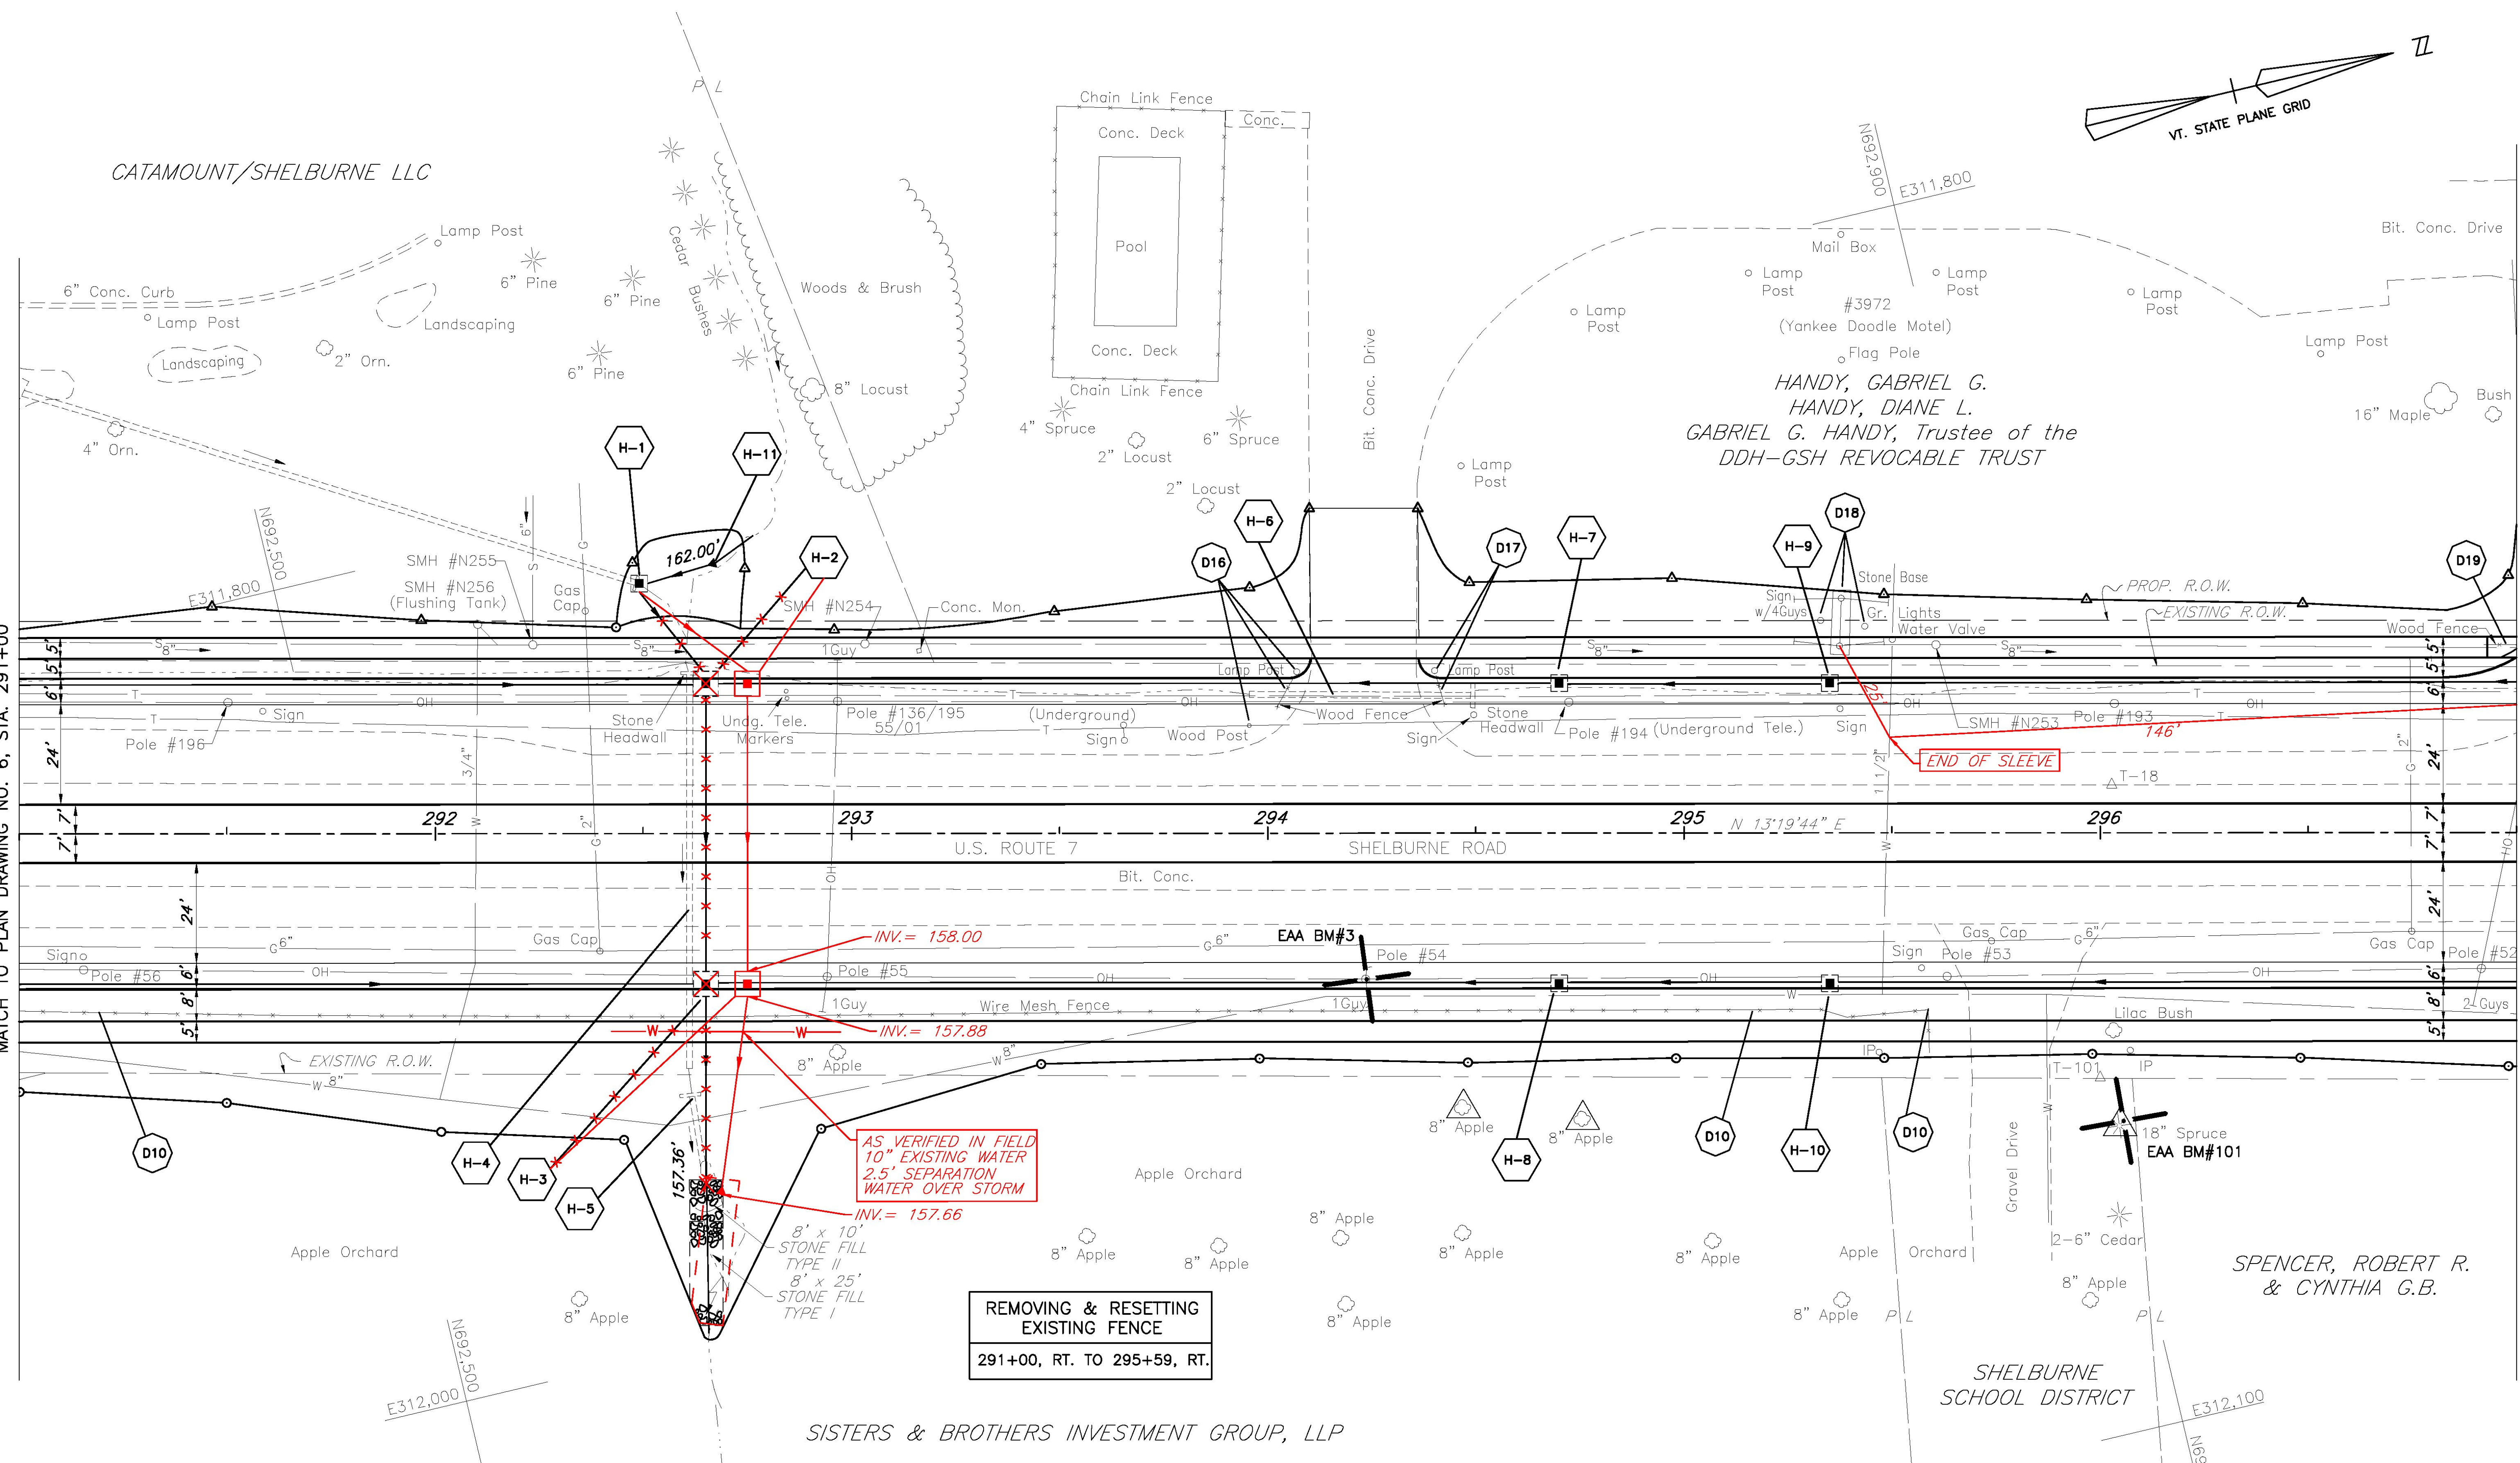

NOTES:
1. UNDERGROUND AND AERIAL UTILITY LOCATIONS ARE PLOTTED BASED ON THE BEST AVAILABLE INFORMATION. LOCATIONS SHOULD BE VERIFIED BY THE CONTRACTOR BEFORE WORK.
2. SEE PLAN NOTES DRAWING NO. 1 FOR PLAN NOTES AND GENERAL NOTES.

RECORD DRAWING REVISIONS

NO.	DATE	DESCRIPTION
1.	7/24/09	FIELD MARK UPS ADDED TO THE PLANS

PORTLAND CEMENT CONCRETE SIDEWALK - 8"	294+04 - 294+44 LT
CONSTRUCT DRIVE	294+24 LT - 26'

DEMOLITION & DISPOSAL OF:

- D10 @ 289+36, RT TO 295+60, RT (FENCE)
- D16 @ 294+04, LT (LP & FENCE)
- D17 @ 294+44, LT (LP & FENCE)
- D18 @ 295+40, LT (SIGN, 4 GUY WIRES, STONE BASE & 2 GLs) *
- D19 @ 297+00, LT (FENCE & LP)


* - REMOVED BY OTHERS AS OF JAN. 2004

CONSTRUCT SIDEWALK RAMP	TYPE
297+00, LT	1

PORTLAND CEMENT CONCRETE SIDEWALK - 5"	291+00 - 297+00 RT
	291+00 - 294+04 LT
	294+44 - 296+93 LT

DATUM
VERTICAL NGVD 1929
HORIZONTAL NAD 1927

FOR PROFILE SEE PROFILE DRAWING NO. 8 7/20/04

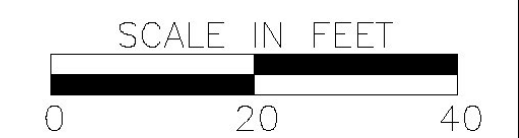

SHELBURNE

SURVEYED BY V.S.C. INC. DATE _____
DRAWN BY E.A.A. INC. DATE _____
TRACED BY E.A.A. INC. DATE _____

PROJECT NH-EGC-019-4(27)
PLAN DRAWING NO. 7
SHEET NO. 110 OF 537