

MATCH TO PLAN DRAWING NO. 9, STA. 309+00

MATCH TO PLAN DRAWING NO. 11, STA. 315+00

**REMOVING & RESETTING EXISTING FENCE**  
309+48, RT. TO 315+00, RT.

PORTLAND CEMENT CONCRETE SIDEWALK - 5'	
309+20 - 310+55	LT
312+06 - 315+00	LT
309+00 - 309+04	RT
309+34 - 311+83	RT
312+13 - 315+00	RT

PORTLAND CEMENT CONCRETE SIDEWALK - 8'	
309+00 - 309+20	LT
309+04 - 309+34	RT
311+83 - 312+13	RT

CONSTRUCT SIDEWALK RAMP	TYPE
311+46, LT	1
312+10, LT	1

CONSTRUCT DRIVE	
309+04	LT - 18'
311+98	RT - 16'
309+19	RT - 16' (GRAVEL)
311+81	LT - 30'
111+56	RT - 20'


PORTLAND CEMENT CONCRETE SIDEWALK - 5' (MEDIAN WIDTH 4-6 FT.)	
309+39 TO 311+31	
312+31 TO 314+47	

RECORD DRAWING REVISIONS		
NO.	DATE	DESCRIPTION
1.	7/24/09	FIELD MARK UPS ADDED TO THE PLANS

DEMOLITION & DISPOSAL OF:	
D31 @ 309+35, RT (SIGN) *	
D32 @ 311+57, LT (SIGN)	
D33 @ 313+04, LT (SIGN) *	
D34 @ 315+00, LT (SIGN & 2 GLs) *	
D105 @ 312+85, LT (STEPS TOWARDS ROAD) *	
* - REMOVED BY OTHERS AS OF JAN. 2004	

- NOTES:**
- UNDERGROUND AND AERIAL UTILITY LOCATIONS ARE PLOTTED BASED ON THE BEST AVAILABLE INFORMATION. LOCATIONS SHOULD BE VERIFIED BY THE CONTRACTOR BEFORE WORK.
  - SEE PLAN NOTES DRAWING NO. 1 FOR PLAN NOTES AND GENERAL NOTES.

DATUM  
VERTICAL NGVD 1929  
HORIZONTAL NAD 1927

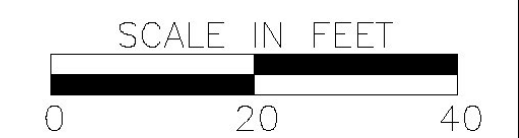

FOR PROFILE SEE PROFILE DRAWING NO. 11 7/20/04

SHELburne  
SURVEYED BY V.S.C. INC. DATE \_\_\_\_\_  
DRAWN BY E.A.A. INC. DATE \_\_\_\_\_  
TRACED BY E.A.A. INC. DATE \_\_\_\_\_  
PROJECT NH-EGC-019-4(27)  
PLAN DRAWING NO. 10  
SHEET NO. 113 OF 537

COATES, WILLIAM, III  
& CONSTANCE B.