
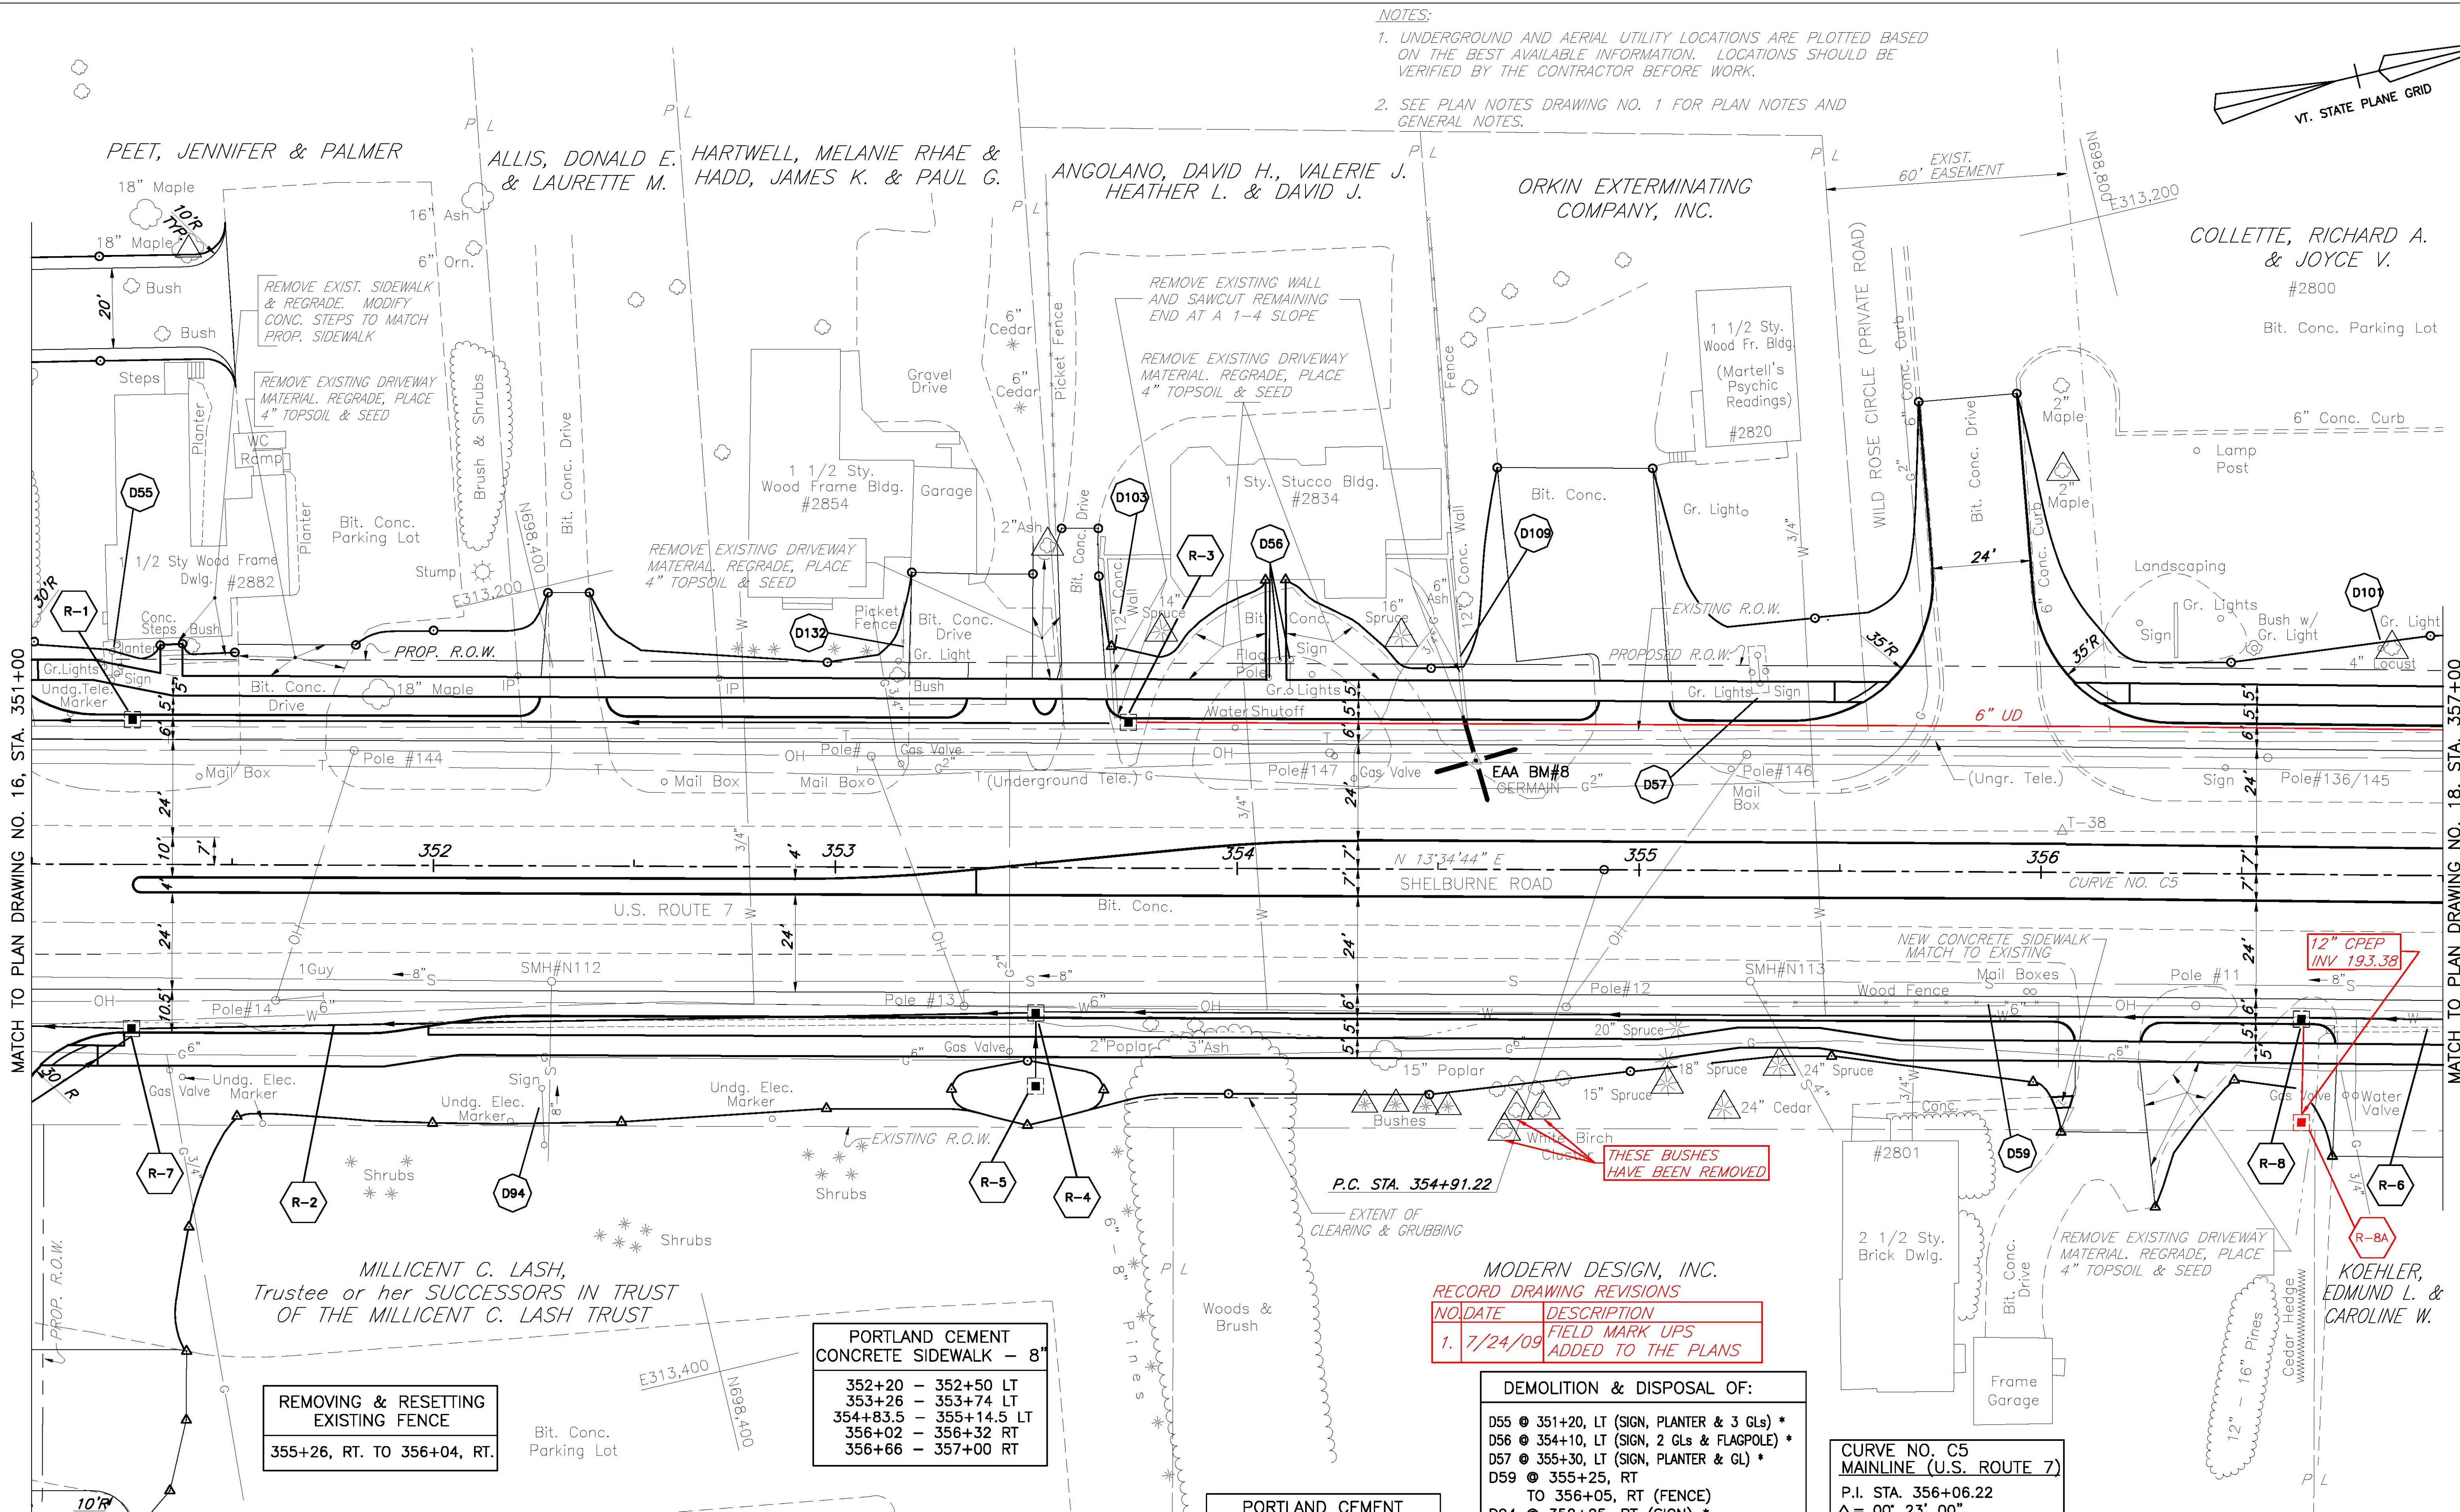


**NOTES:**

1. UNDERGROUND AND AERIAL UTILITY LOCATIONS ARE PLOTTED BASED ON THE BEST AVAILABLE INFORMATION. LOCATIONS SHOULD BE VERIFIED BY THE CONTRACTOR BEFORE WORK.
2. SEE PLAN NOTES DRAWING NO. 1 FOR PLAN NOTES AND GENERAL NOTES.

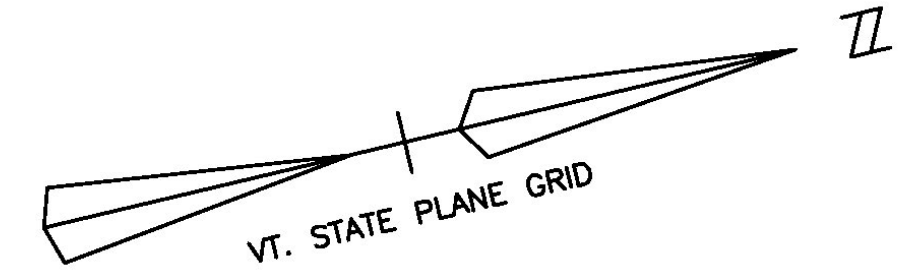

MATCH TO PLAN DRAWING NO. 16, STA. 351+00

MATCH TO PLAN DRAWING NO. 18, STA. 357+00

MILLICENT C. LASH,  
Trustee or her SUCCESSORS IN TRUST  
OF THE MILLICENT C. LASH TRUST

REMOVING & RESETTING  
EXISTING FENCE  
355+26, RT. TO 356+04, RT.

PORTLAND CEMENT CONCRETE SIDEWALK - 8"	
352+20 - 352+50	LT
353+26 - 353+74	LT
354+83.5 - 355+14.5	LT
356+02 - 356+32	RT
356+66 - 357+00	RT

CONSTRUCT SIDEWALK RAMP		
TYPE		
351+09, RT	1	
355+55, LT	1	
356+15, LT	1	

CONSTRUCT DRIVE	
356+17 RT	- 16'
356+91 RT	- 35'
352+35 LT	- 16'
353+41 LT	- 16'
353+61 LT	- 12'
354+99 LT	- 17'
355+85 LT	- 24'

PORTLAND CEMENT CONCRETE SIDEWALK - 5" (MEDIAN WIDTH 4-6 FT.)	
351+25 TO 353+35	

PORTLAND CEMENT CONCRETE SIDEWALK - 5"	
351+06 - 356+02	RT
356+32 - 356+66	RT
351+00 - 352+20	LT
352+50 - 353+26	LT
353+74 - 354+83.5	LT
355+14.5 - 355+59	LT
356+11 - 357+00	LT

MODERN DESIGN, INC.  
RECORD DRAWING REVISIONS

NO.	DATE	DESCRIPTION
1.	7/24/09	FIELD MARK UPS ADDED TO THE PLANS

DEMOLITION & DISPOSAL OF:

- D55 @ 351+20, LT (SIGN, PLANTER & 3 GLs) \*
- D56 @ 354+10, LT (SIGN, 2 GLs & FLAGPOLE) \*
- D57 @ 355+30, LT (SIGN, PLANTER & GL) \*
- D59 @ 355+25, RT
- TO 356+05, RT (FENCE)
- D94 @ 352+25, RT (SIGN) \*
- D103 @ 353+70, LT (WALL)
- D109 @ 354+55, LT (WALL)
- D132 @ 353+15, LT (FENCE & GL)
- D101 @ 356+80, LT
- TO 358+30 LT (5 GLs)

\* - REMOVED BY OTHERS AS OF JAN. 2004


CURVE NO. C5  
MAINLINE (U.S. ROUTE 7)

P.I. STA. 356+06.22  
 $\Delta = 00^\circ 23' 00''$   
 $D = 00^\circ 10' 00''$   
 $R = 34377.48'$  (CHORD DEF.)  
 $L = 230.00'$   
 $T = 115.00'$   
 $E = 0.19'$   
 P.C. STA. 354+91.22  
 P.T. STA. 357+21.22

SHELBURNE

SURVEYED BY V.S.C. INC. DATE \_\_\_\_\_  
 DRAWN BY E.A.A. INC. DATE \_\_\_\_\_  
 TRACED BY E.A.A. INC. DATE \_\_\_\_\_

PROJECT NH-EGC-019-4(27)  
 PLAN DRAWING NO. 17  
 SHEET NO. 120 OF 537

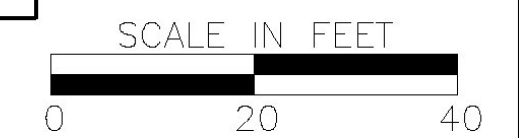

FOR PROFILE SEE PROFILE DRAWING NO. 19

7/20/04

DATUM  
 VERTICAL NGVD 1929  
 HORIZONTAL NAD 1927