

PORTLAND CEMENT CONCRETE SIDEWALK - 5"	
369+00 - 369+33	RT
369+82 - 371+67	RT
372+14 - 373+79	RT
374+28 - 374+60	RT
369+00 - 369+79	LT
370+17 - 371+58	LT
372+17 - 375+00	LT

PORTLAND CEMENT CONCRETE SIDEWALK - 8"	
369+33 - 369+82	RT
373+79 - 374+28	RT
374+60 - 375+00	RT
369+79 - 370+17	LT

CONSTRUCT APPROACH	
PINE HAVEN SHORE ROAD	371+89.87 LT


DEMOLITION & DISPOSAL OF:	
D68	@ 367+75 TO 369+80, RT (SIGN*, STONE WALL*, 3 LAMP POSTS, & 3 BEAR SCULPTURES*)
D69	@ 371+10, RT (SIGN & LP)
D71	@ 370+67 TO 371+46, LT (SIGNS (2), * LP (2)*, GL (2)* & STONE RET. WALL)
D111	@ 369+85, RT (PLANTER & SCULPTURE) *
D112	@ 372+35, LT (SIGN & 2 GLs)
D114	@ 372+04, RT (LAMP POST)
D116	@ 370+45 LT (WALL)
D117	@ 374+70, RT (LAMP POST)
D127	@ 368+98, LT (SIGN & 2 GLs) *

* - REMOVED BY OTHERS AS OF JAN. 2004

PORTLAND CEMENT CONCRETE SIDEWALK - 5" (MEDIAN WIDTH 4-6 FT.)	
369+28 TO 371+43	
372+42 TO 375+00	

CURVE NO. C6 MAINLINE (U.S. ROUTE 7)	
P.I. STA. 374+83.42	BK.=
STA. 374+82.10	AHD.
$\Delta = 9^\circ 10' 00''$	
$D = 1^\circ 30' 00''$	
$R = 3819.83'$	(CHORD DEF.)
$L = 611.11'$	
$T = 306.22'$	
$E = 12.25'$	
P.C. STA. 371+77.21	
P.T. STA. 377+88.32	
BANK 0.021' PER FOOT	

- NOTES:
- UNDERGROUND AND AERIAL UTILITY LOCATIONS ARE PLOTTED BASED ON THE BEST AVAILABLE INFORMATION. LOCATIONS SHOULD BE VERIFIED BY THE CONTRACTOR BEFORE WORK.
 - SEE PLAN NOTES DRAWING NO. 1 FOR PLAN NOTES AND GENERAL NOTES.

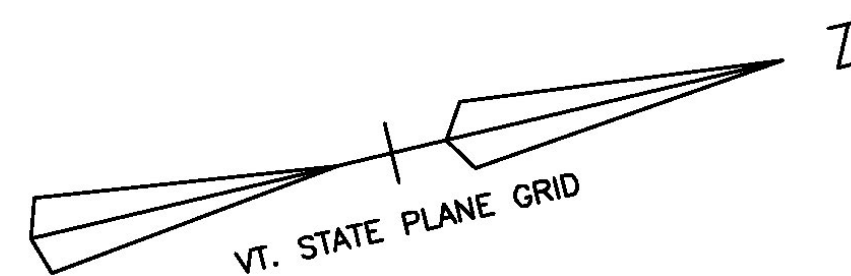

MATCH TO PLAN DRAWING NO. 19, STA. 369+00

MATCH TO PLAN DRAWING NO. 21, STA. 375+00

RECORD DRAWING REVISIONS		
NO.	DATE	DESCRIPTION
1.	7/24/09	FIELD MARK UPS ADDED TO THE PLANS

DATUM
VERTICAL NGVD 1929
HORIZONTAL NAD 1927

CONSTRUCT DRIVE	
369+57	RT - 35'
371+90	RT - 24'
374+03	RT - 35'
374+86	RT - 38'
369+98	LT - 24'
PINE HAVEN 331+00	RT - 24'
PINE HAVEN 331+27	LT - 24'

CONSTRUCT SIDEWALK RAMP		TYPE
371+55,	LT	1
371+65,	RT	1
372+18,	RT	1
372+19,	LT	1
372+34,	RT	2
372+34,	LT	1

SURVEYED BY V.S.C. INC. DATE _____
DRAWN BY E.A.A. INC. DATE _____
TRACED BY E.A.A. INC. DATE _____

PROJECT NH-EGC-019-4(27)
PLAN DRAWING NO. 20
SHEET NO. 123 OF 537



FOR PROFILE SEE PROFILE DRAWING NO. 22

7/20/04

