
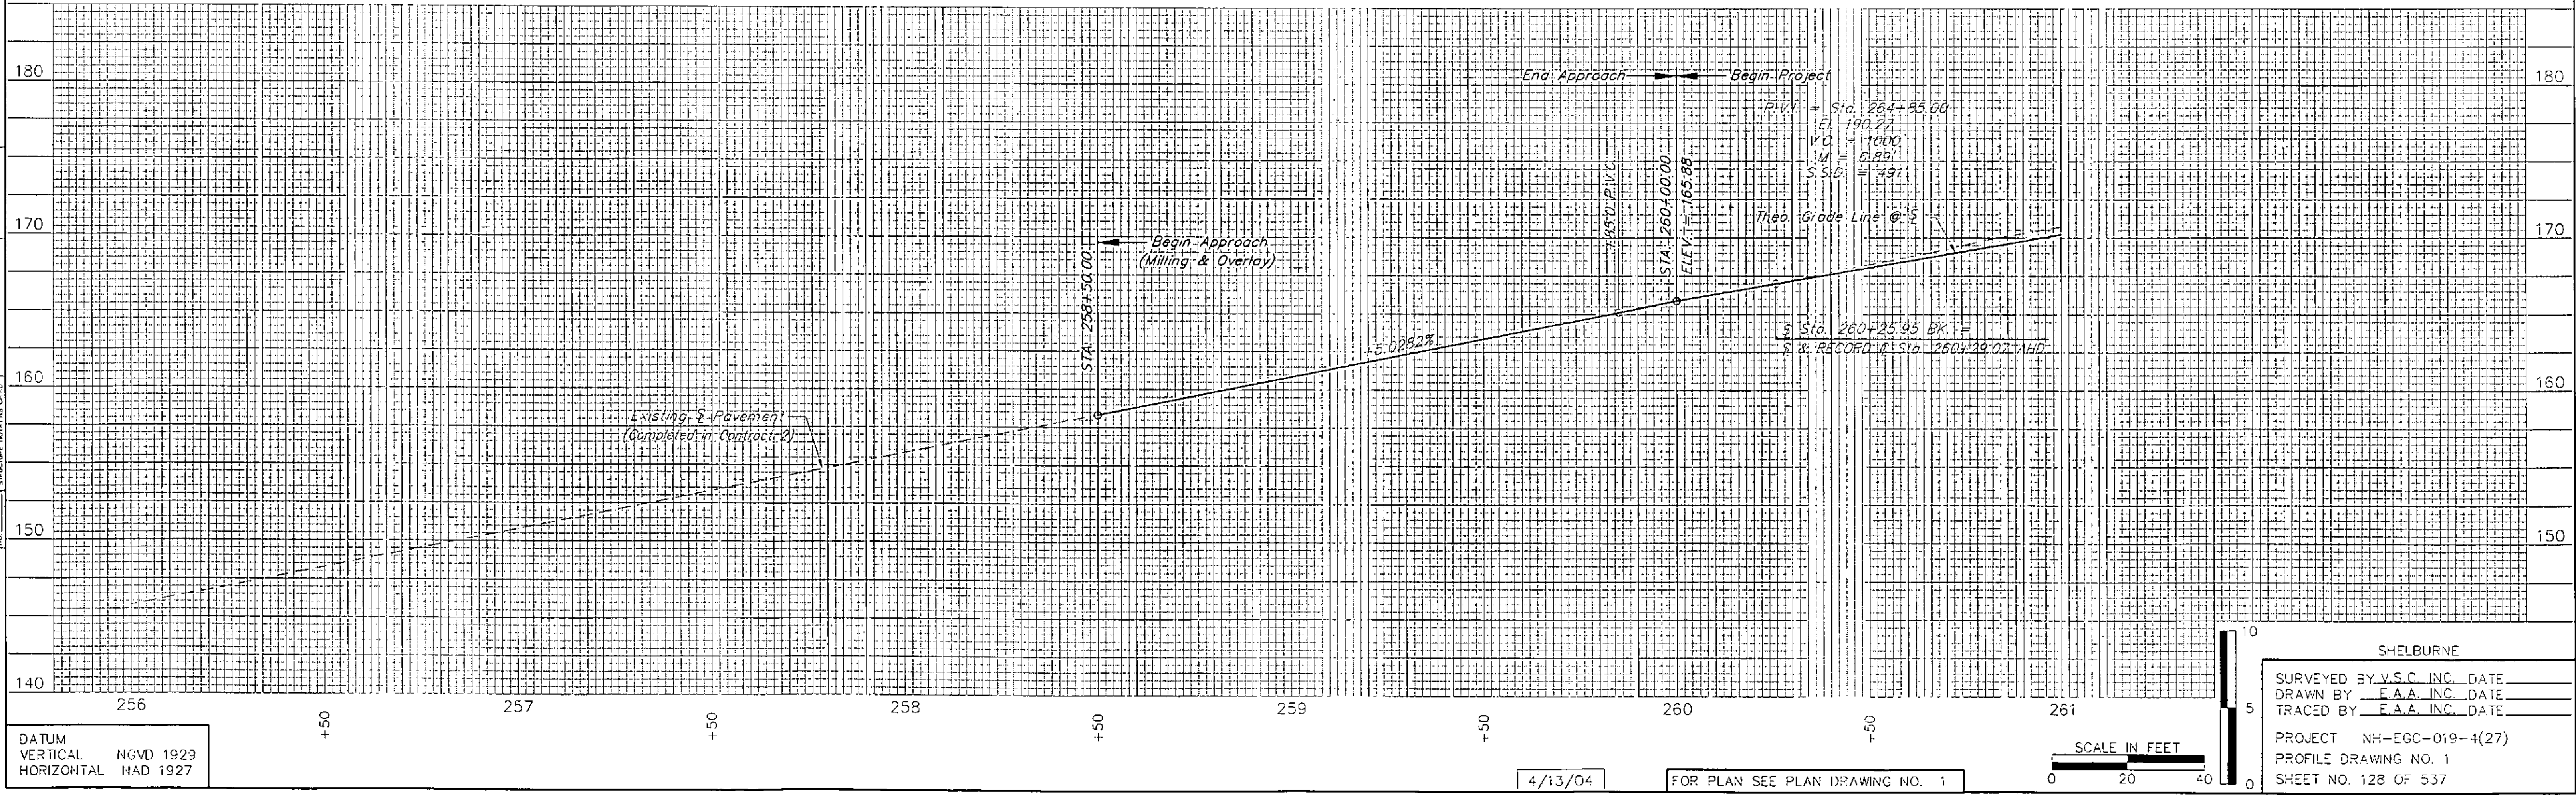



DATE
BY
PLAN
CHECKED BY
DATE
NOTE: SEE PLAN DRAWING NO. 1

DATE
BY
PROFILE
CHECKED BY
DATE
NOTE: SEE PLAN DRAWING NO. 1

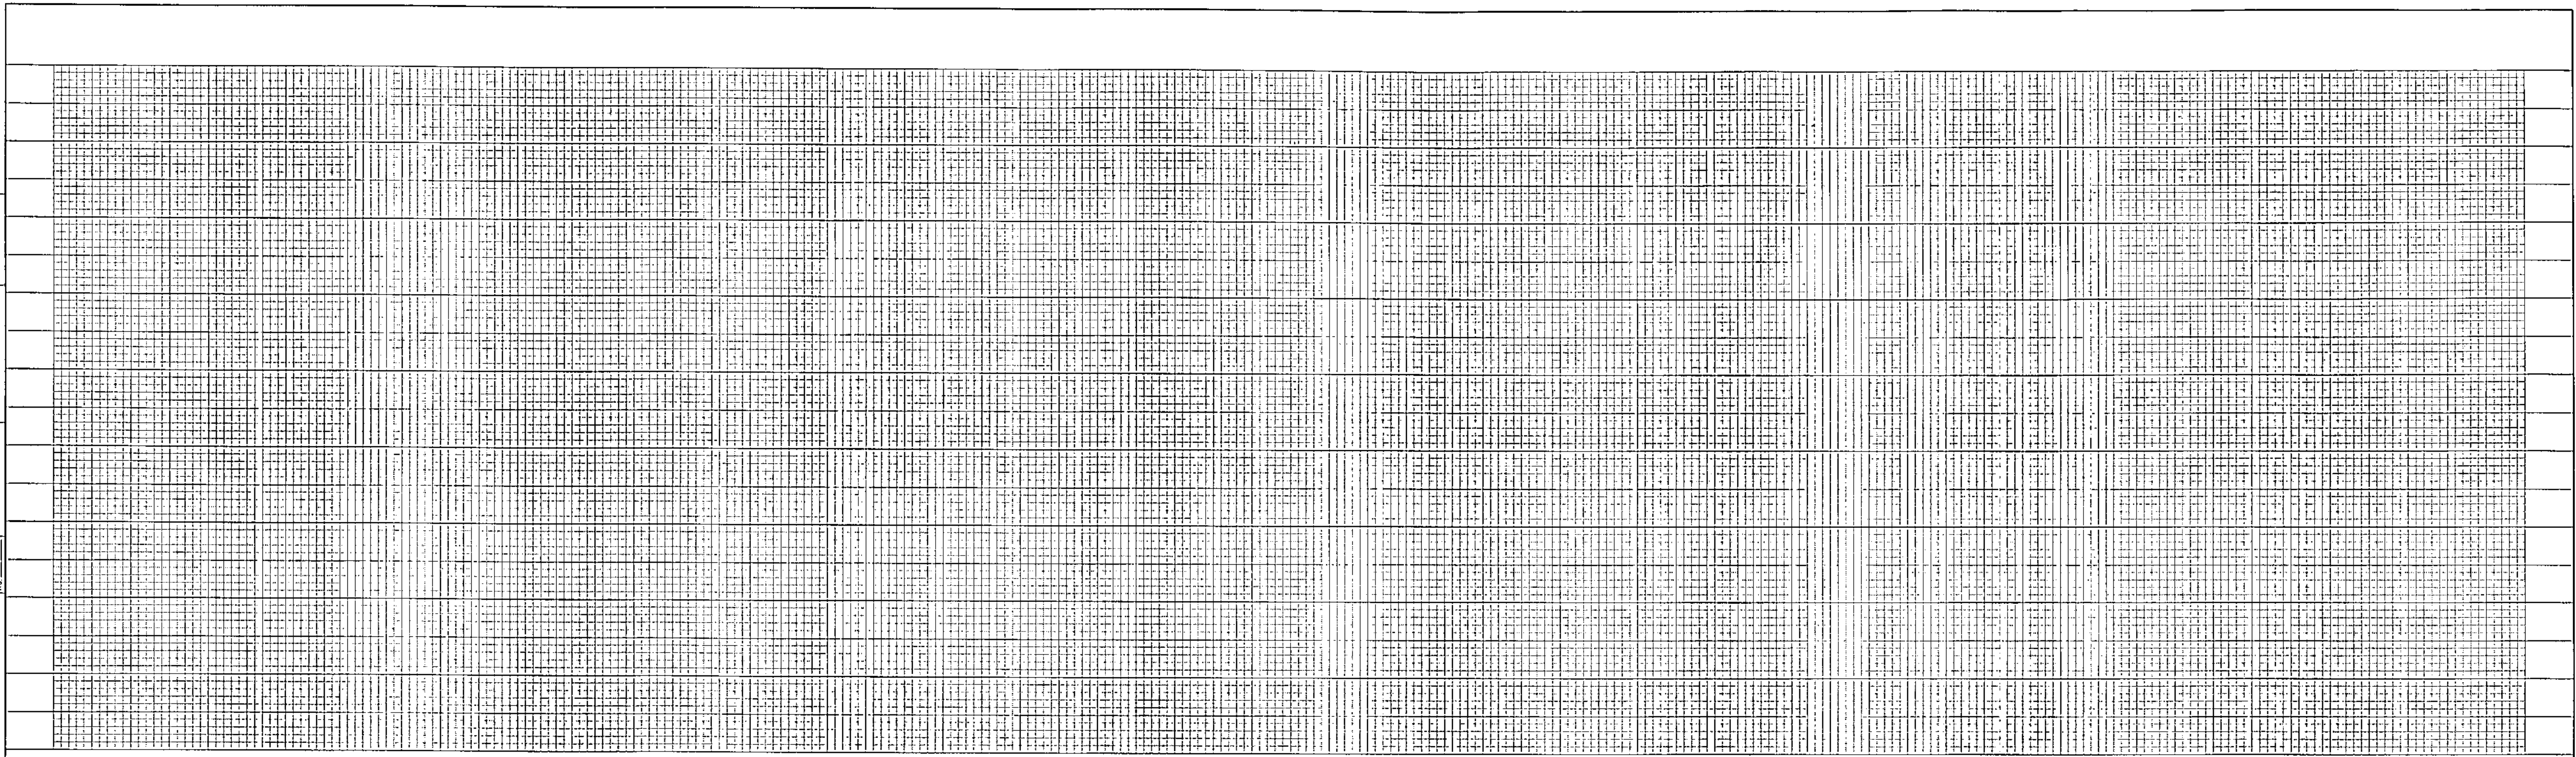

DATUM
VERTICAL NGVD 1929
HORIZONTAL HAD 1927

4/13/04 FOR PLAN SEE PLAN DRAWING NO. 1

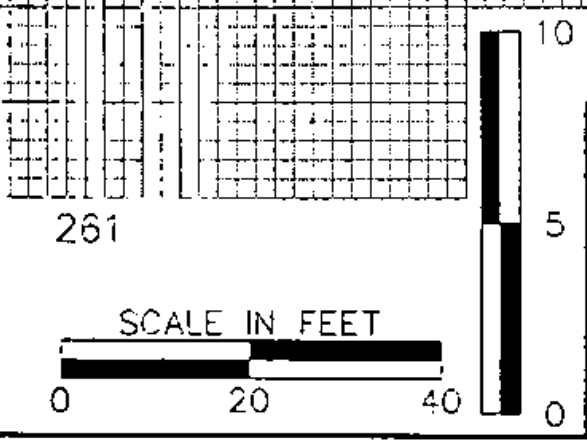

SHELburne
 SURVEYED BY V.S.C. INC. DATE _____
 DRAWN BY E.A.A. INC. DATE _____
 TRACED BY E.A.A. INC. DATE _____
 PROJECT NH-EGC-019-4(27)
 PROFILE DRAWING NO. 1
 SHEET NO. 128 OF 537