
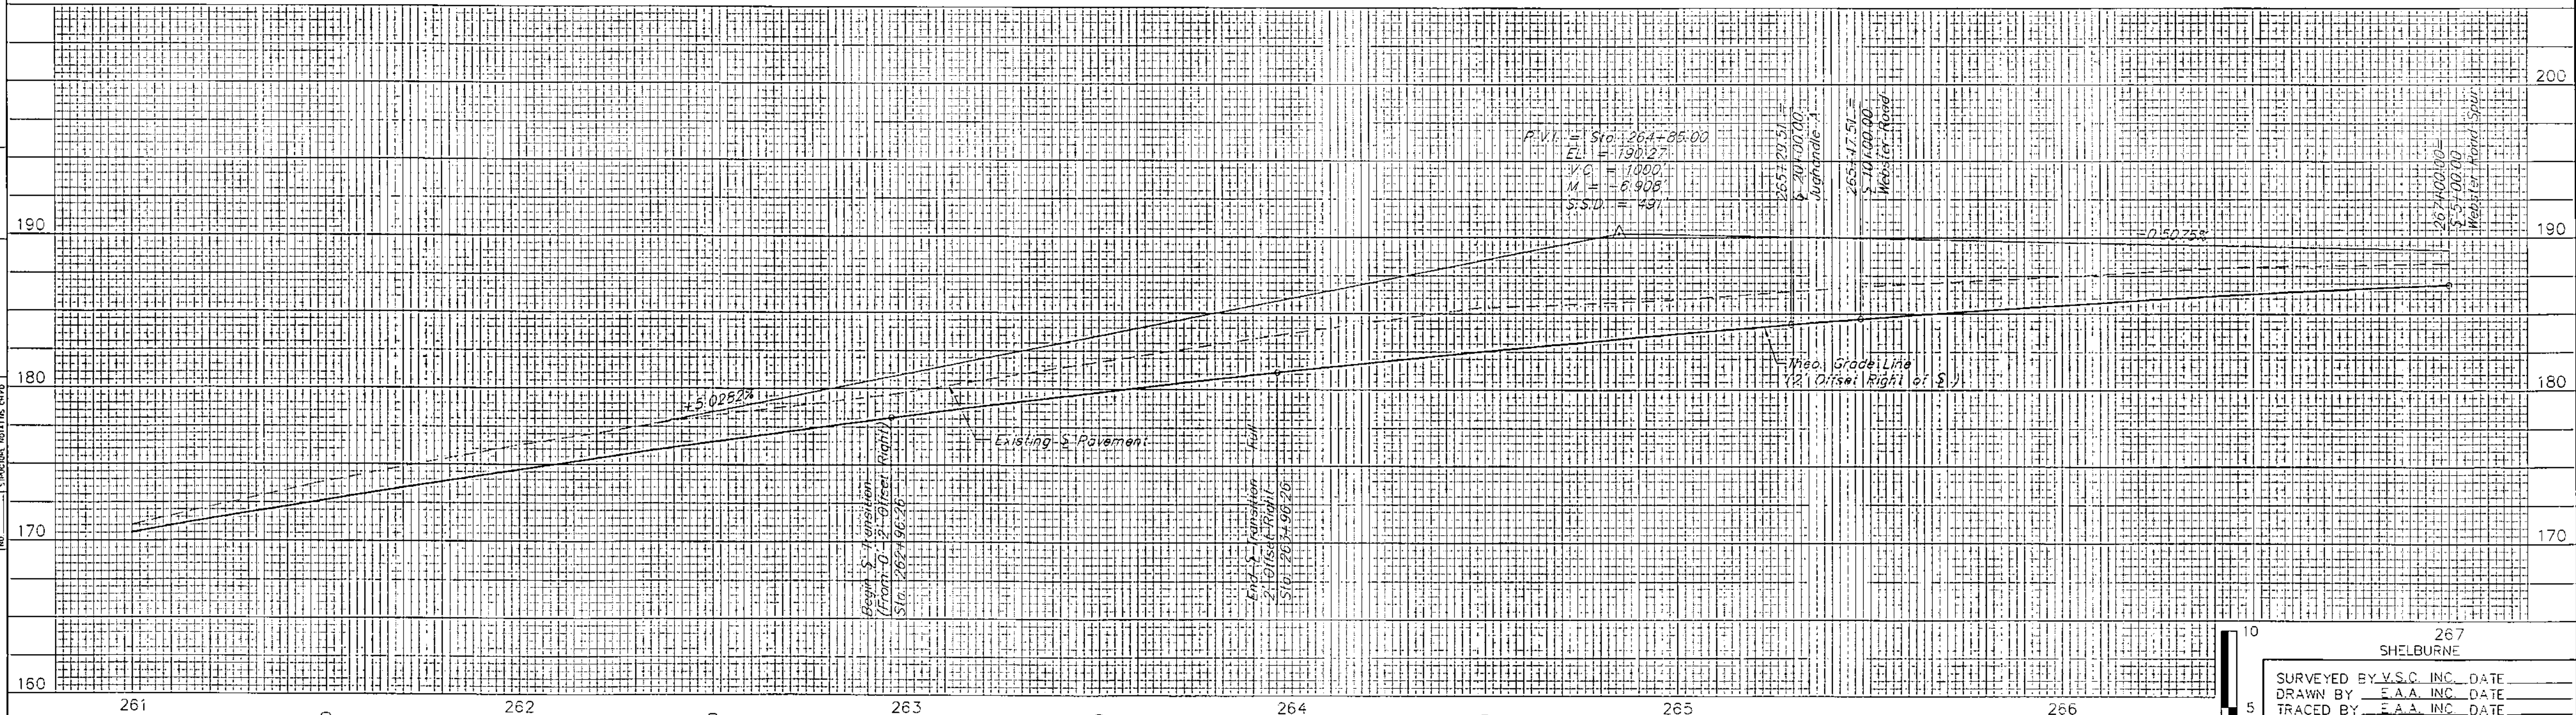



DATE _____
 BY _____
 PLAN
 SHEET NO. _____
 DATE _____
 BY _____

DATE _____
 BY _____
 PROFILE
 SHEET NO. _____
 DATE _____
 BY _____

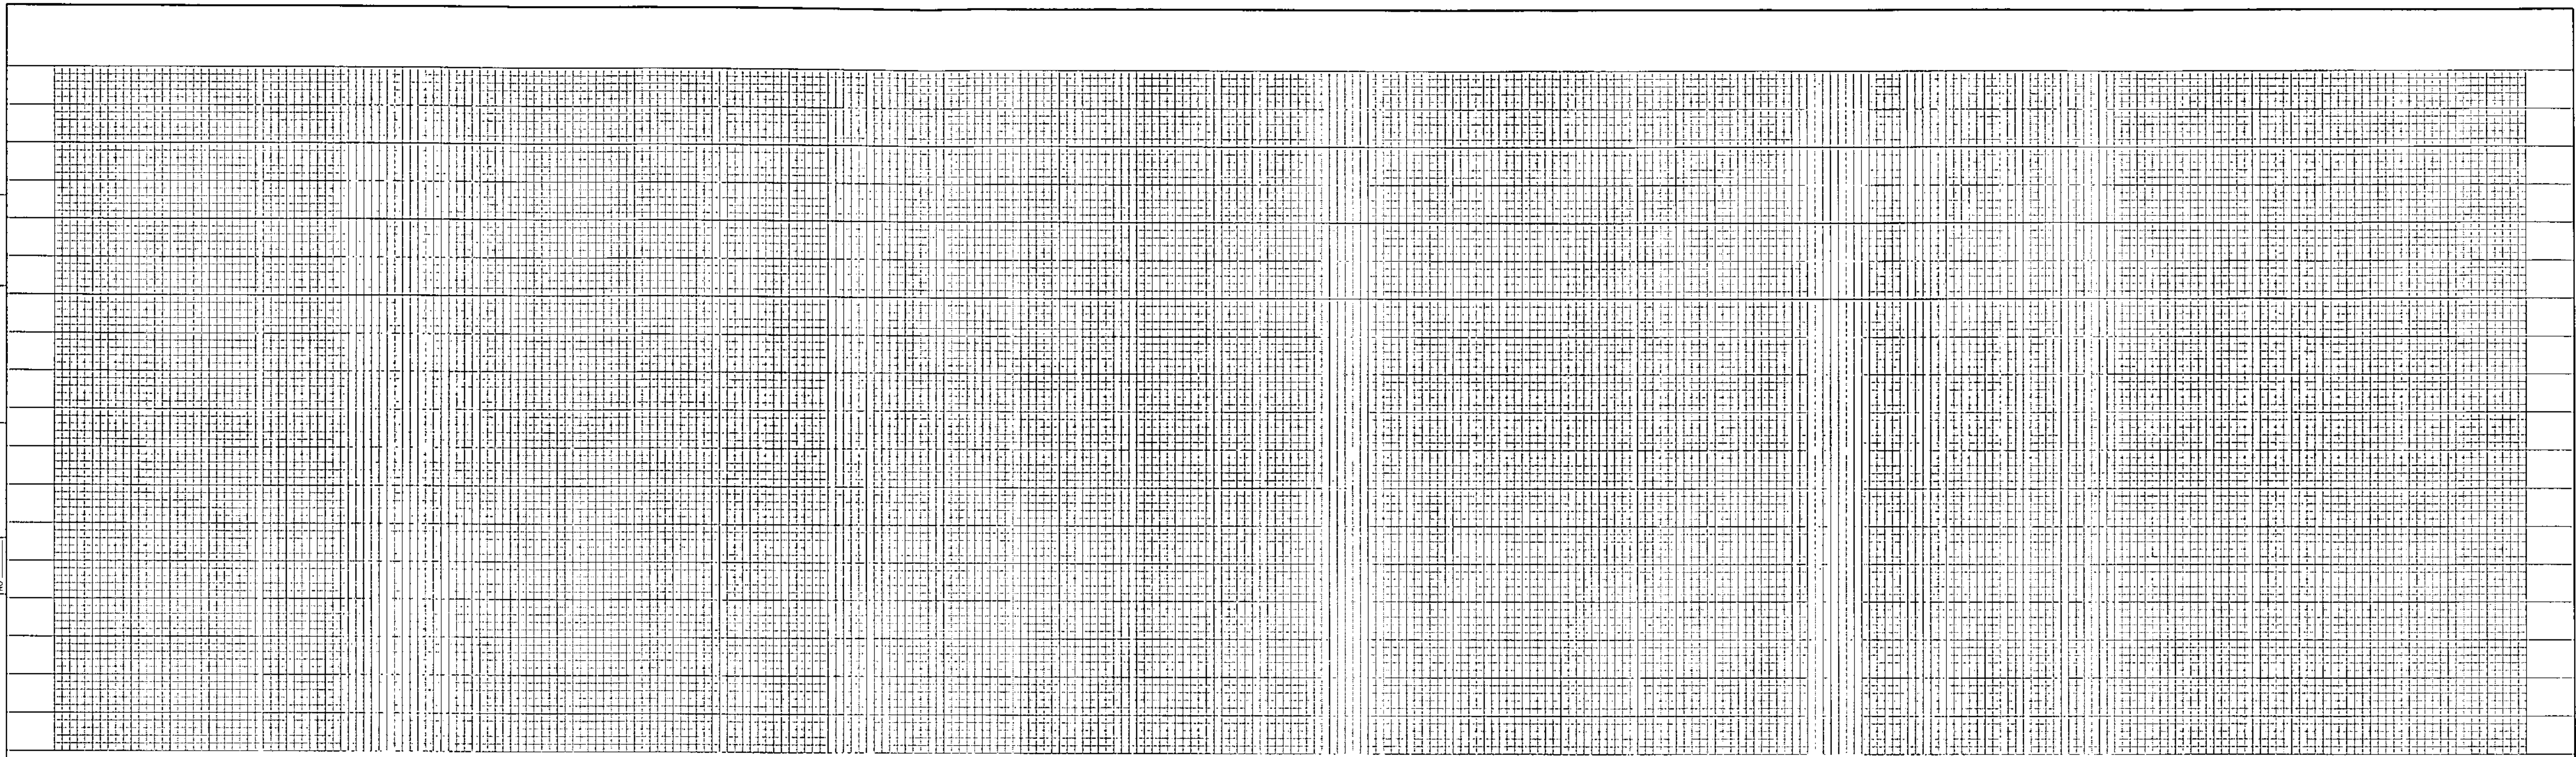

DATUM
 VERTICAL NGVD 1929
 HORIZONTAL NAD 1927

4/13/04 FOR PLAN SEE PLAN DRAWING NO. 2

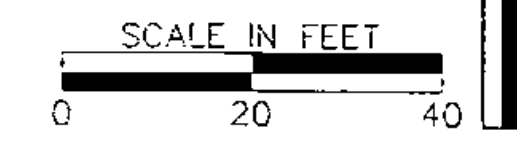

267
 SHELburne
 SURVEYED BY V.S.C. INC. DATE _____
 DRAWN BY E.A.A. INC. DATE _____
 TRACED BY E.A.A. INC. DATE _____
 PROJECT NH-EGC-019-4(27)
 PROFILE DRAWING NO. 2
 SHEET NO. 129 OF 537