
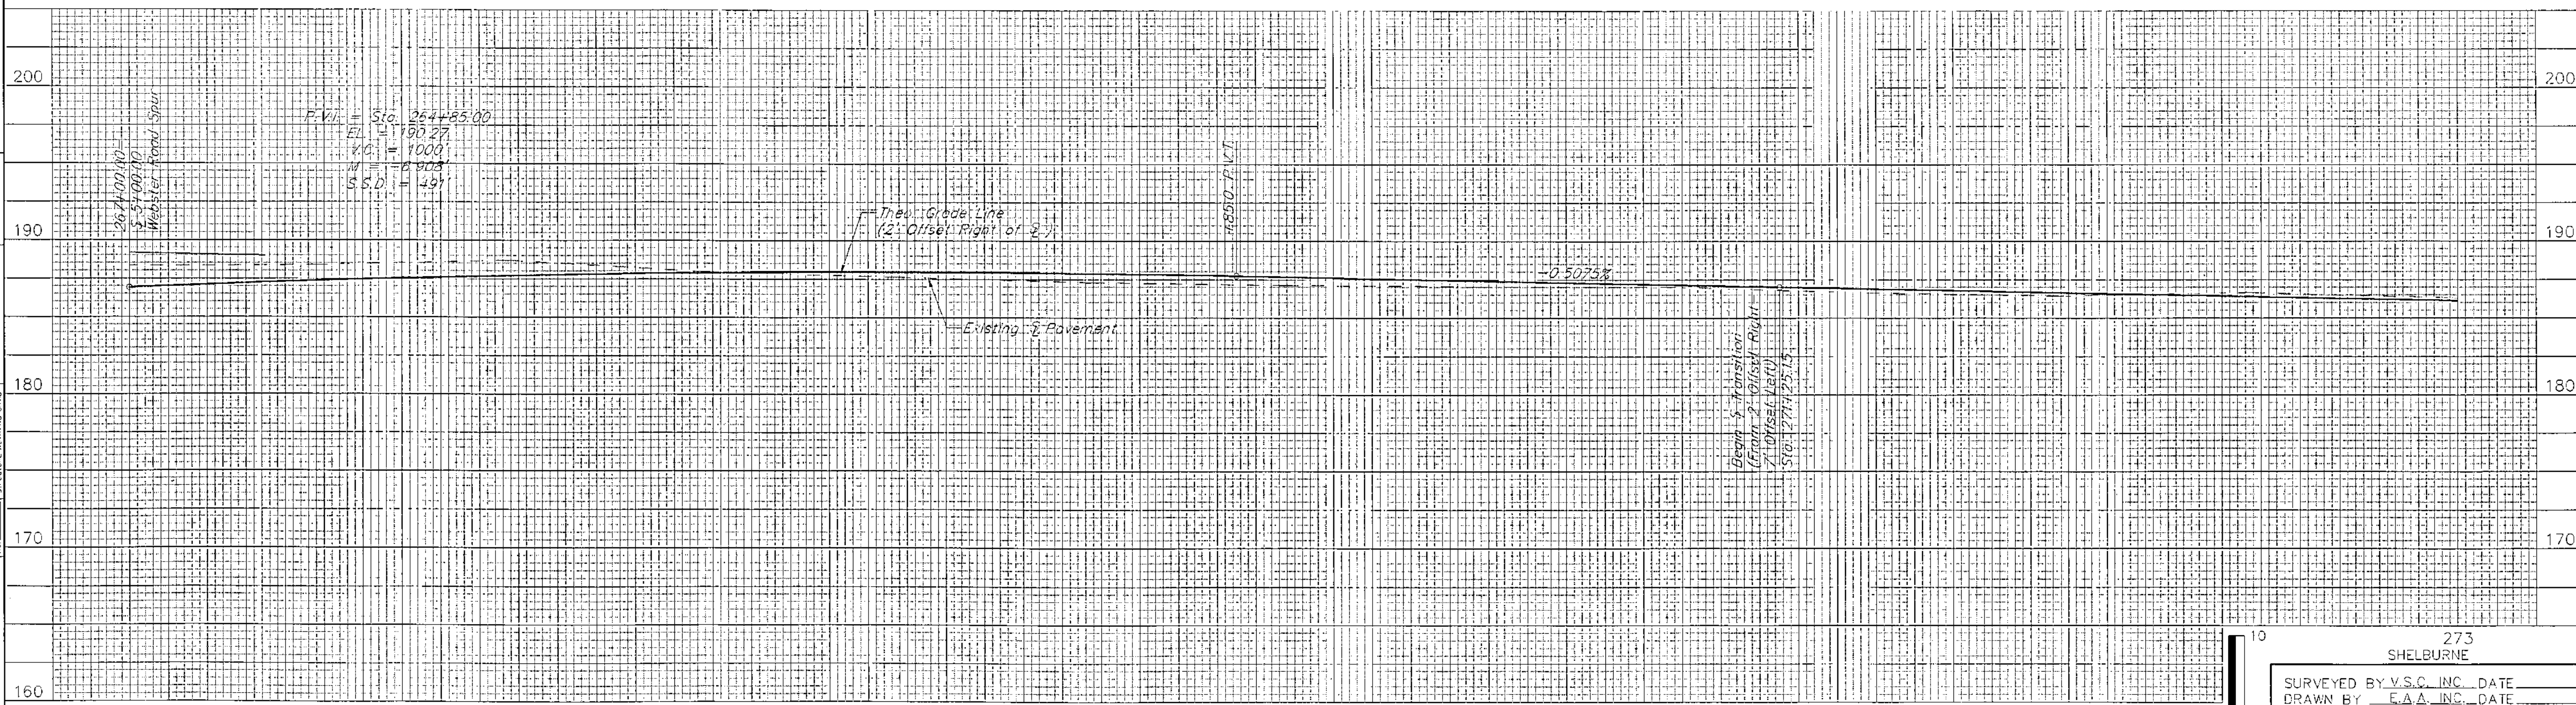


DATE
BY
PROJECT
SHELBURNE
ROUTE 103
R.I. OF NH 103000


DATE
BY
PROJECT
SHELBURNE
ROUTE 103
STRUCTURE NO. 103000

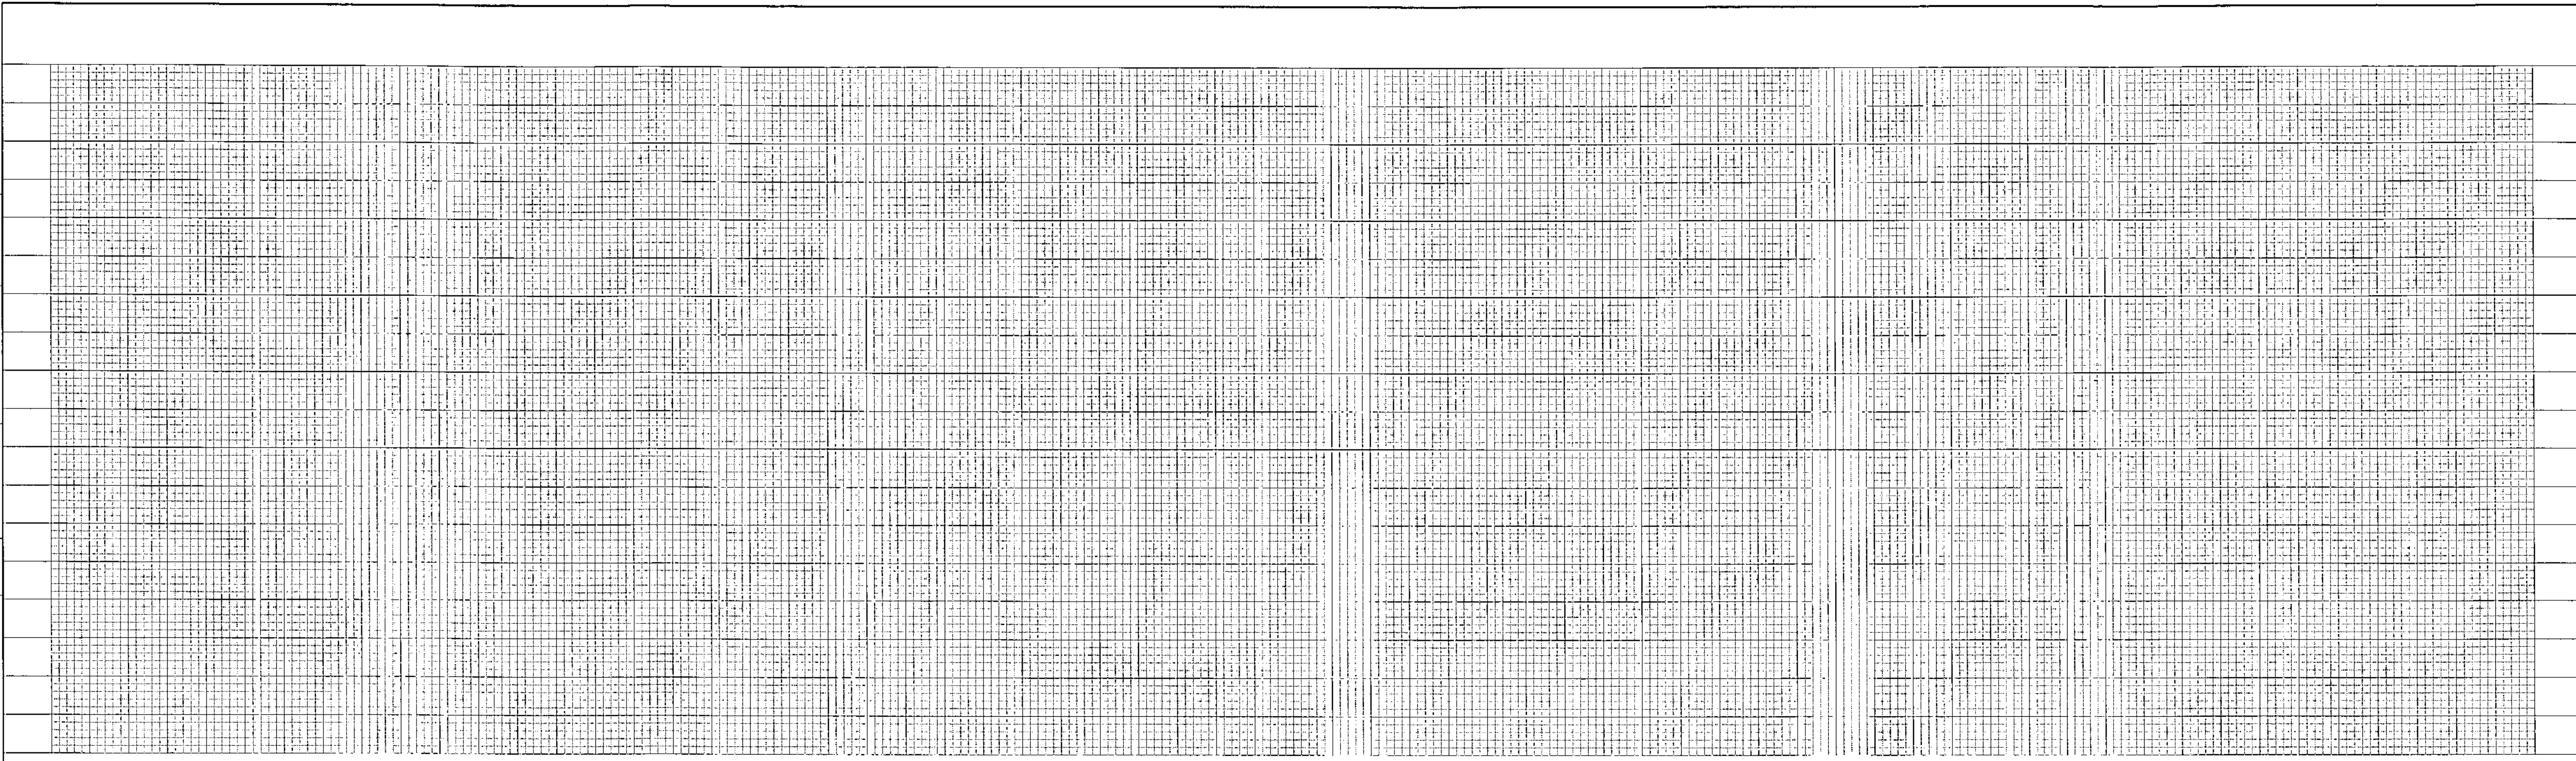

DATUM
VERTICAL NGVD 1929
HORIZONTAL NAD 1927

4/13/04

FOR PLAN SEE PLAN DRAWING NO. 3

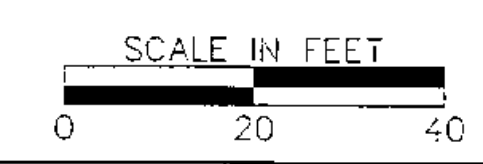

273
SHELBURNE
SURVEYED BY V.S.C. INC. DATE _____
DRAWN BY E.A.A. INC. DATE _____
TRACED BY E.A.A. INC. DATE _____
PROJECT NH-EGC-019-4(27)
PLAN DRAWING NO. 4
SHEET NO. 131 OF 537