


DATE _____
 BY _____
 PLAN
 REVIEWED _____
 NOTED _____
 DATE _____
 SHEET NO. _____


DATE _____
 BY _____
 PROFILE
 REVIEWED _____
 NOTED _____
 DATE _____
 SHEET NO. _____

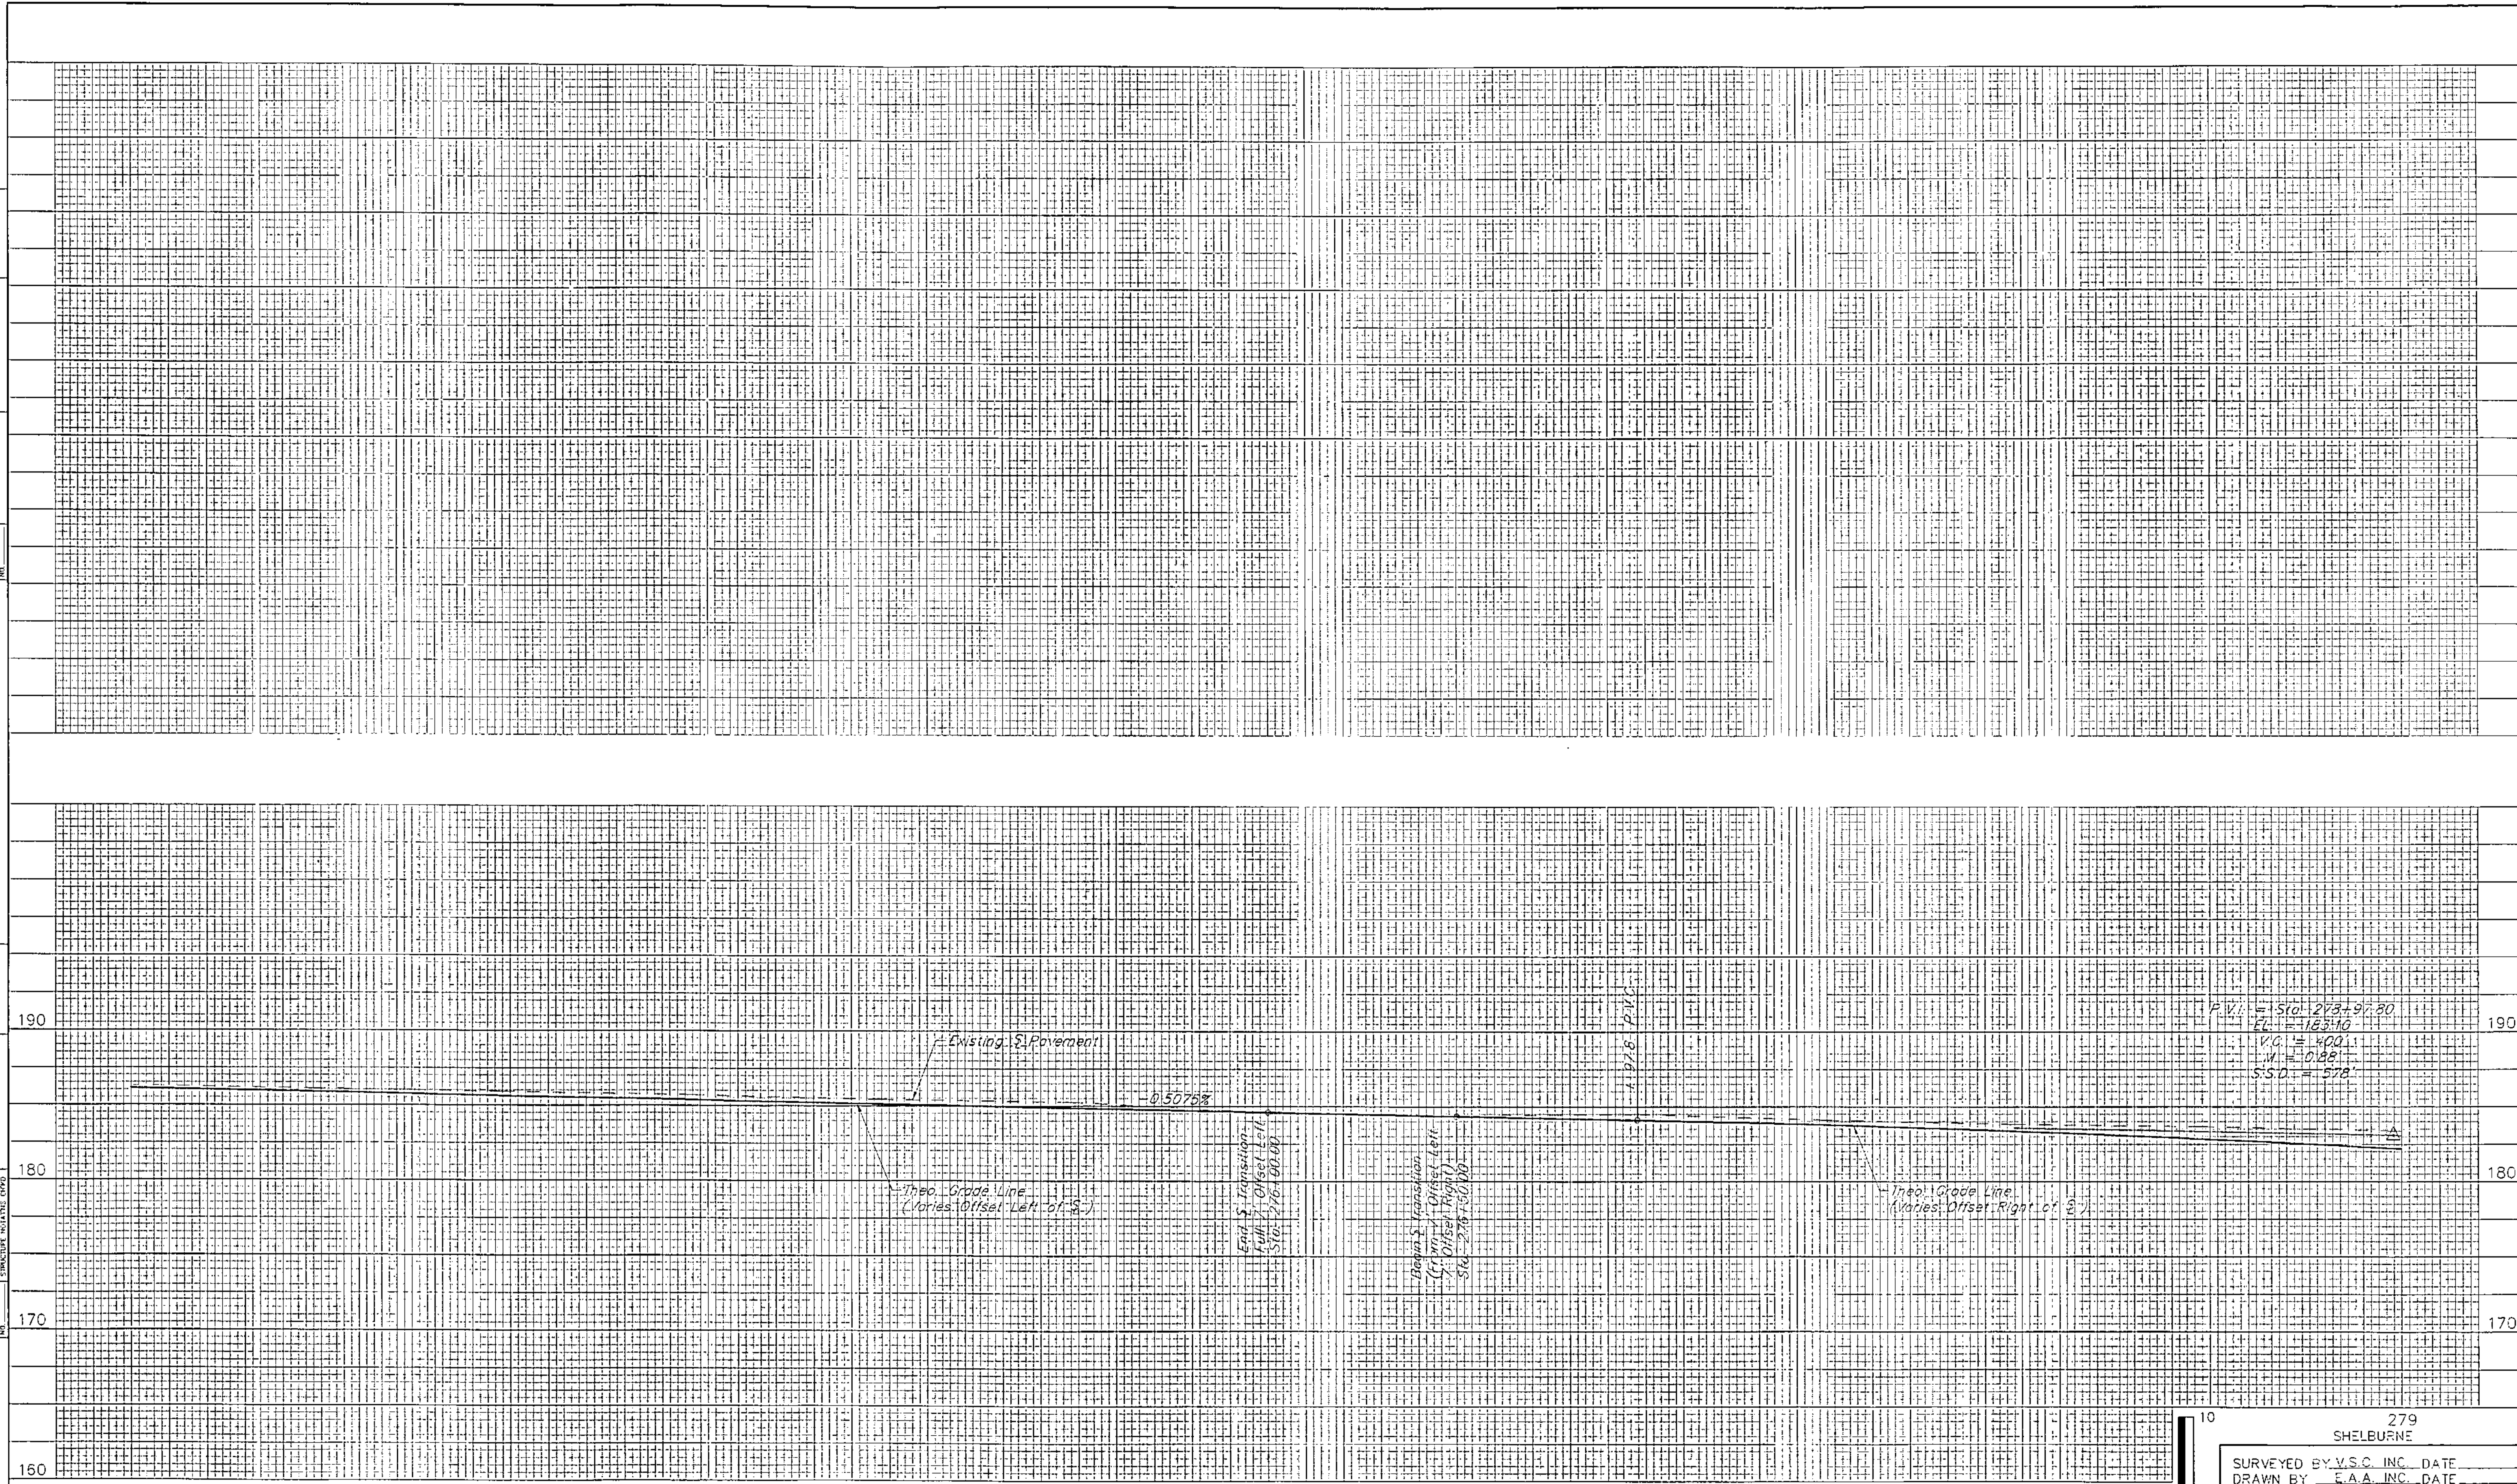

DATUM
 VERTICAL NGVD 1929
 HORIZONTAL NAD 1927

4/13/04

FOR PLAN SEE PLAN DRAWING NO. 4

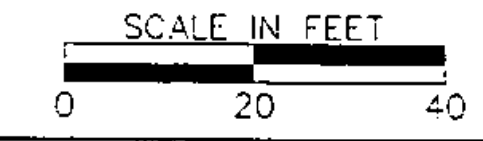

279
 SHELBURNE
 SURVEYED BY V.S.C. INC. DATE _____
 DRAWN BY E.A.A. INC. DATE _____
 TRACED BY E.A.A. INC. DATE _____
 PROJECT NH-ECC-019-4(27)
 PLAN DRAWING NO. 5
 SHEET NO. 132 OF 537