



PLAN  
 REVISIONS  
 NO. DATE  
 BY

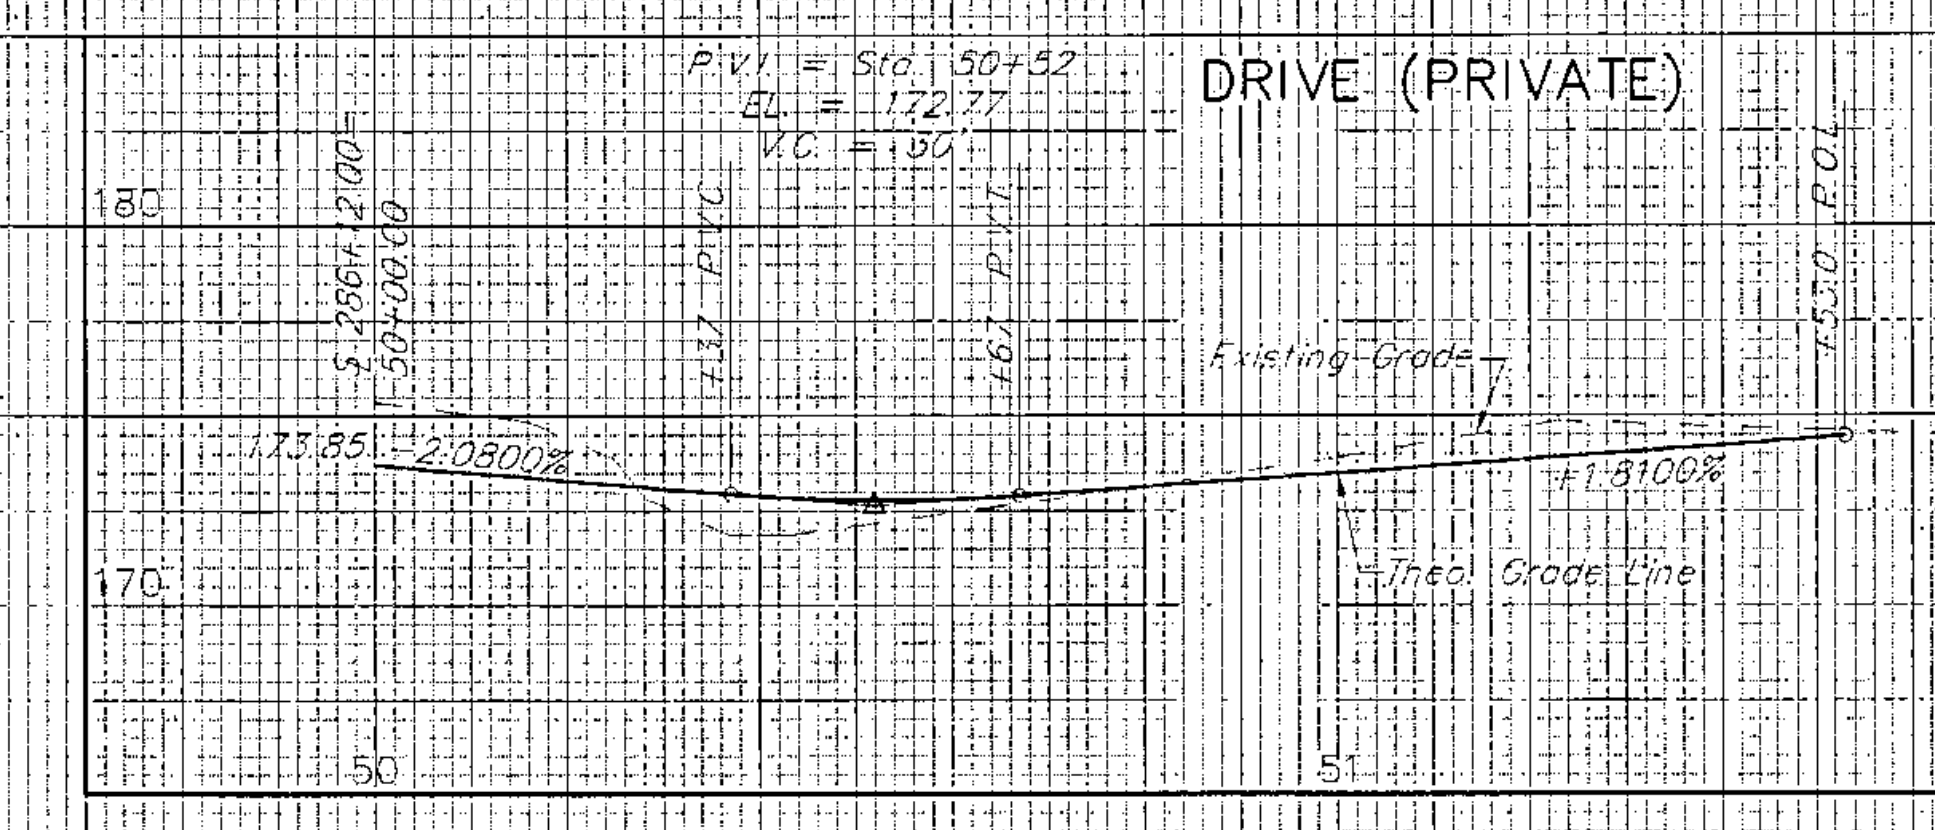


PROFILE  
 REVISIONS  
 NO. DATE  
 BY

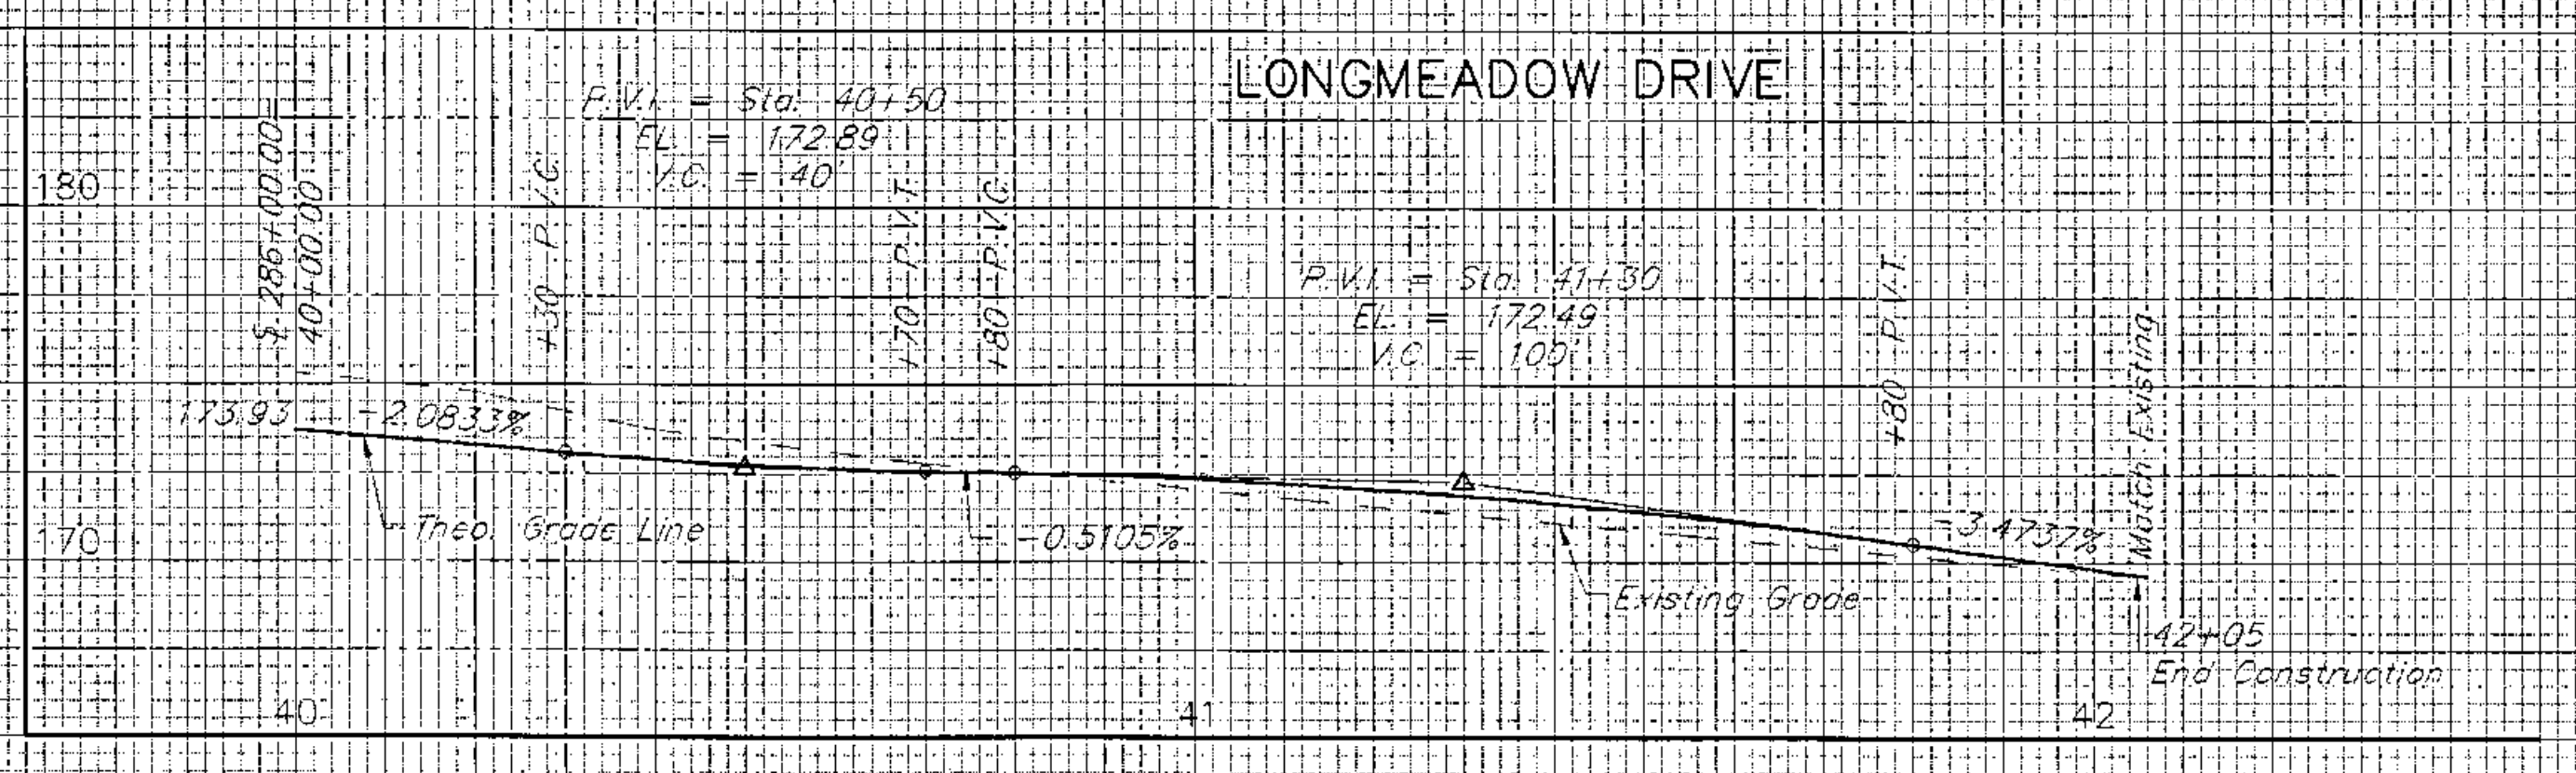

DATUM  
 VERTICAL NGVD 1929  
 HORIZONTAL NAD 1927

4/13/04 FOR PLAN SEE PLAN DRAWING NO. 6

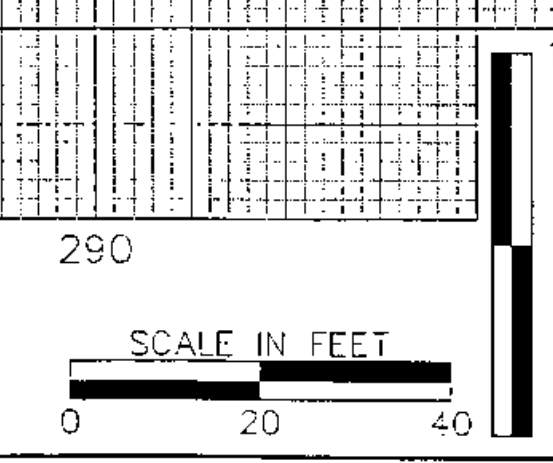

291  
 SHELburne

SURVEYED BY V.S.C. INC. DATE \_\_\_\_\_  
 DRAWN BY E.A.A. INC. DATE \_\_\_\_\_  
 TRACED BY E.A.A. INC. DATE \_\_\_\_\_

PROJECT NH-EGC-019-4(27)  
 PROFILE DRAWING NO. 7  
 SHEET NO. 134 OF 537