


PLAN
 DATE _____
 BY _____
 CHECKED BY _____
 DATE _____
 REVISIONS
 NO. _____

PROFILE
 DATE _____
 BY _____
 CHECKED BY _____
 DATE _____
 REVISIONS
 NO. _____

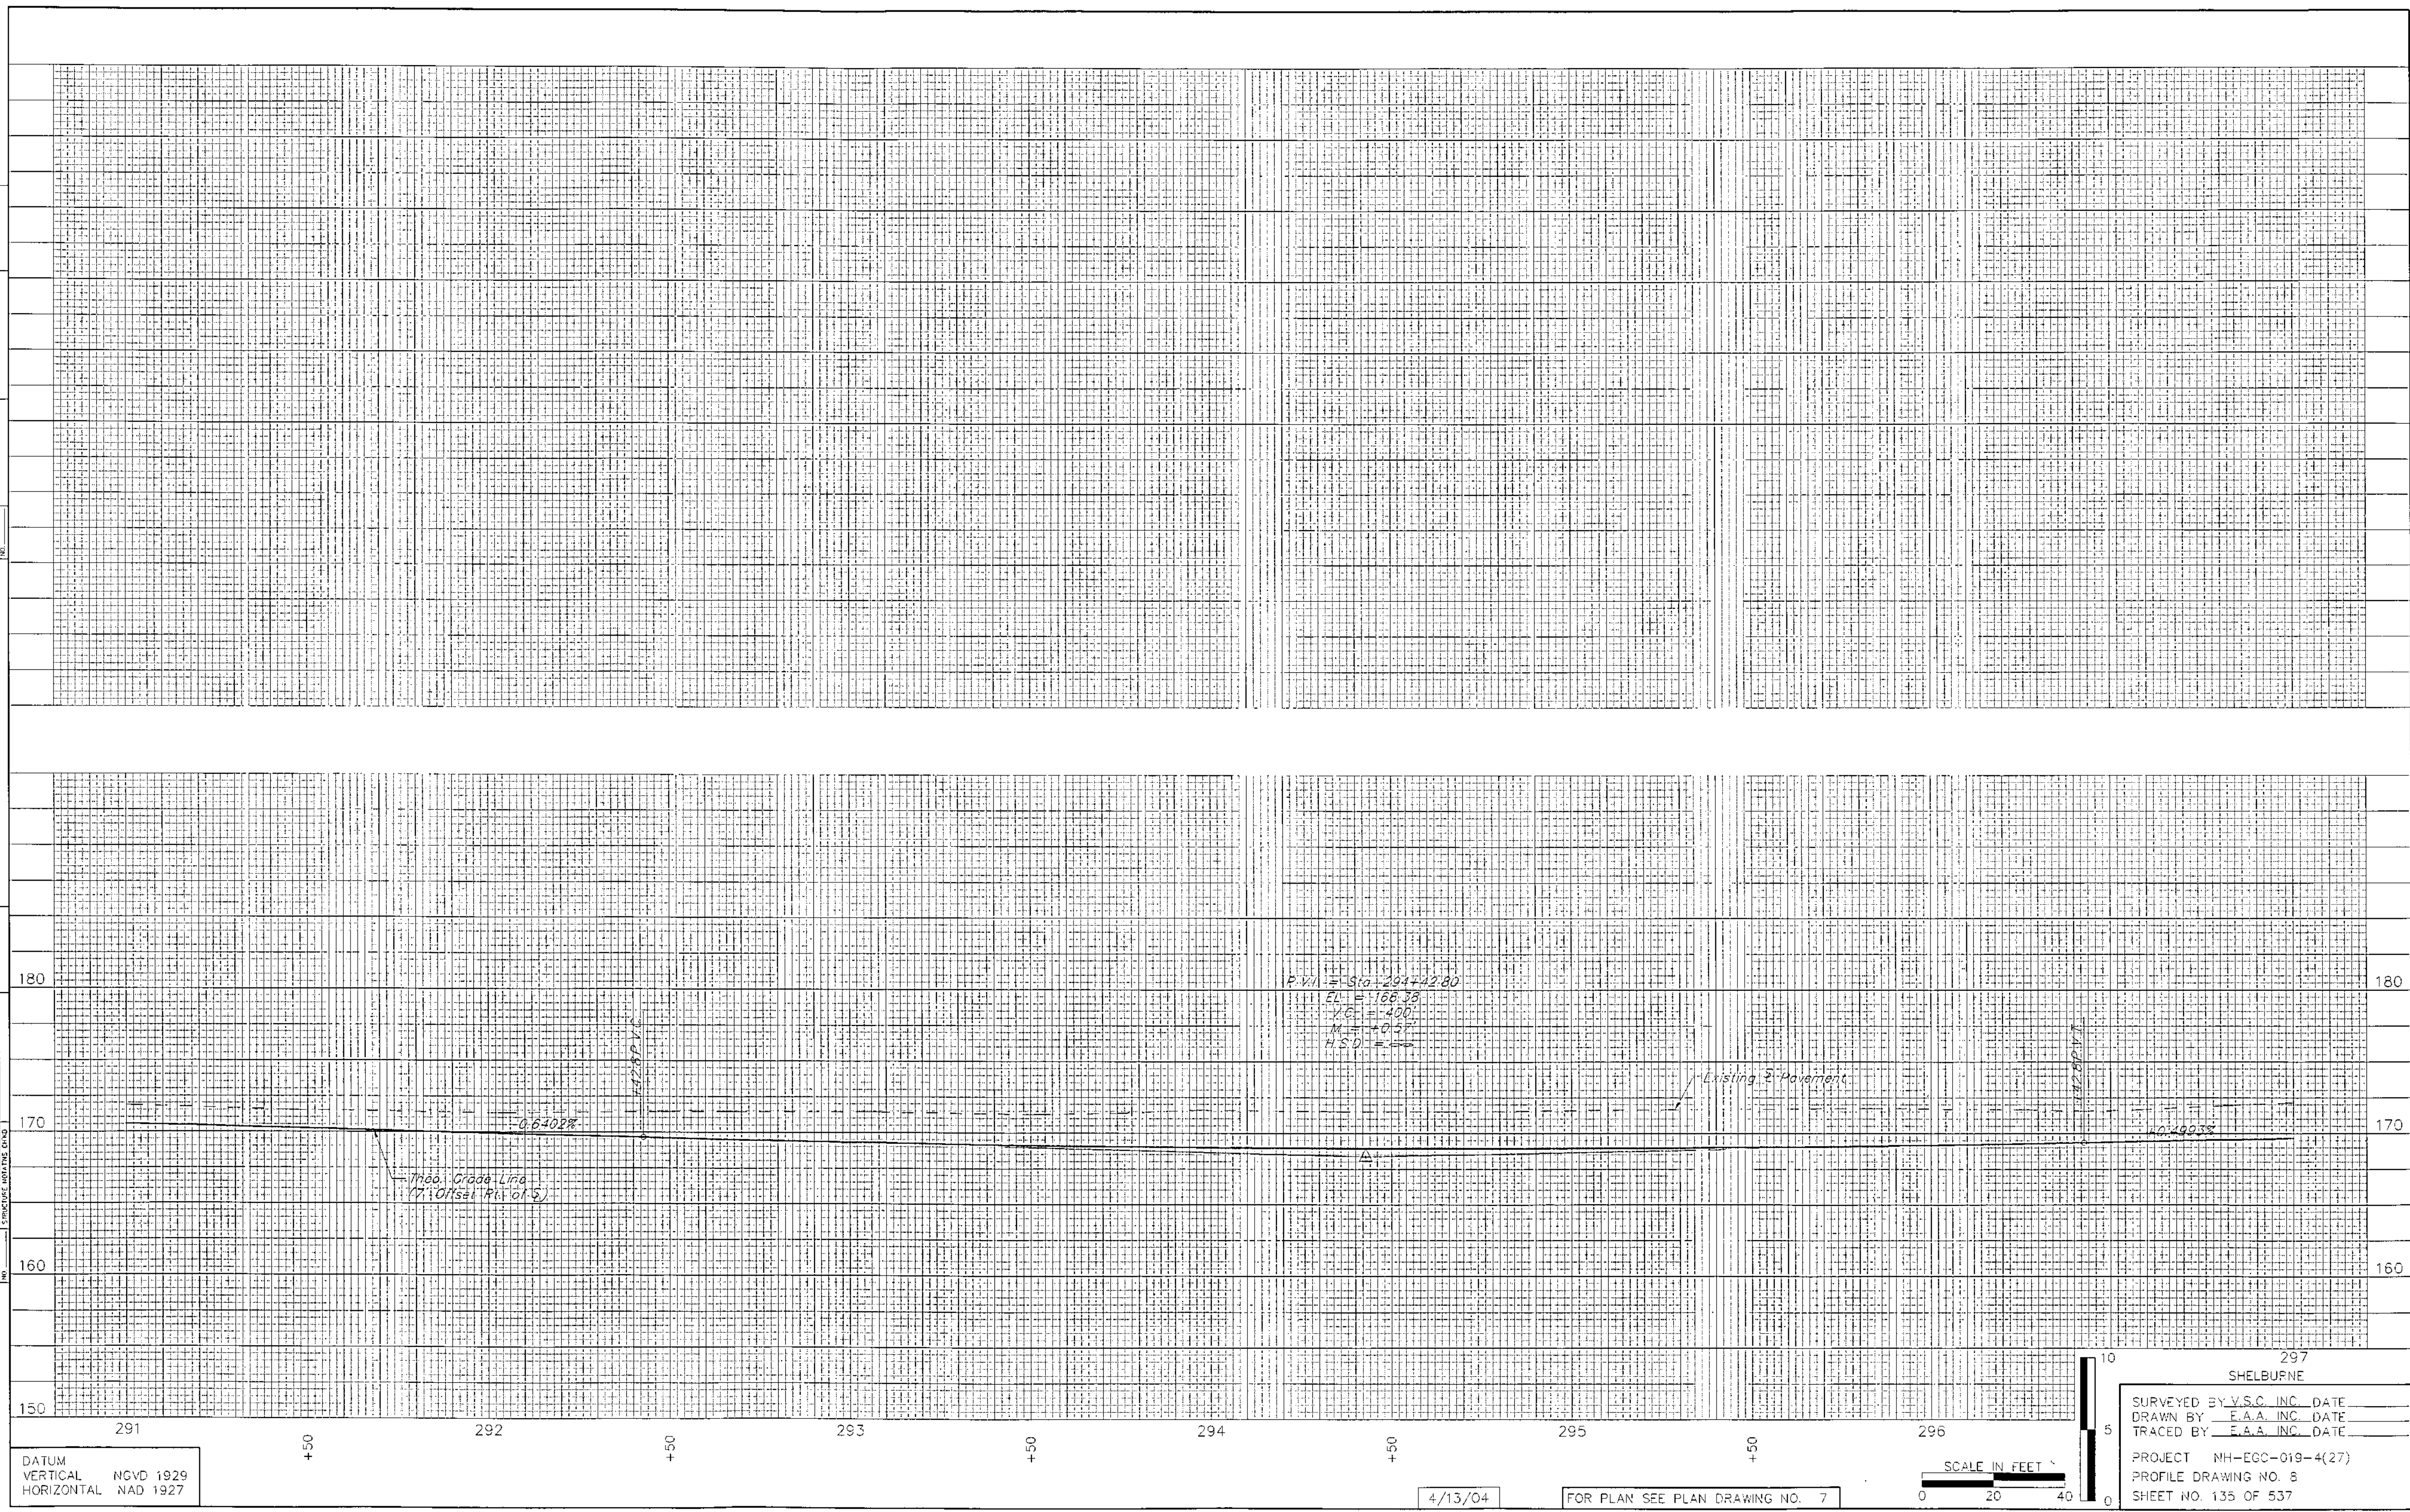

DATUM
 VERTICAL NGVD 1929
 HORIZONTAL NAD 1927

4/13/04

FOR PLAN SEE PLAN DRAWING NO. 7

SCALE IN FEET
 0 20 40

297
 SHELBURNE
 SURVEYED BY V.S.C. INC. DATE _____
 DRAWN BY E.A.A. INC. DATE _____
 TRACED BY E.A.A. INC. DATE _____
 PROJECT NH-ECC-019-4(27)
 PROFILE DRAWING NO. 8
 SHEET NO. 135 OF 537