



DATE: \_\_\_\_\_  
 BY: \_\_\_\_\_  
 PLAN  
 REVISIONS:  
 NO. DATE BY DESCRIPTION  
 1 01/04/04 E.A.S. REVISIONS  
 2 01/04/04 E.A.S. REVISIONS  
 3 01/04/04 E.A.S. REVISIONS  
 4 01/04/04 E.A.S. REVISIONS  
 5 01/04/04 E.A.S. REVISIONS  
 6 01/04/04 E.A.S. REVISIONS  
 7 01/04/04 E.A.S. REVISIONS  
 8 01/04/04 E.A.S. REVISIONS  
 9 01/04/04 E.A.S. REVISIONS  
 10 01/04/04 E.A.S. REVISIONS

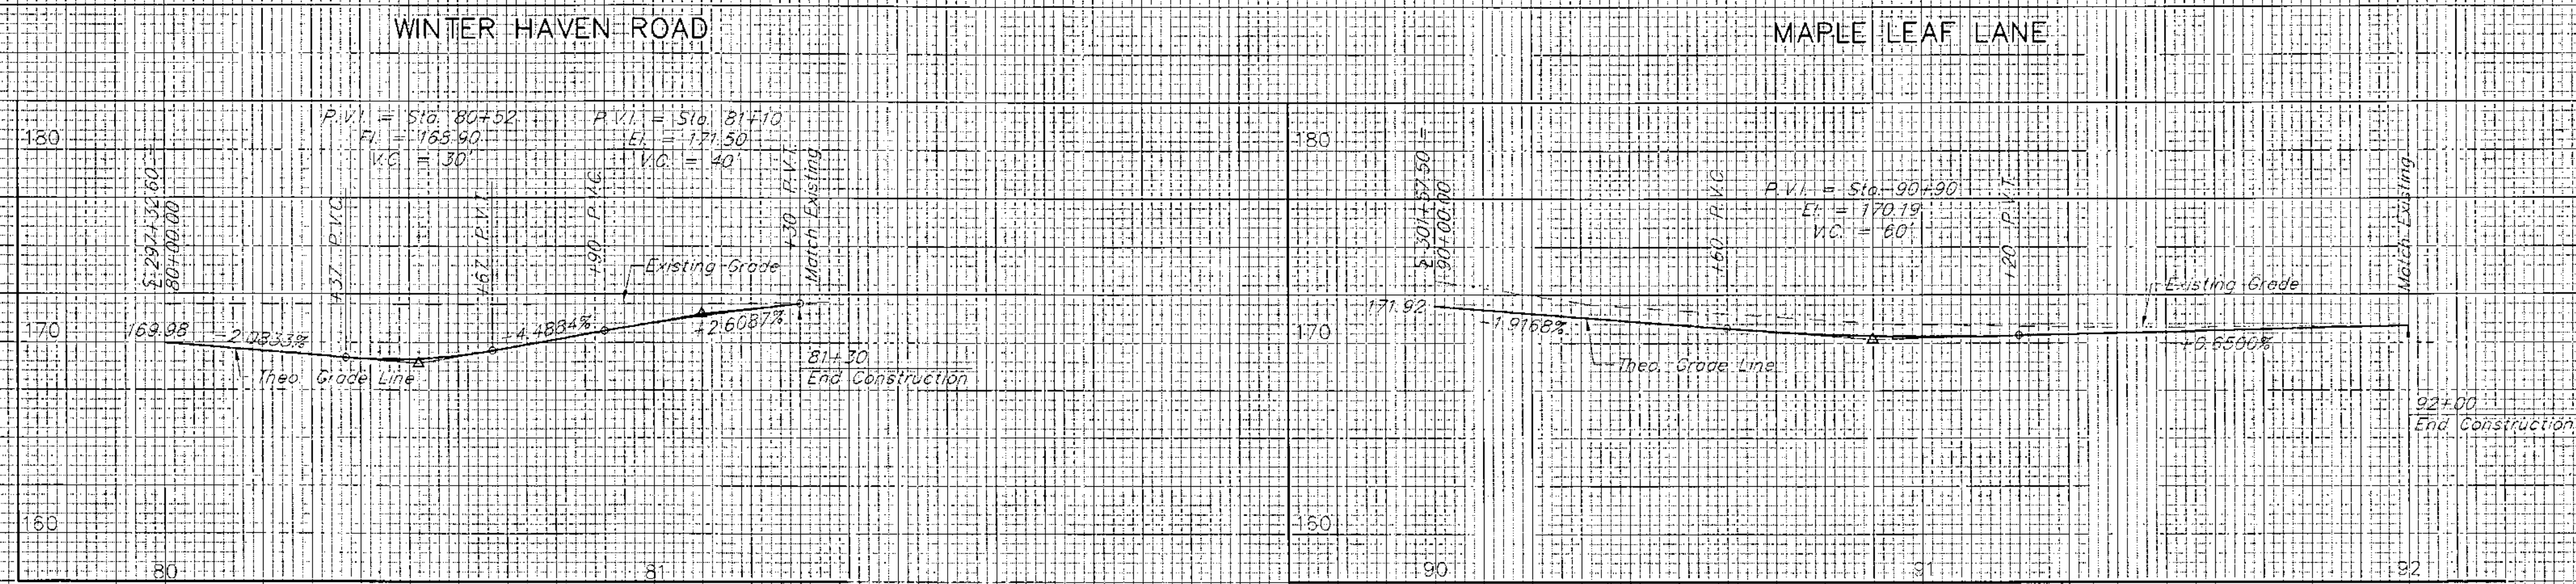


DATE: \_\_\_\_\_  
 BY: \_\_\_\_\_  
 PROFILE  
 REVISIONS:  
 NO. DATE BY DESCRIPTION  
 1 01/04/04 E.A.S. REVISIONS  
 2 01/04/04 E.A.S. REVISIONS  
 3 01/04/04 E.A.S. REVISIONS  
 4 01/04/04 E.A.S. REVISIONS  
 5 01/04/04 E.A.S. REVISIONS  
 6 01/04/04 E.A.S. REVISIONS  
 7 01/04/04 E.A.S. REVISIONS  
 8 01/04/04 E.A.S. REVISIONS  
 9 01/04/04 E.A.S. REVISIONS  
 10 01/04/04 E.A.S. REVISIONS

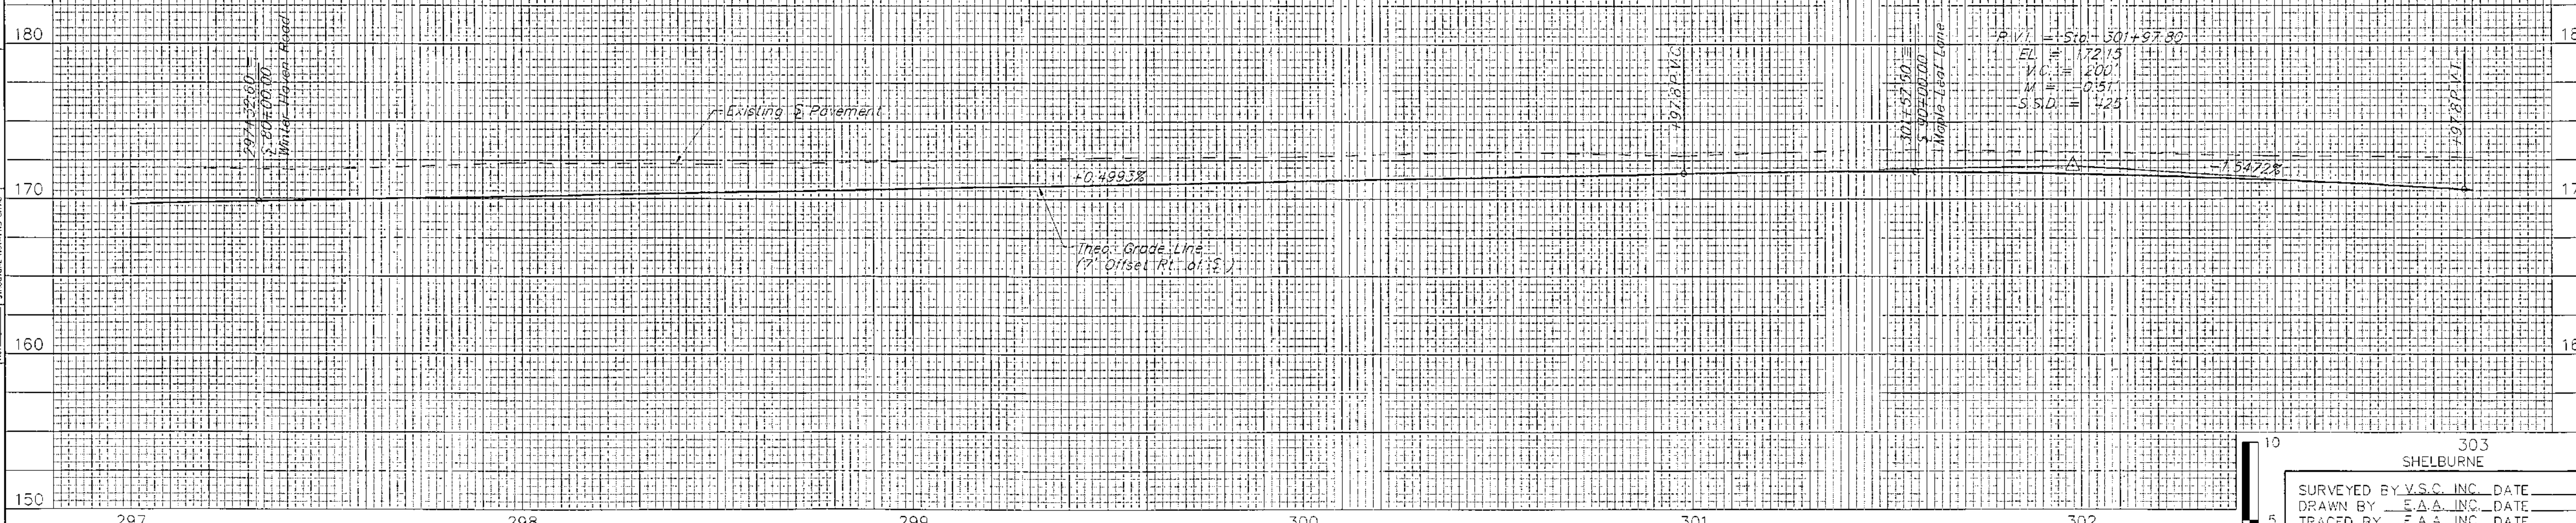

DATUM  
 VERTICAL NCVD 1929  
 HORIZONTAL NAD 1927

4/13/04 FOR PLAN SEE PLAN DRAWING NO. 8

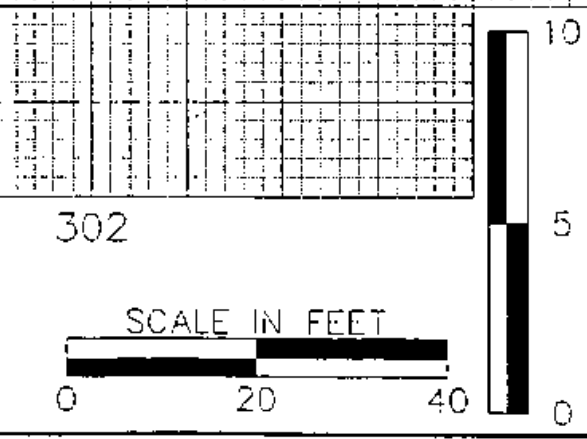

303  
 SHELBURNE  
 SURVEYED BY Y.S.C. INC. DATE \_\_\_\_\_  
 DRAWN BY E.A.S. INC. DATE \_\_\_\_\_  
 TRACED BY E.A.S. INC. DATE \_\_\_\_\_  
 PROJECT NH-EGC-019-4(27)  
 PROFILE DRAWING NO. 9  
 SHEET NO. 136 OF 537