


DATE _____
 BY _____
 PLAN
 SURVEYED _____
 CHECKED _____
 NOTE BOOK _____
 NO. _____


DATE _____
 BY _____
 PROFILE
 SURVEYED _____
 CHECKED _____
 NOTE BOOK _____
 NO. _____

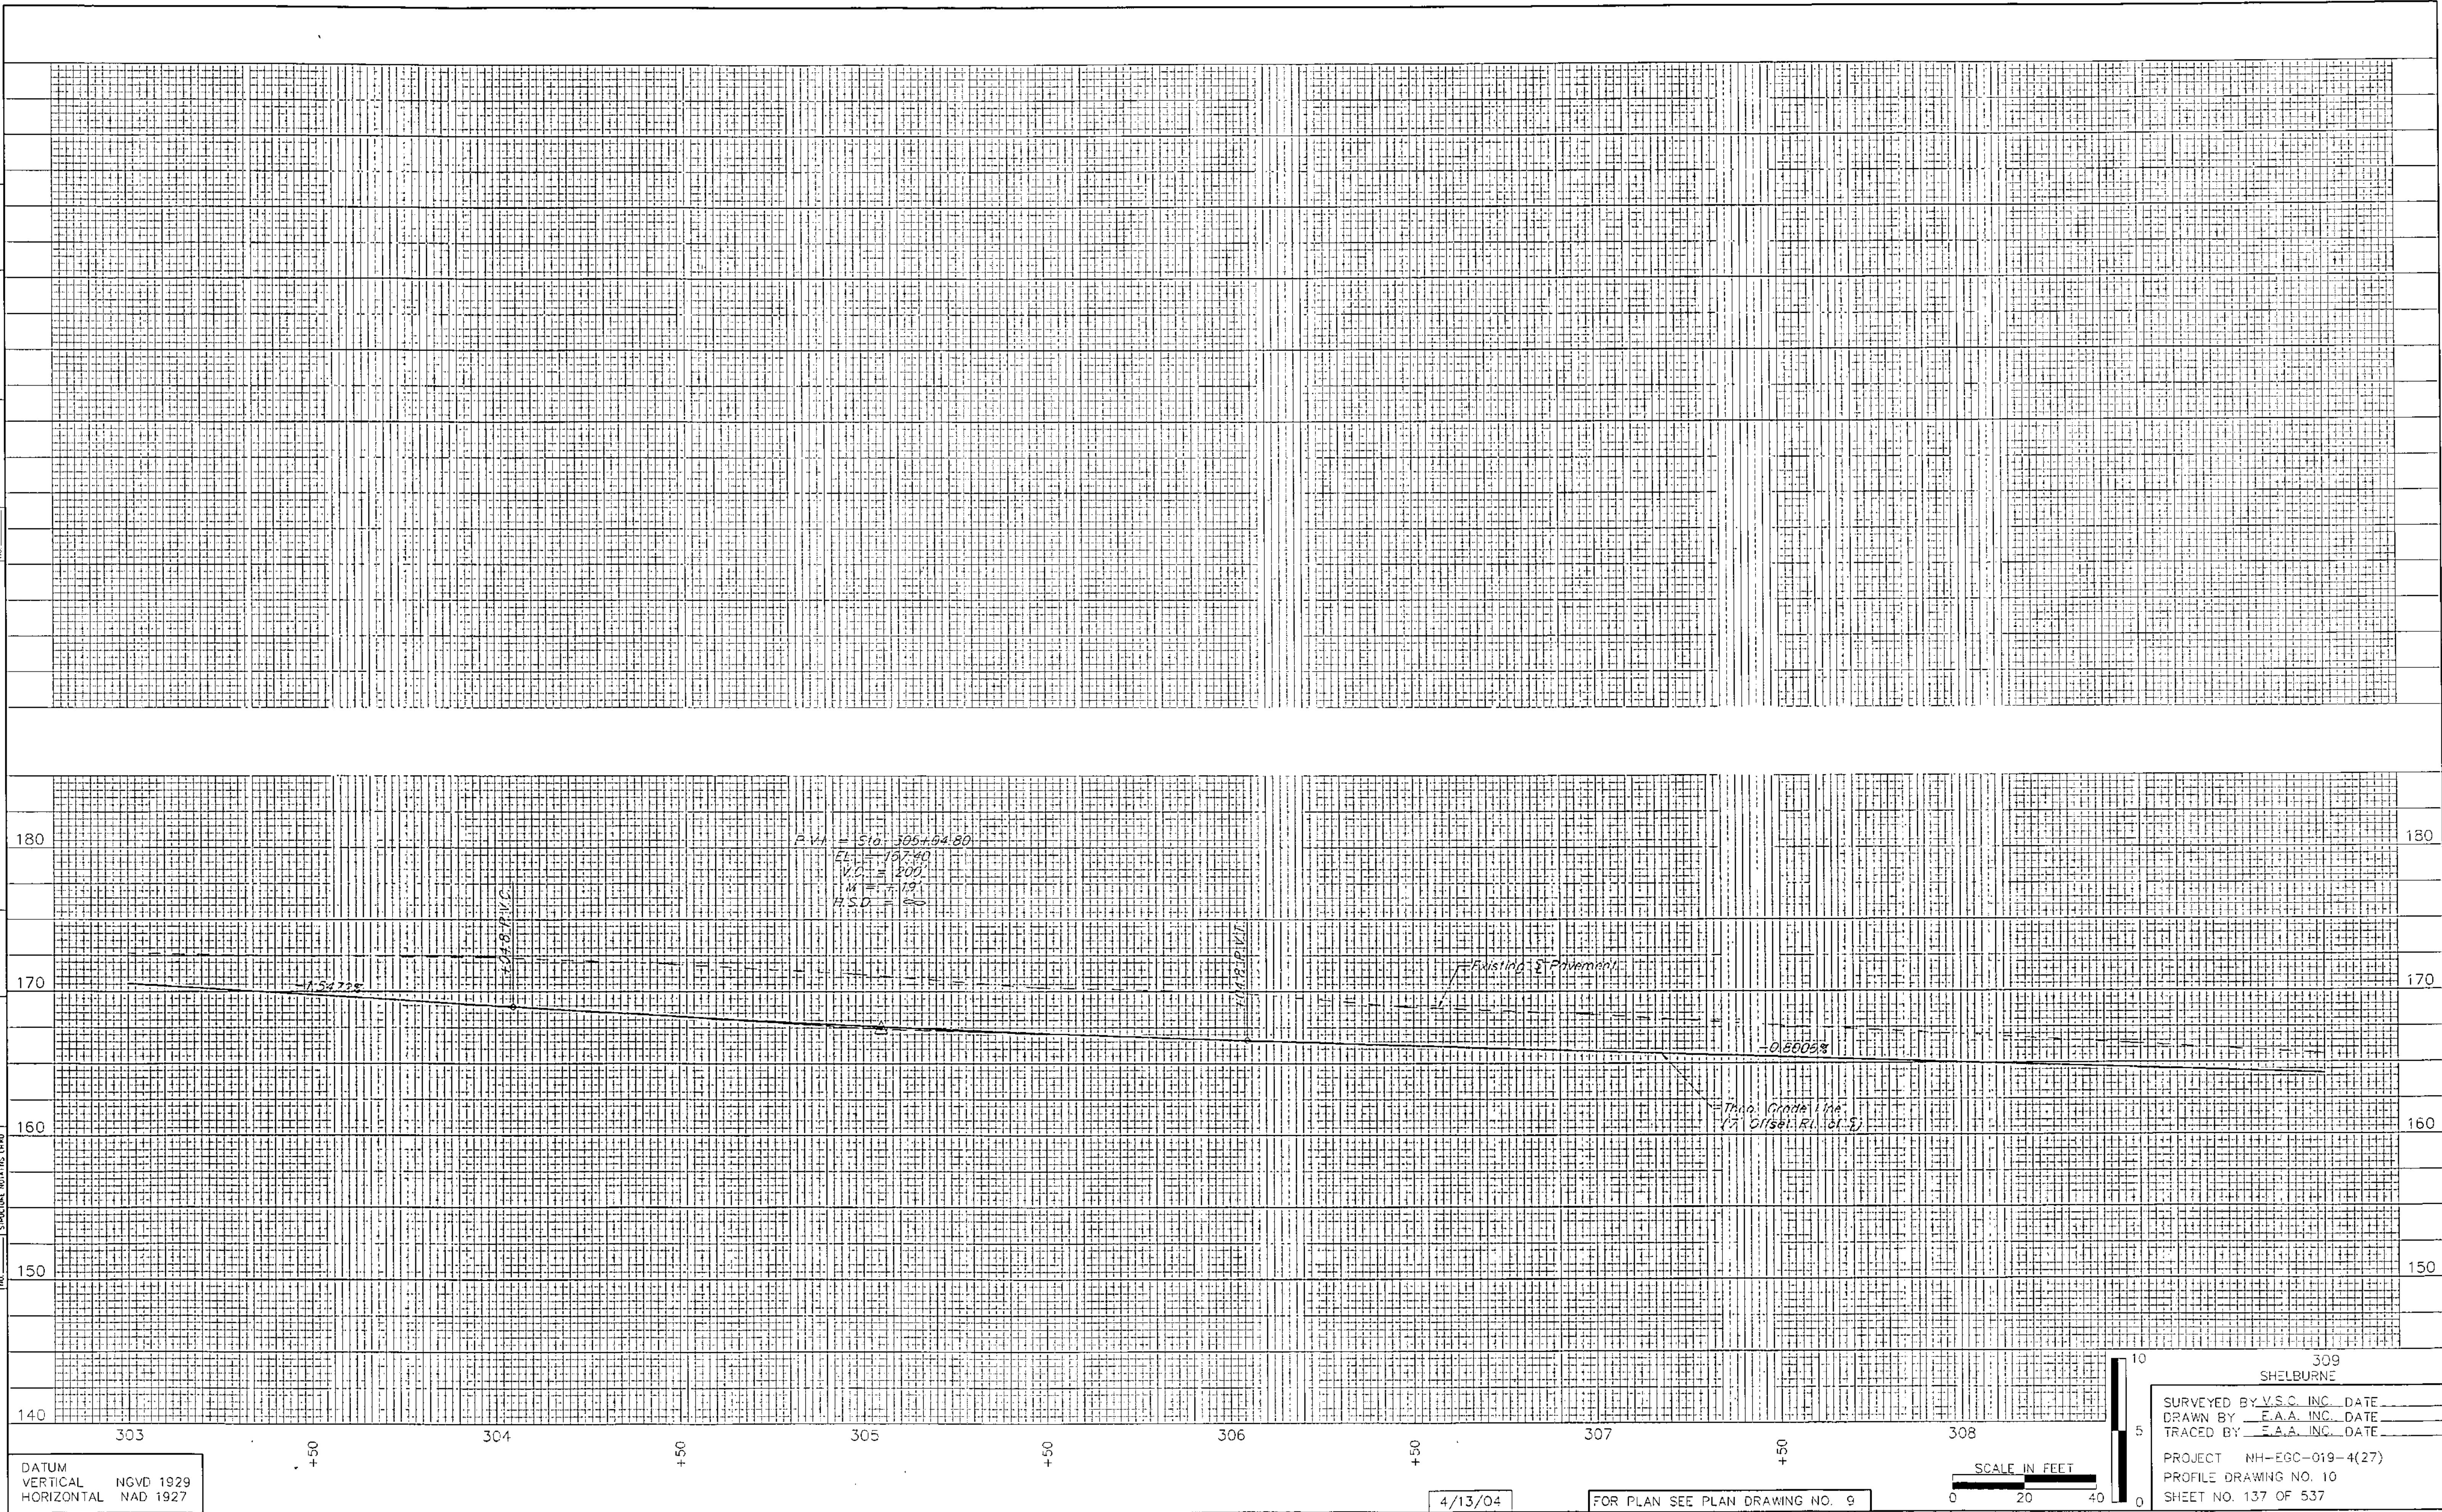

DATUM
 VERTICAL NGVD 1929
 HORIZONTAL NAD 1927

4/13/04

FOR PLAN SEE PLAN DRAWING NO. 9

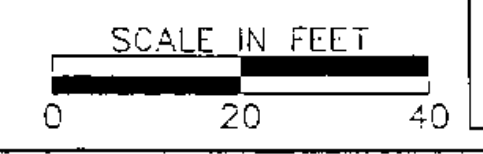

309
 SHELburnE

SURVEYED BY V.S.C. INC. DATE _____
 DRAWN BY E.A.A. INC. DATE _____
 TRACED BY E.A.A. INC. DATE _____

PROJECT NH-EGC-019-4(27)
 PROFILE DRAWING NO. 10
 SHEET NO. 137 OF 537