



DATE _____
 BY _____
 PLAN SHEET NO. _____
 SHEET NO. _____

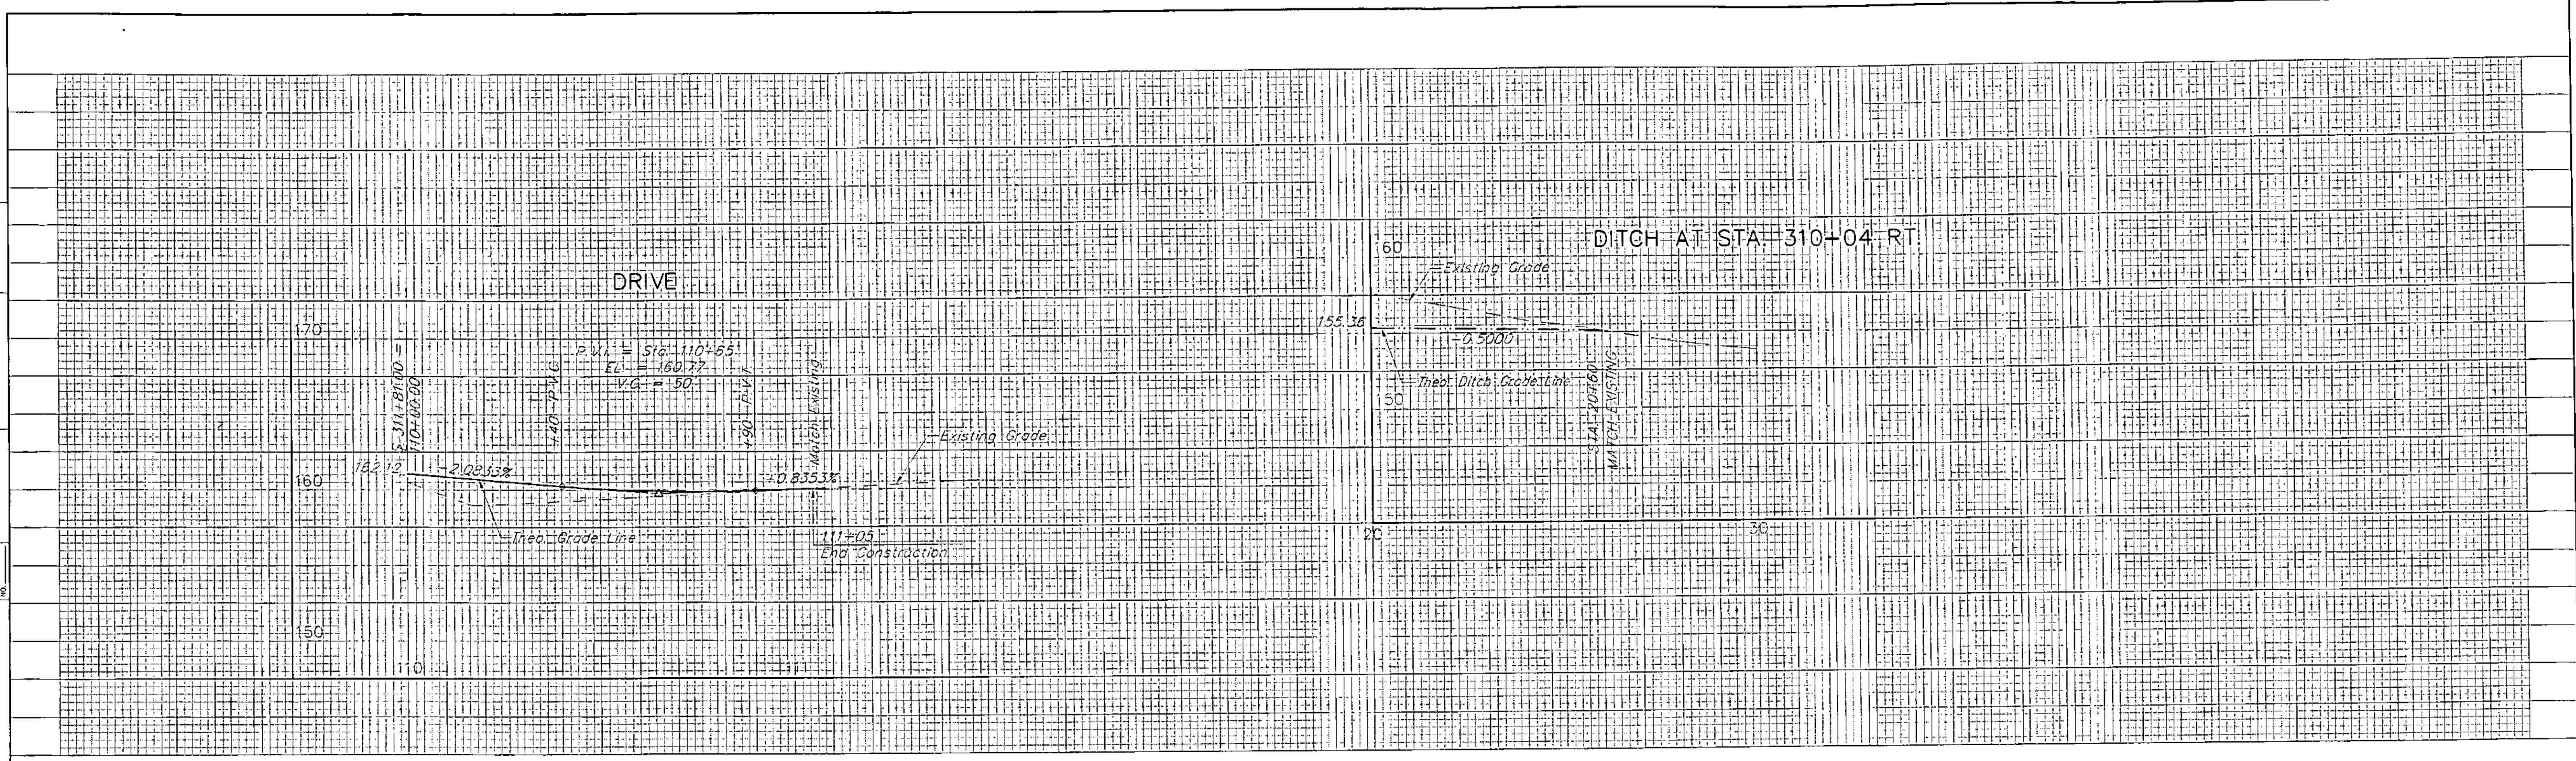


DATE _____
 BY _____
 PROFILE SHEET NO. _____
 SHEET NO. _____

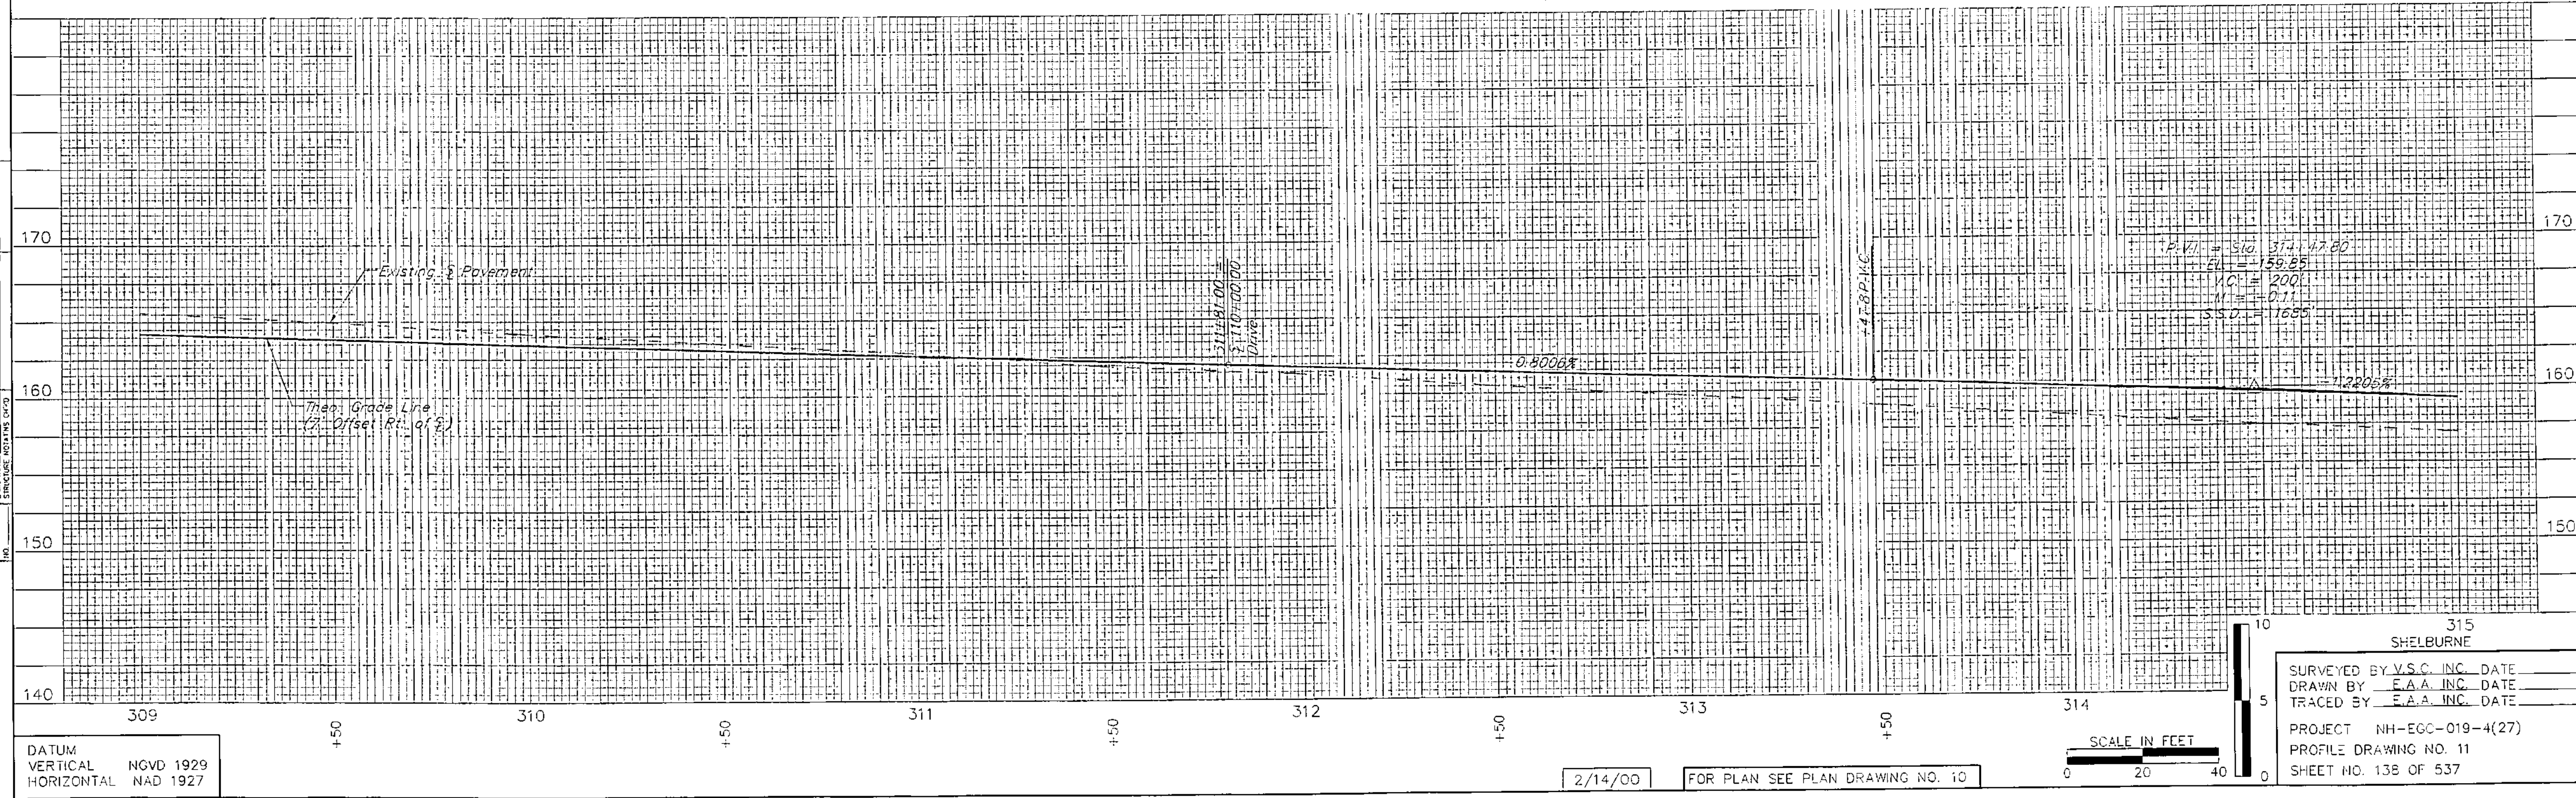

DATUM
 VERTICAL NGVD 1929
 HORIZONTAL NAD 1927

2/14/00 FOR PLAN SEE PLAN DRAWING NO. 10

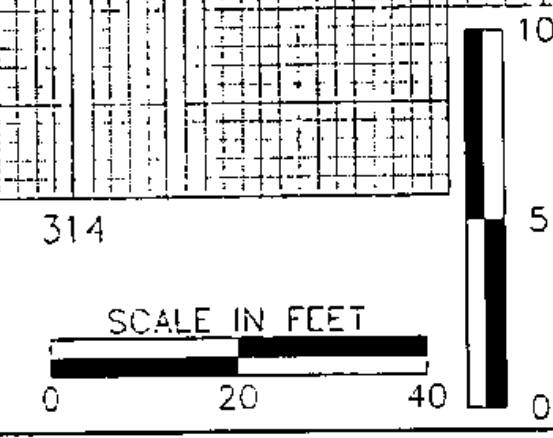

315
 SHELBURNE
 SURVEYED BY V.S.C. INC. DATE _____
 DRAWN BY E.A.A. INC. DATE _____
 TRACED BY E.A.A. INC. DATE _____
 PROJECT NH-EGC-019-4(27)
 PROFILE DRAWING NO. 11
 SHEET NO. 138 OF 537