



PLAN
 DATE _____
 BY _____
 CHECKED _____
 DATE _____
 NOTE BOOK NO. _____

PROFILE
 DATE _____
 BY _____
 CHECKED _____
 DATE _____
 NOTE BOOK NO. _____

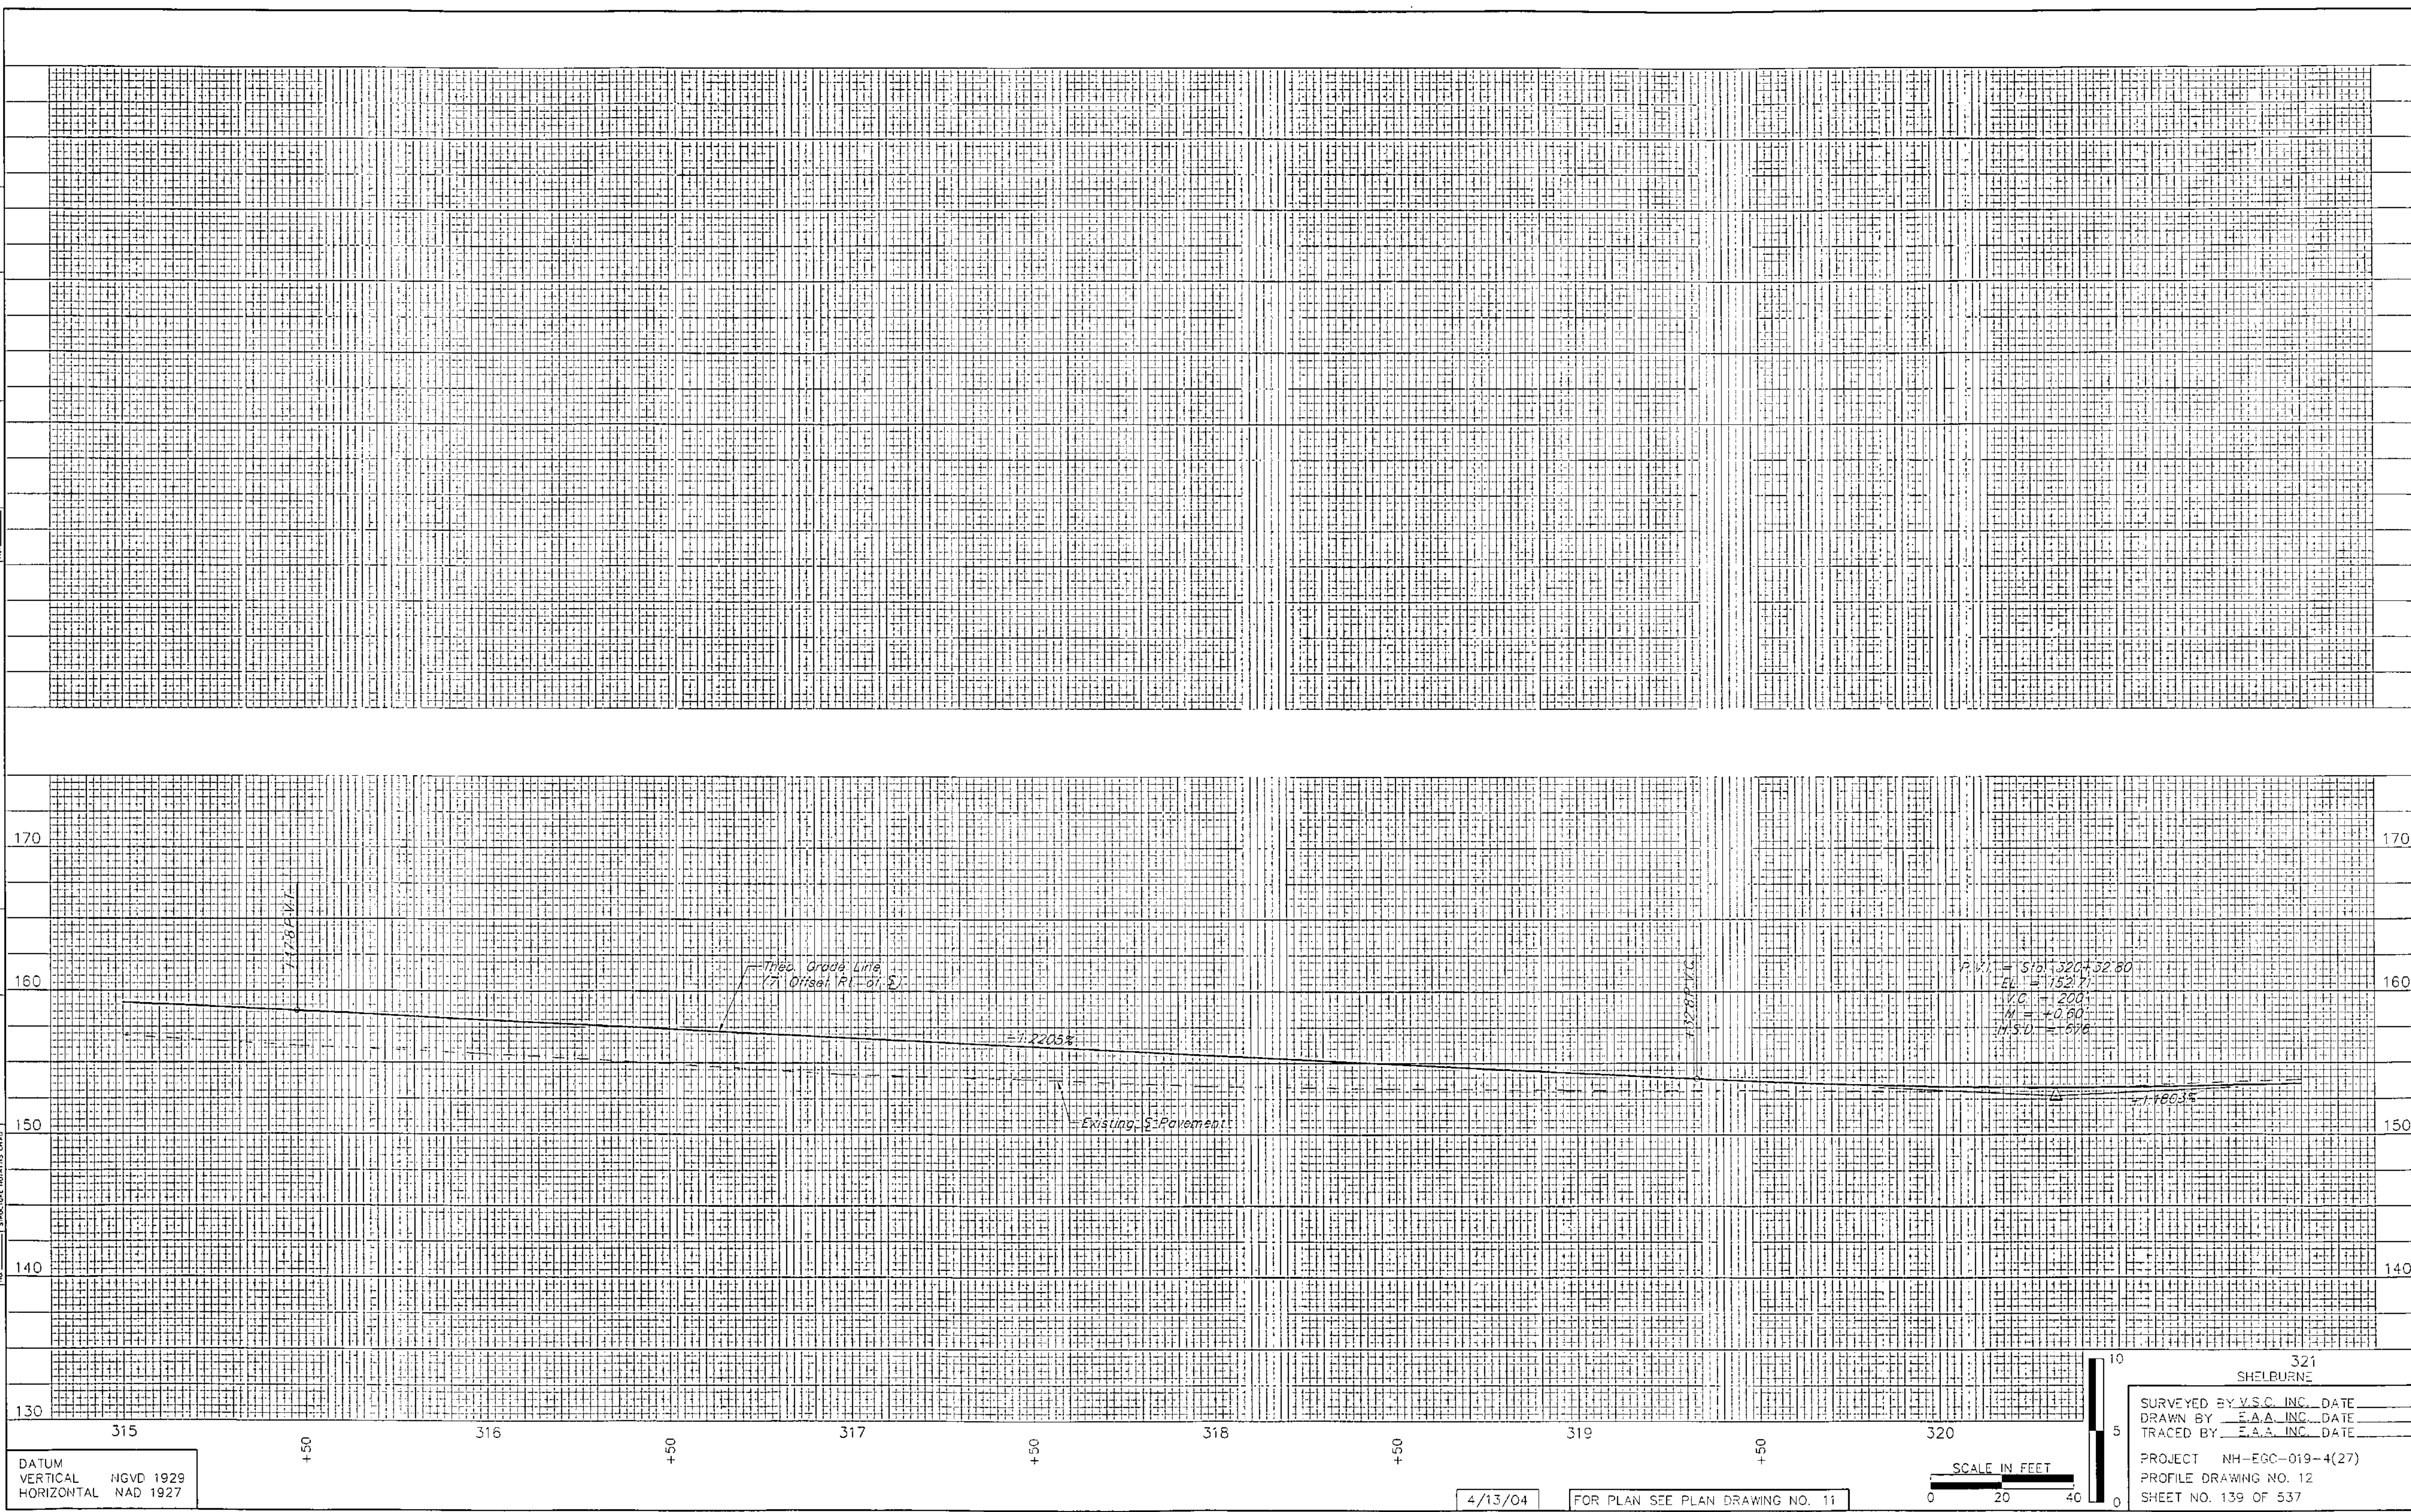

DATUM
 VERTICAL NGVD 1929
 HORIZONTAL NAD 1927

4/13/04 FOR PLAN SEE PLAN DRAWING NO. 11

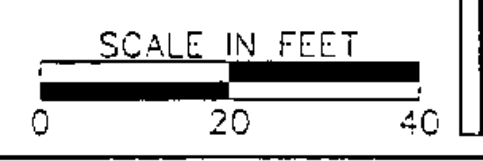

321
 SHELBURNE
 SURVEYED BY V.S.C. INC. DATE _____
 DRAWN BY E.A.A. INC. DATE _____
 TRACED BY E.A.A. INC. DATE _____
 PROJECT NH-EGC-019-4(27)
 PROFILE DRAWING NO. 12
 SHEET NO. 139 OF 537