



DATE \_\_\_\_\_  
 BY \_\_\_\_\_  
 CHECKED \_\_\_\_\_  
 ROUTED \_\_\_\_\_  
 DATE \_\_\_\_\_  
 PROJECT NO. \_\_\_\_\_  
 SHEET NO. \_\_\_\_\_

DATE \_\_\_\_\_  
 BY \_\_\_\_\_  
 CHECKED \_\_\_\_\_  
 ROUTED \_\_\_\_\_  
 DATE \_\_\_\_\_  
 PROJECT NO. \_\_\_\_\_  
 SHEET NO. \_\_\_\_\_

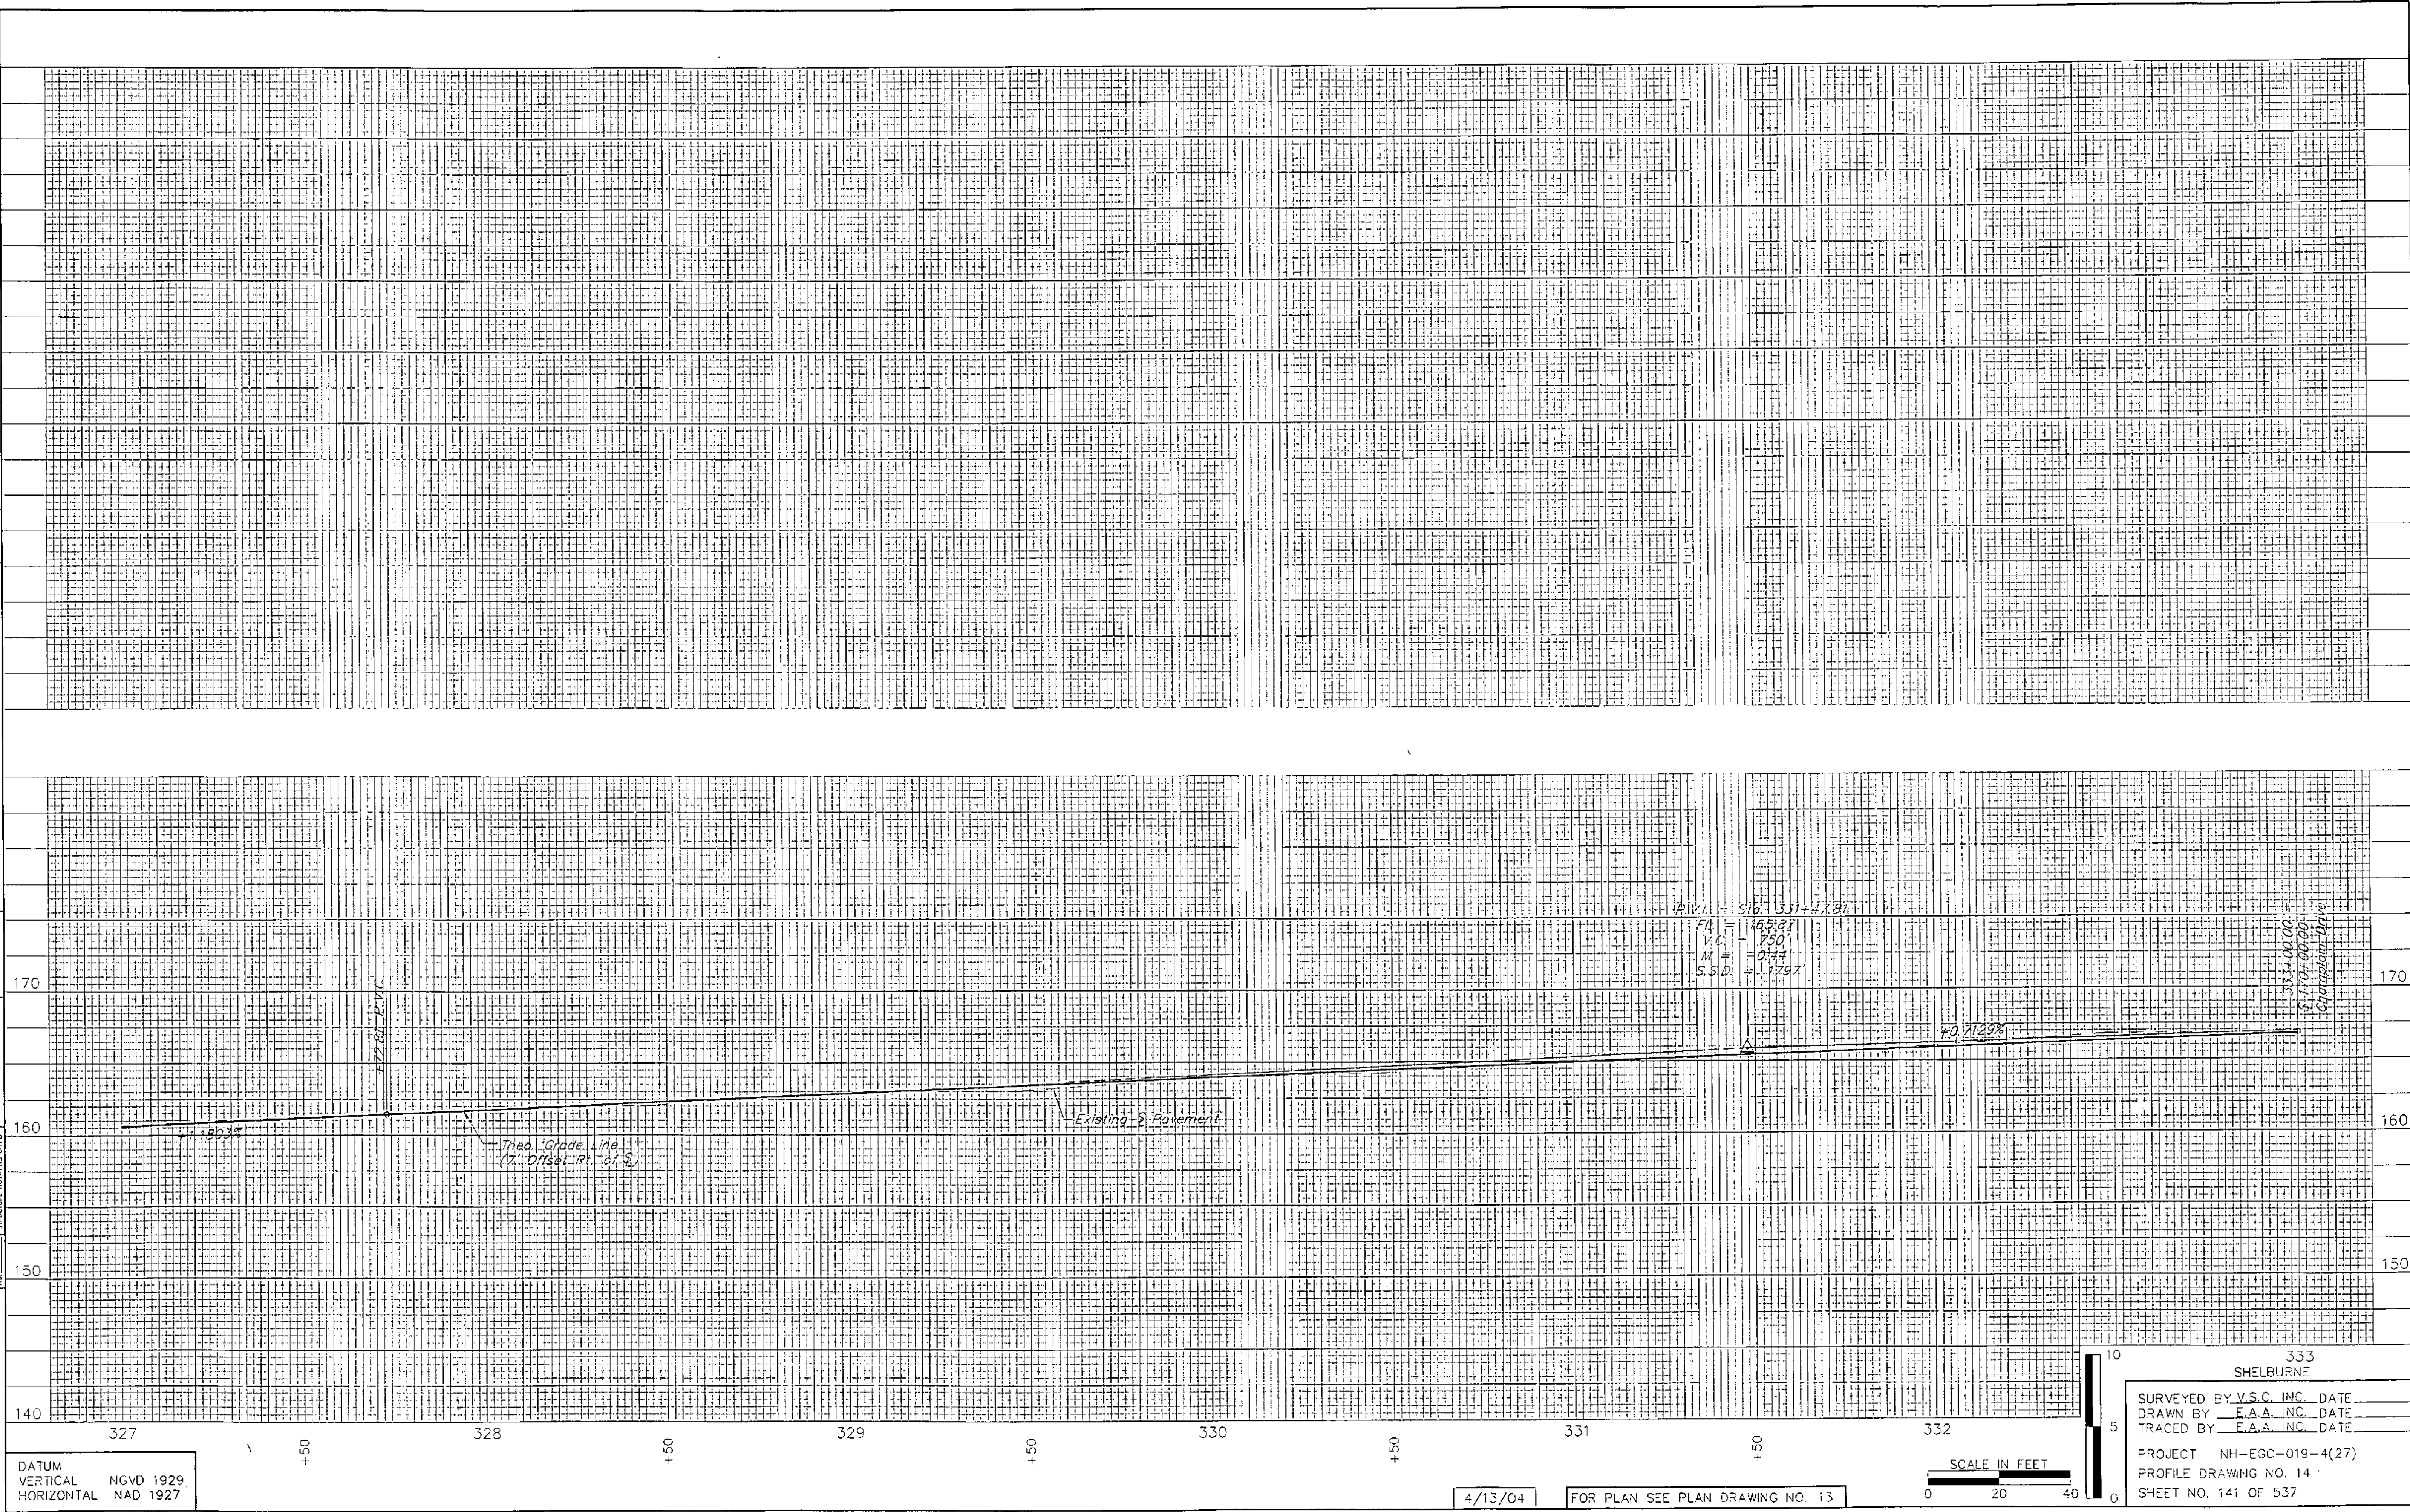

DATUM  
 VERTICAL NGVD 1929  
 HORIZONTAL NAD 1927

4/13/04 FOR PLAN SEE PLAN DRAWING NO. 13

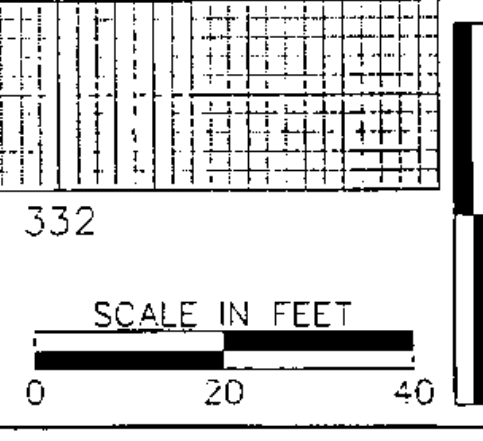

333  
 SHELBURNE  
 SURVEYED BY V.S.C. INC. DATE \_\_\_\_\_  
 DRAWN BY E.A.A. INC. DATE \_\_\_\_\_  
 TRACED BY E.A.A. INC. DATE \_\_\_\_\_  
 PROJECT NH-EGC-019-4(27)  
 PROFILE DRAWING NO. 14  
 SHEET NO. 141 OF 537