



DATE: _____ BY: _____
 PLAN
 NOTE BOOK NO. _____
 DATE: _____

DATE: _____ BY: _____
 PROFILE
 NOTE BOOK NO. _____
 DATE: _____

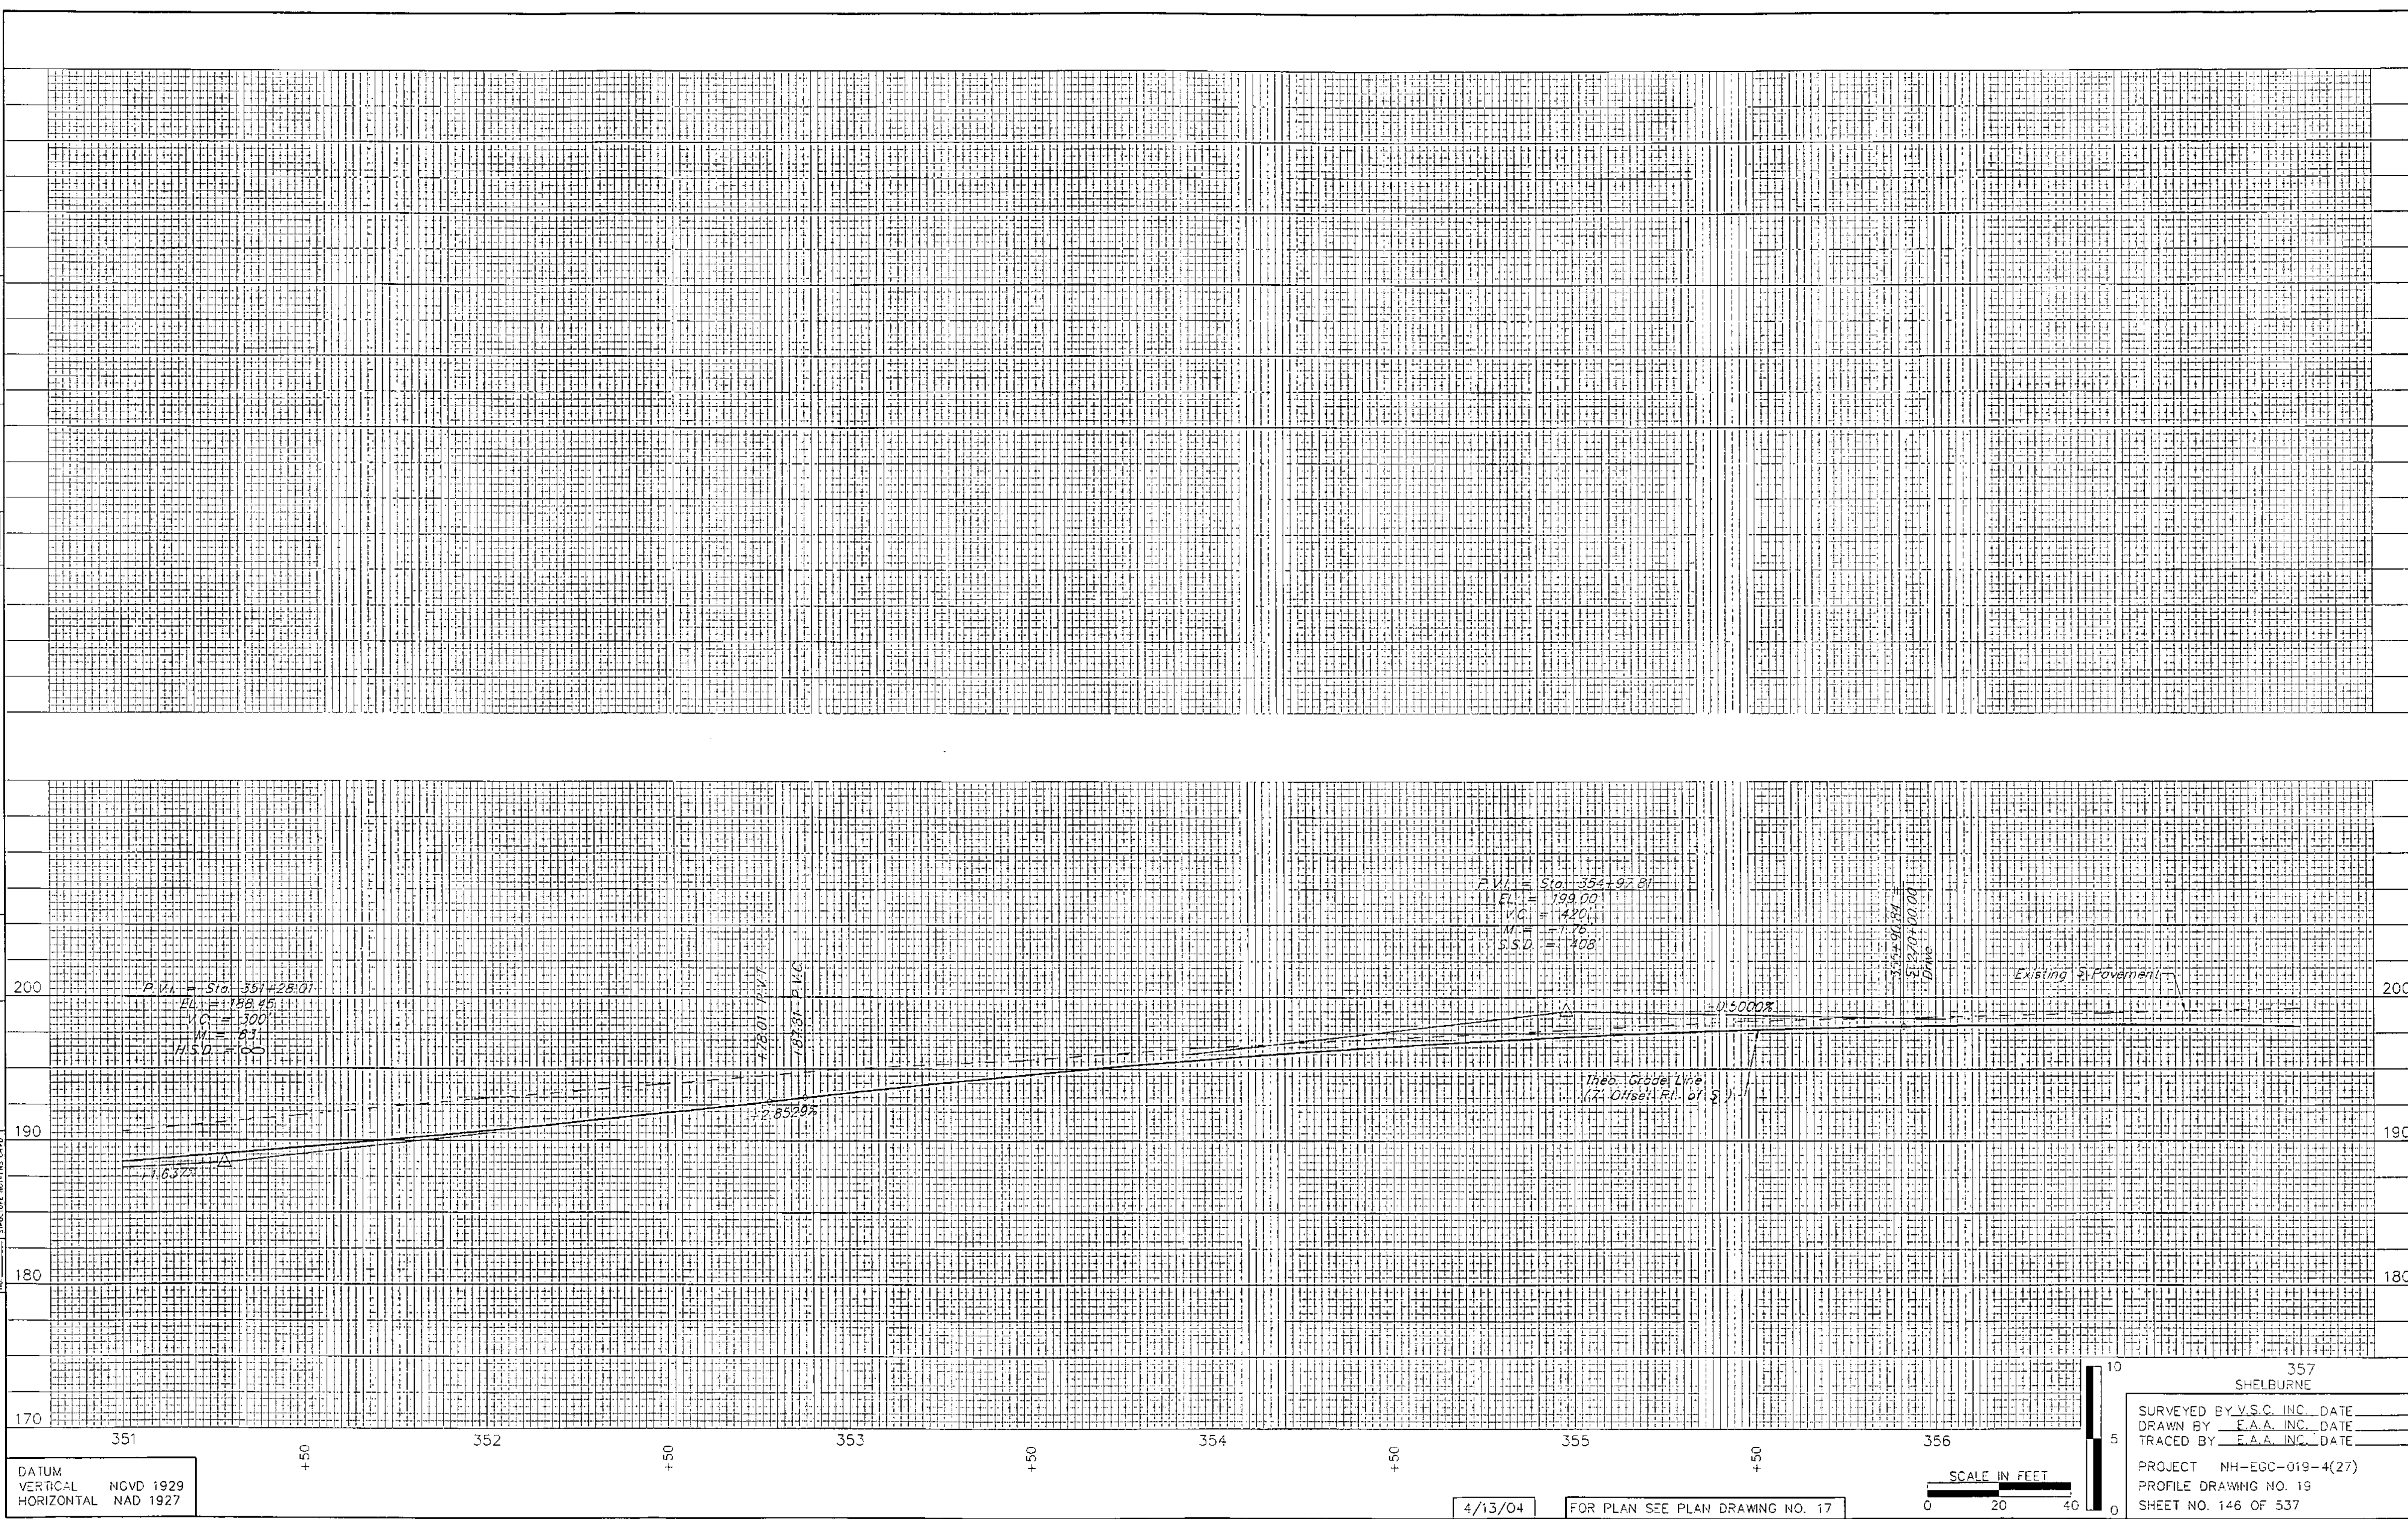

DATUM
 VERTICAL NGVD 1929
 HORIZONTAL NAD 1927

4/13/04 FOR PLAN SEE PLAN DRAWING NO. 17

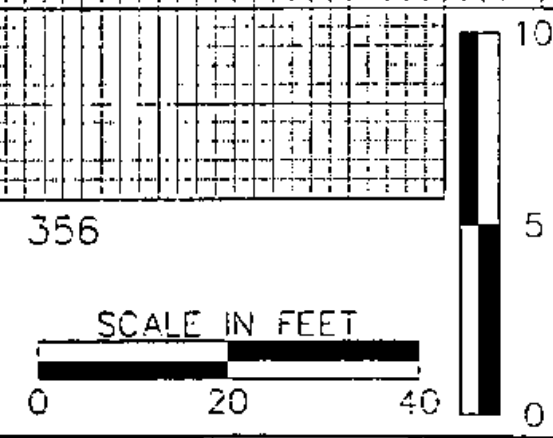

357
 SHELBURNE
 SURVEYED BY V.S.C. INC. DATE _____
 DRAWN BY E.A.A. INC. DATE _____
 TRACED BY E.A.A. INC. DATE _____
 PROJECT NH-EGC-019-4(27)
 PROFILE DRAWING NO. 19
 SHEET NO. 146 OF 537