



DATE _____ BY _____
 PLAN
 DATE REVISION
 NO. 001
 NO. 002
 NO. 003

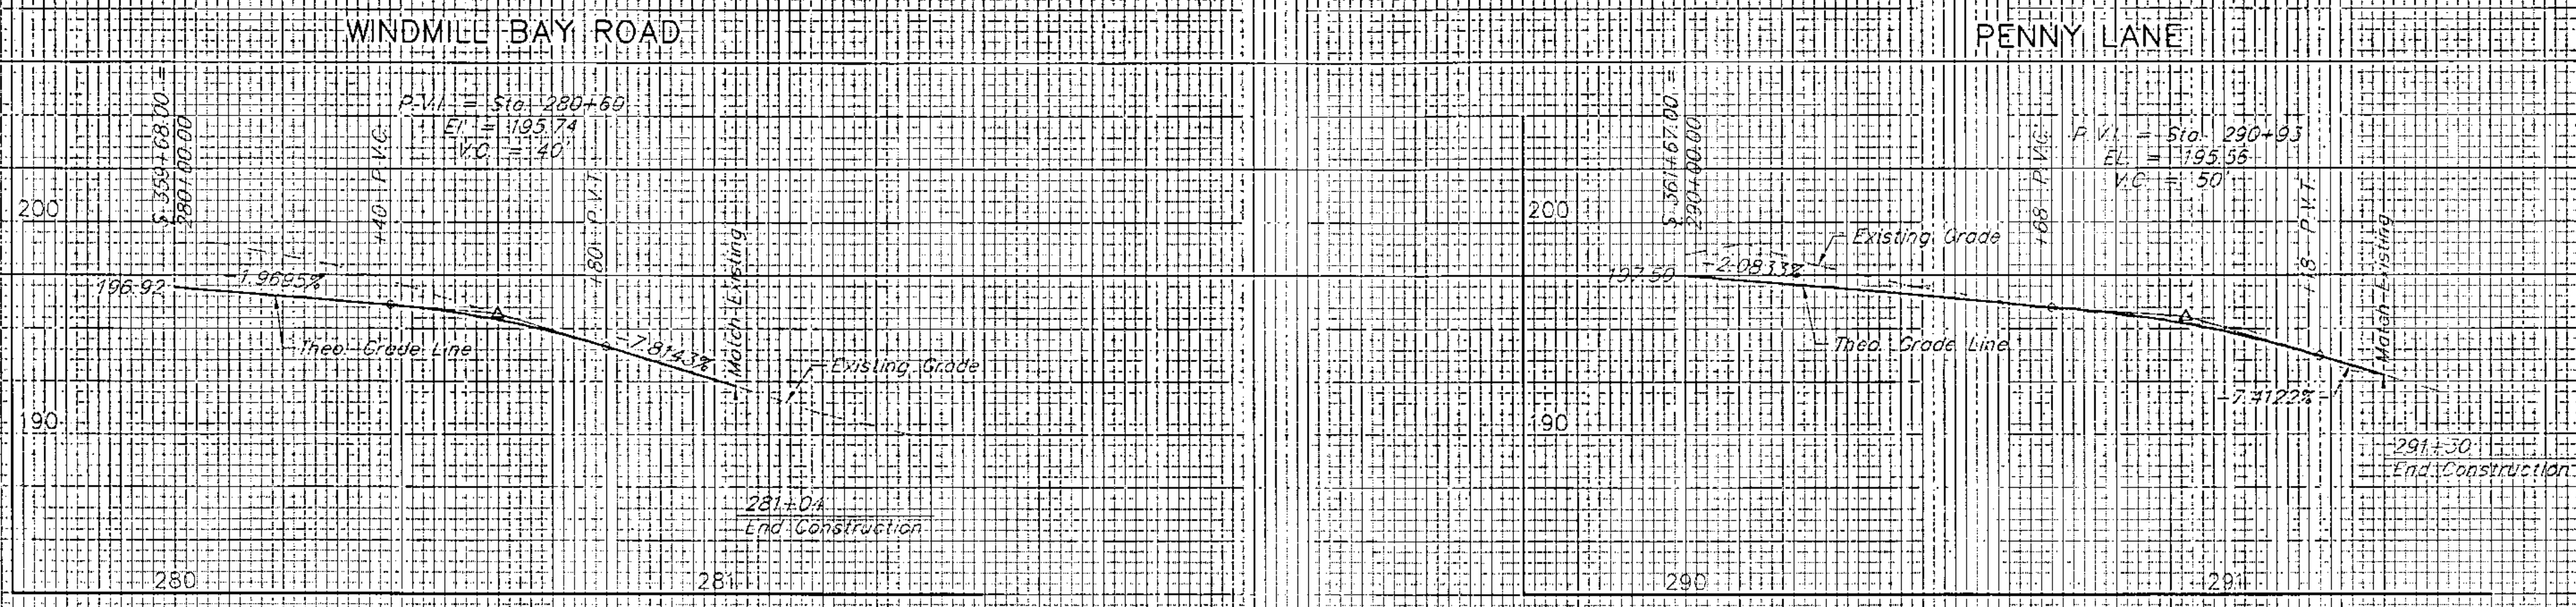


DATE _____ BY _____
 PROFILE
 DATE REVISION
 NO. 001
 NO. 002
 NO. 003

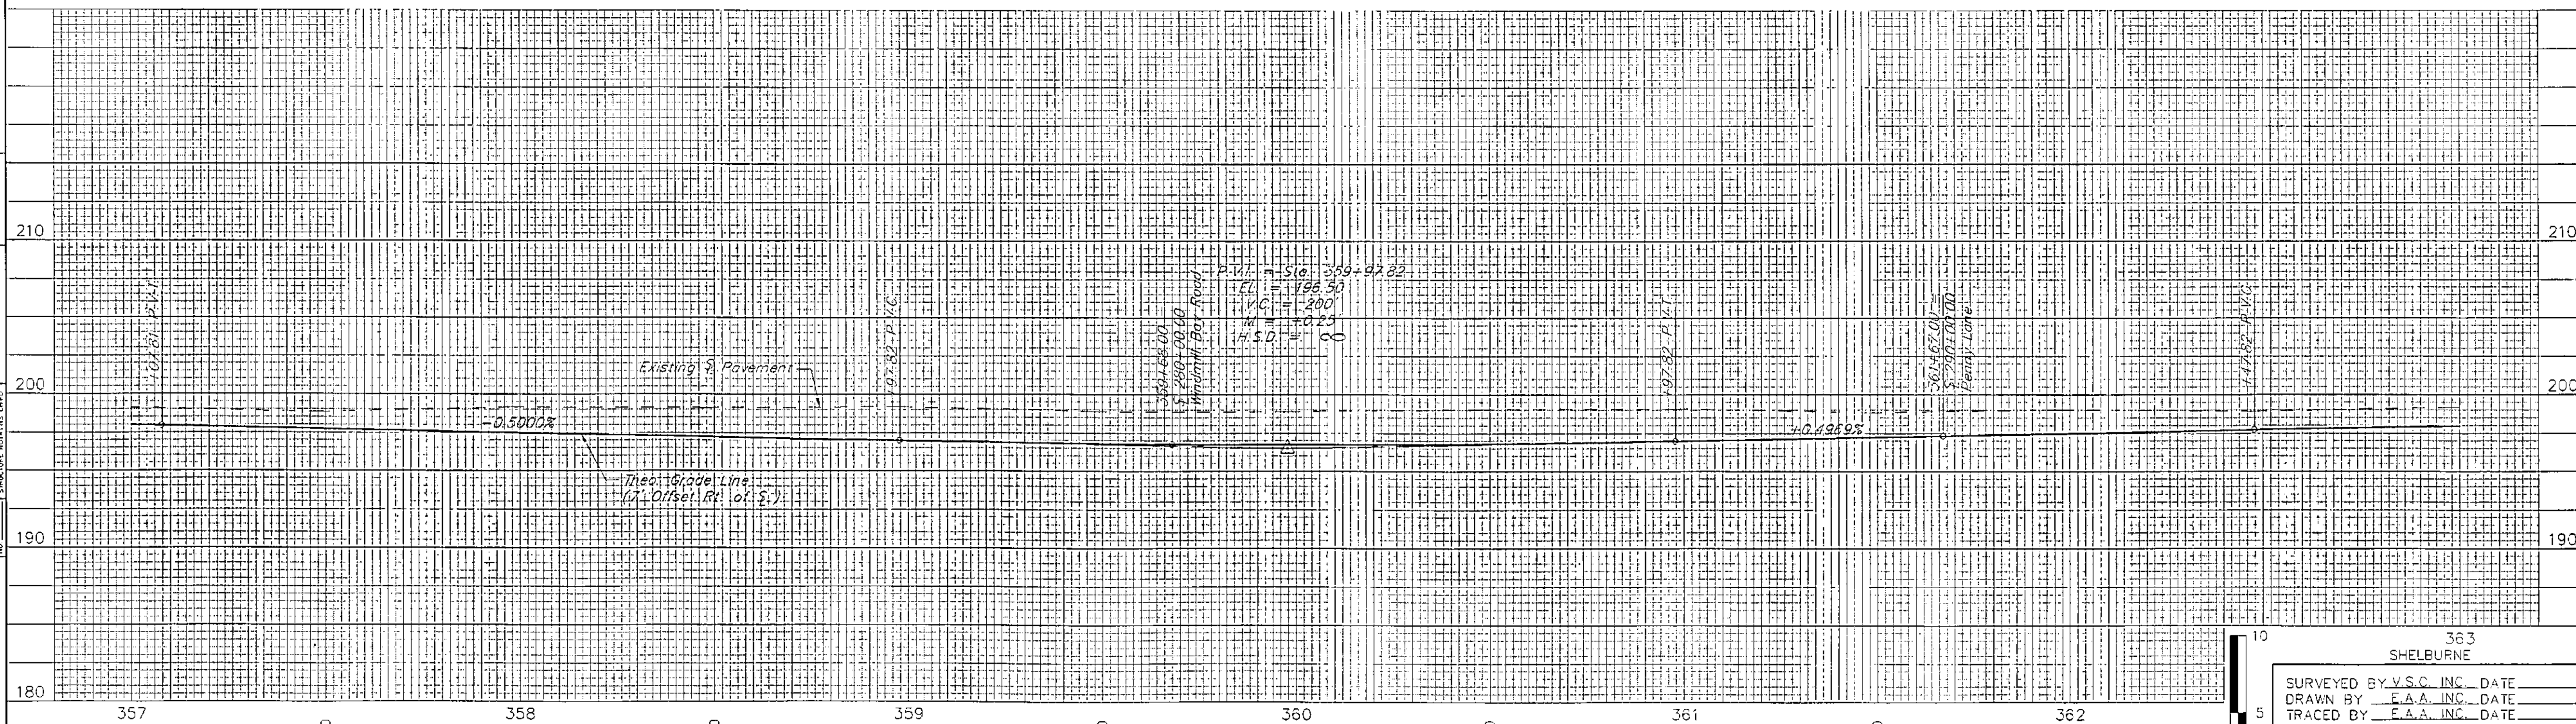

DATUM
 VERTICAL NGVD 1929
 HORIZONTAL NAD 1927

4/13/04 FOR PLAN SEE PLAN DRAWING NO. 18

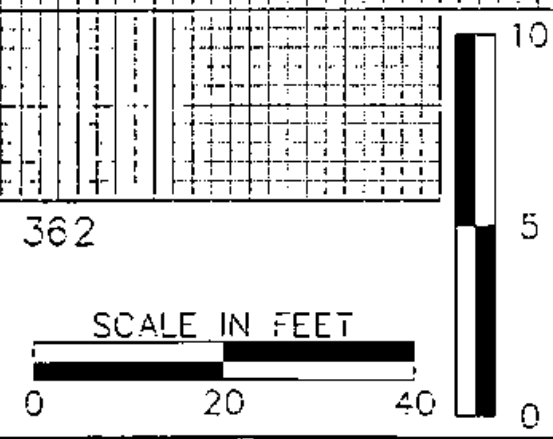

363
 SHELburne
 SURVEYED BY V.S.C. INC. DATE _____
 DRAWN BY E.A.A. INC. DATE _____
 TRACED BY E.A.A. INC. DATE _____
 PROJECT NH-EGC-019-4(27)
 PROFILE DRAWING NO. 20
 SHEET NO. 147 OF 537