
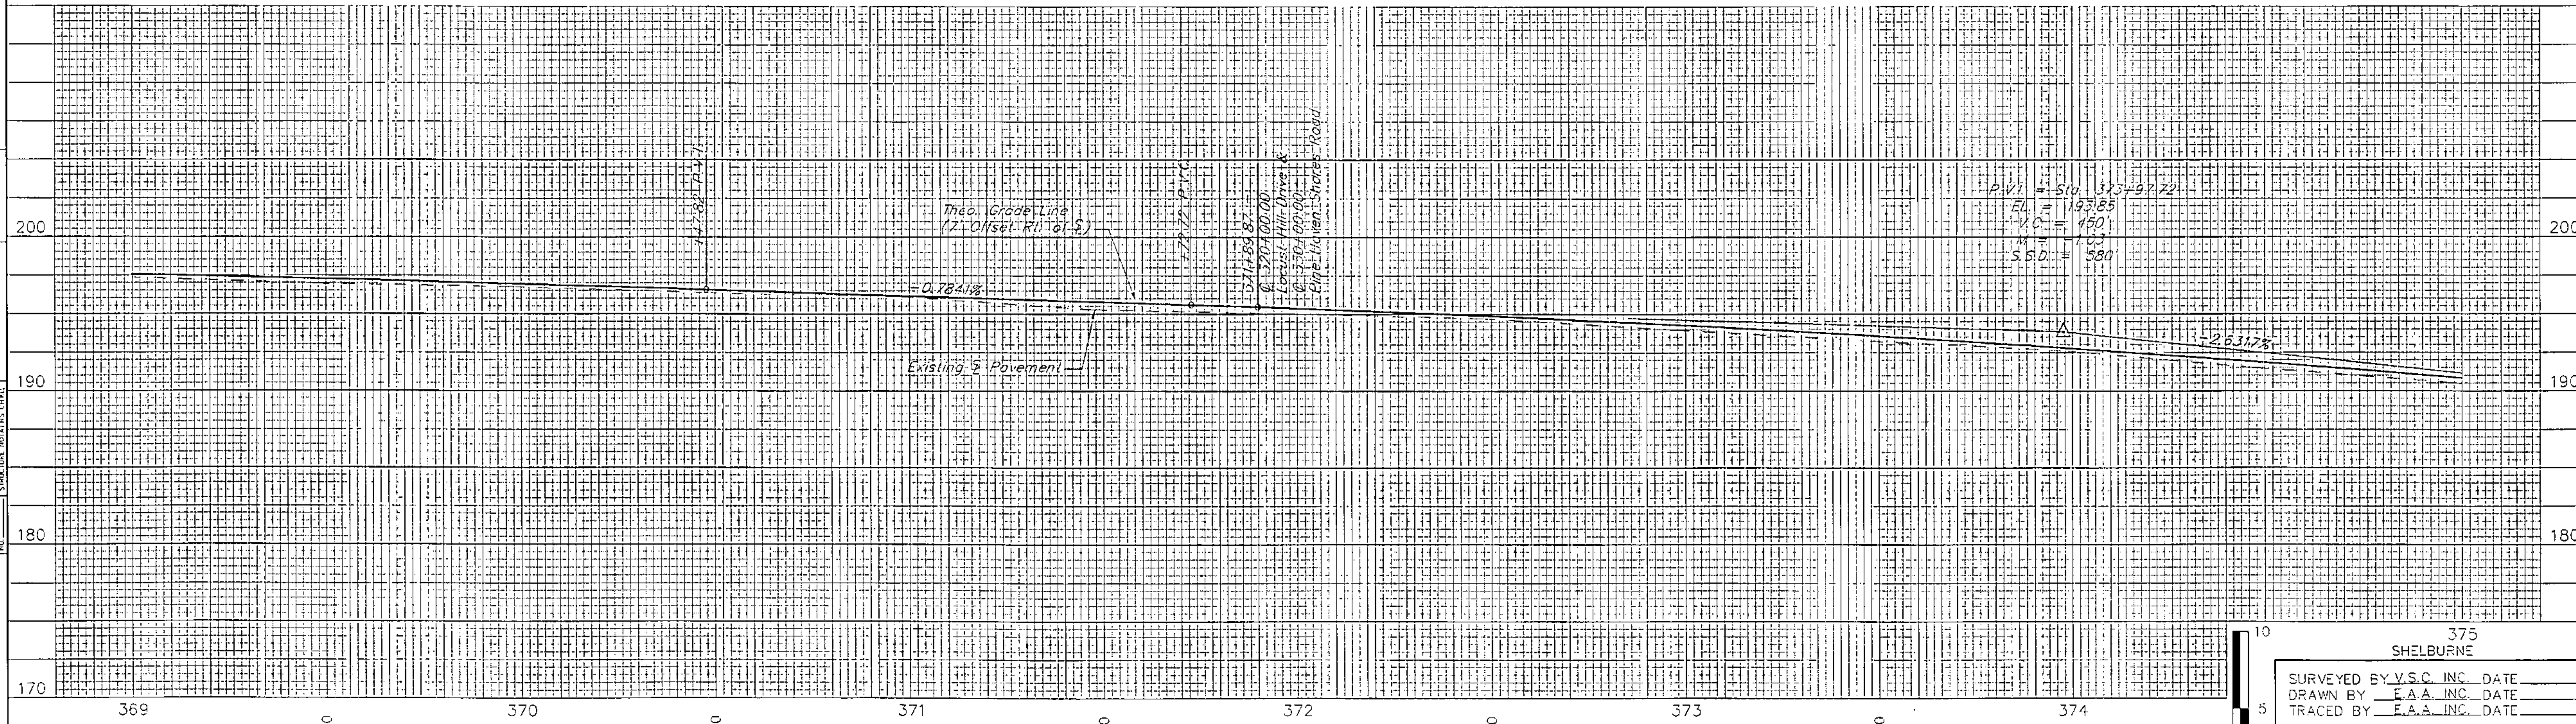



PLAN
 DATE
 BY
 PROJECT NO.
 DRAWING NO.
 SHEET NO.

PROFILE
 DATE
 BY
 PROJECT NO.
 DRAWING NO.
 SHEET NO.

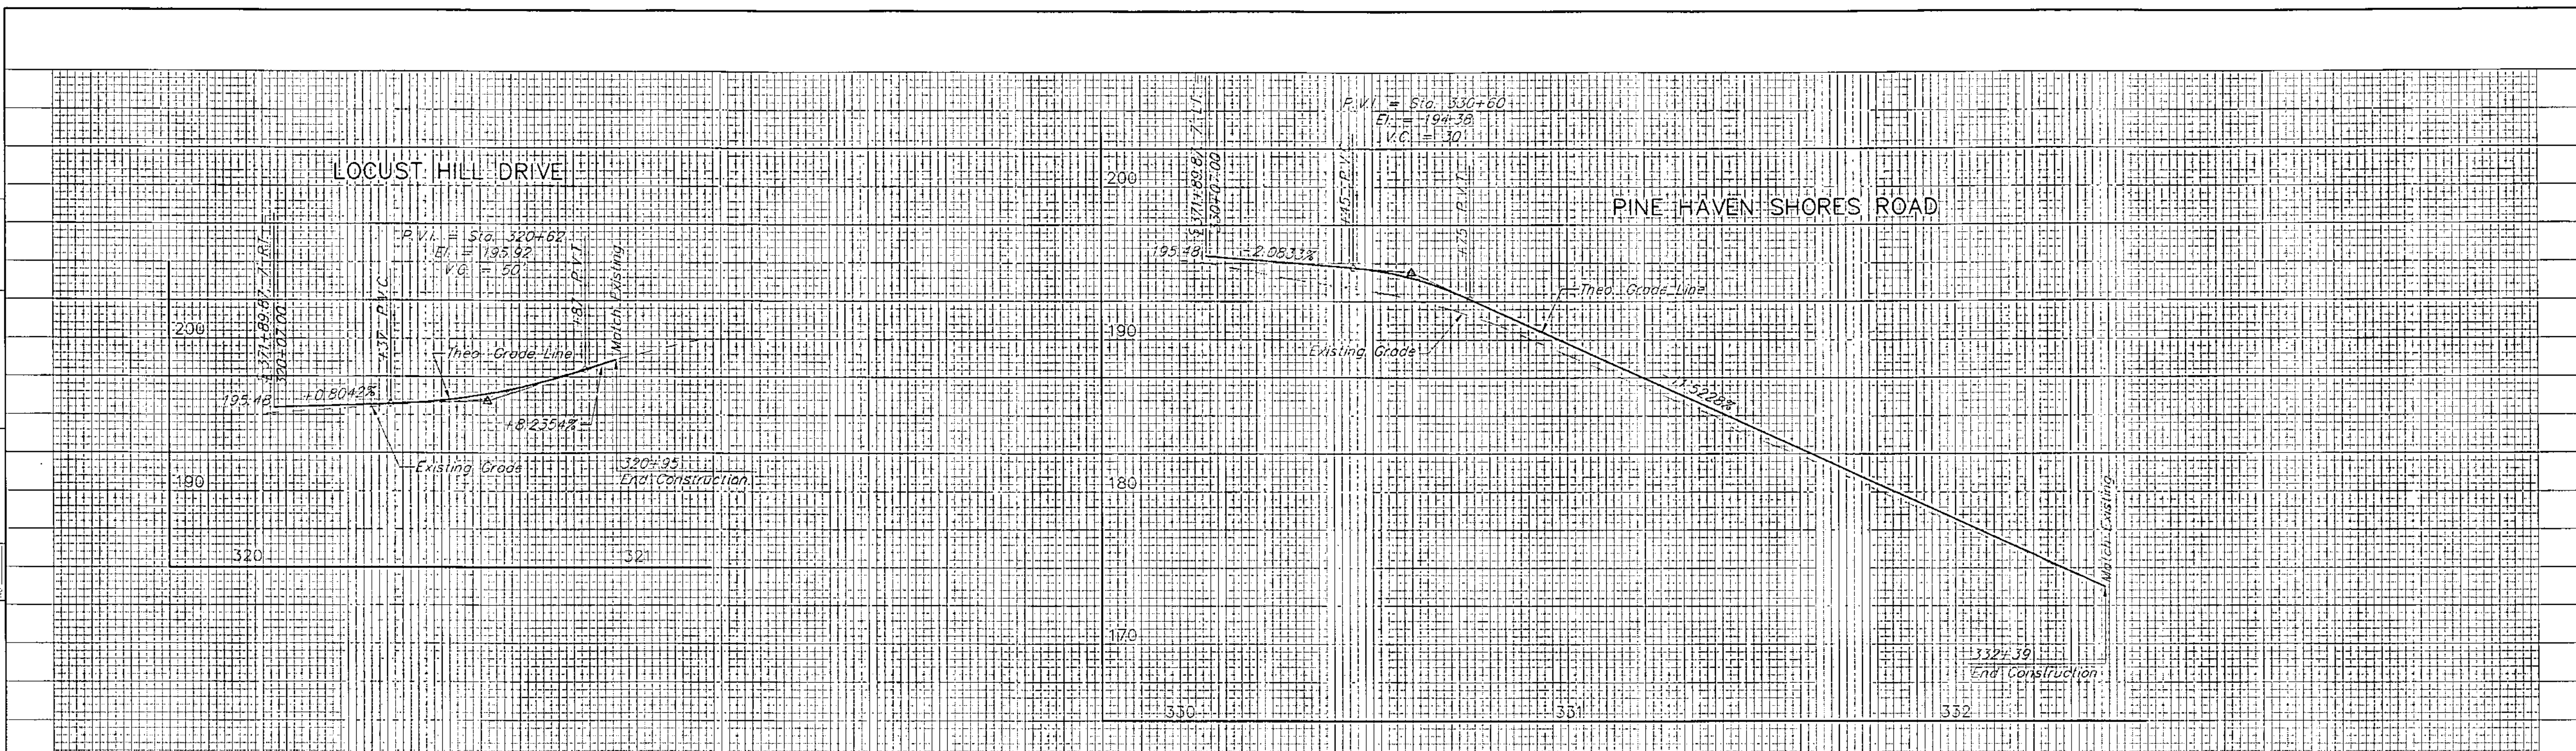

DATUM
 VERTICAL NGVD 1929
 HORIZONTAL NAD 1927

4/13/04 FOR PLAN SEE PLAN DRAWING NO. 20

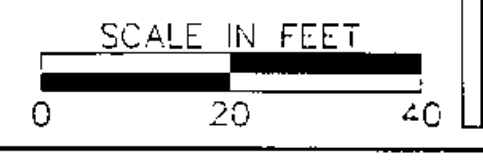

375
 SHELburne
 SURVEYED BY V.S.C. INC. DATE _____
 DRAWN BY E.A.A. INC. DATE _____
 TRACED BY E.A.A. INC. DATE _____
 PROJECT NH-EGC-019-4(27)
 PROFILE DRAWING NO. 22
 SHEET NO. 149 OF 537