



PLAN  
 DATE: \_\_\_\_\_  
 BY: \_\_\_\_\_  
 CHECKED BY: \_\_\_\_\_  
 DATE: \_\_\_\_\_  
 PROJECT NO. \_\_\_\_\_  
 SHEET NO. \_\_\_\_\_

PROFILE  
 DATE: \_\_\_\_\_  
 BY: \_\_\_\_\_  
 CHECKED BY: \_\_\_\_\_  
 DATE: \_\_\_\_\_  
 PROJECT NO. \_\_\_\_\_  
 SHEET NO. \_\_\_\_\_

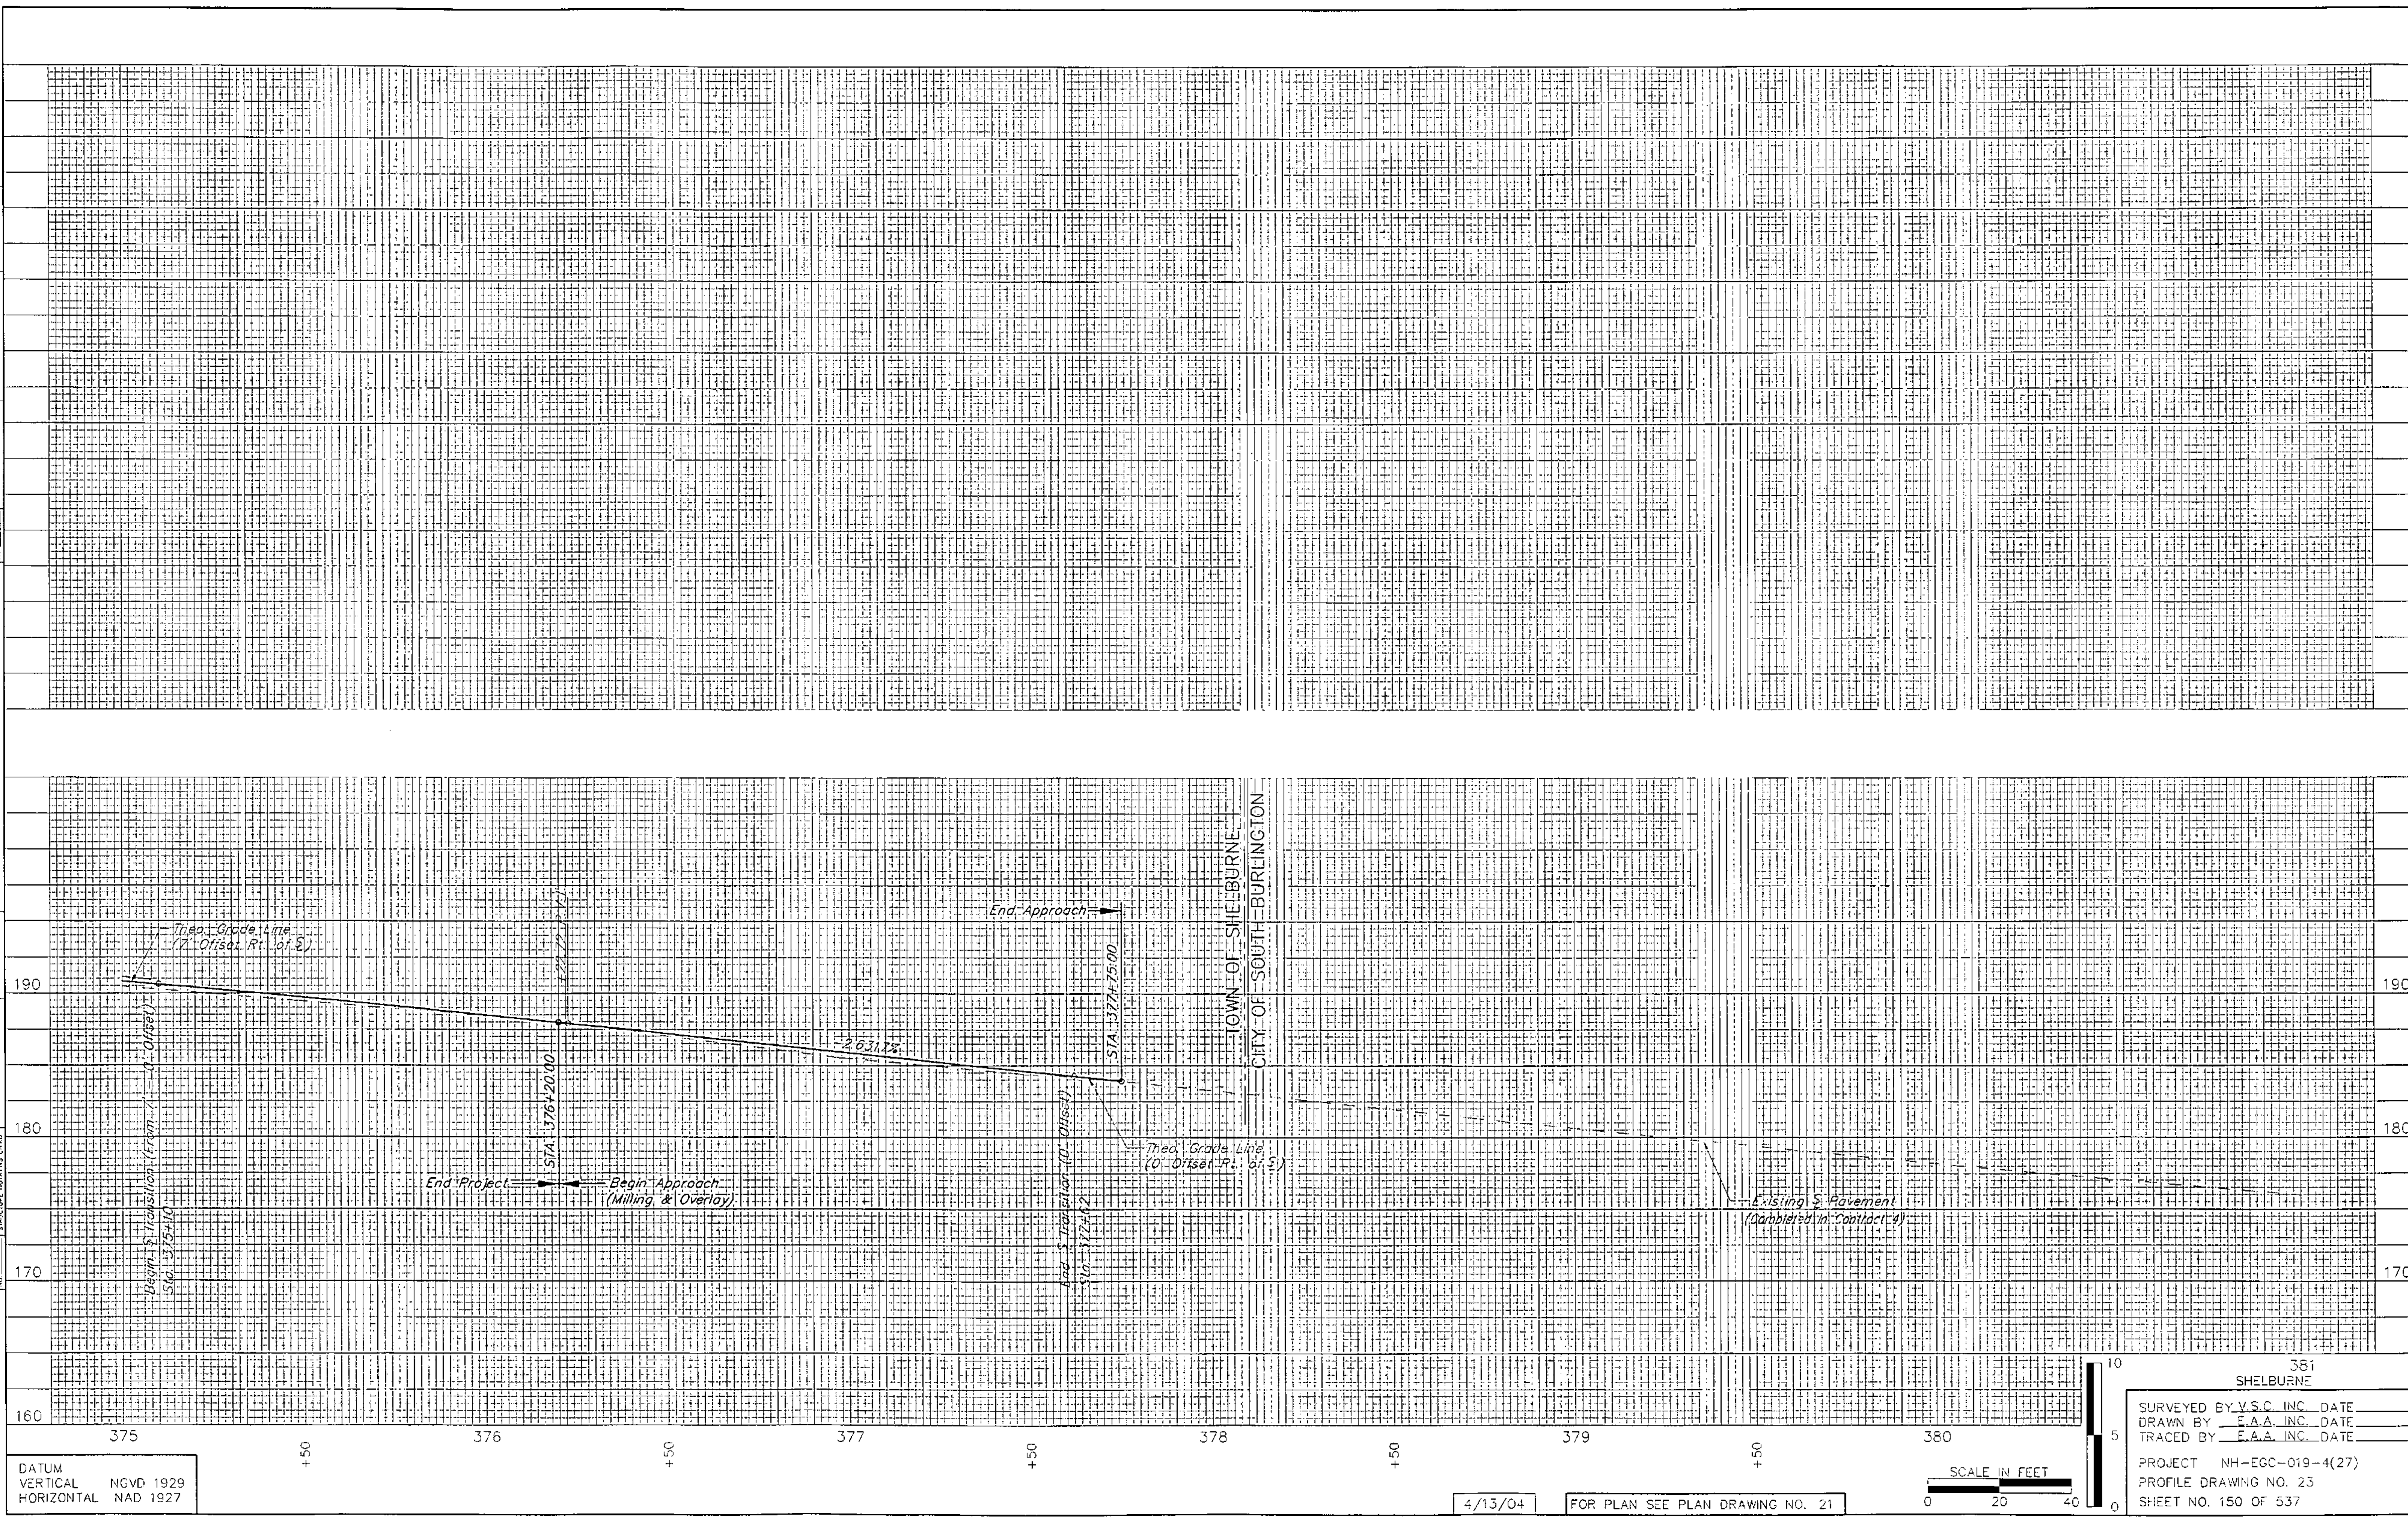

DATUM  
 VERTICAL NGVD 1929  
 HORIZONTAL NAD 1927

4/13/04 FOR PLAN SEE PLAN DRAWING NO. 21

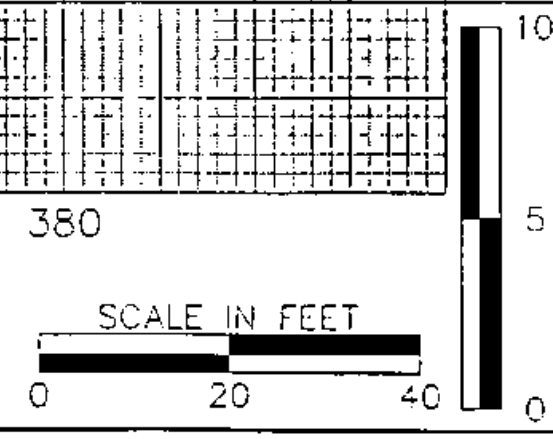

381  
 SHELBURNE  
 SURVEYED BY V.S.C. INC. DATE \_\_\_\_\_  
 DRAWN BY E.A.A. INC. DATE \_\_\_\_\_  
 TRACED BY E.A.A. INC. DATE \_\_\_\_\_  
 PROJECT NH-EGC-019-4(27)  
 PROFILE DRAWING NO. 23  
 SHEET NO. 150 OF 537