


DATE \_\_\_\_\_ BY \_\_\_\_\_  
 PLAN  
 SCALE TO BE SHOWN  
 NOTE BOOK NO. \_\_\_\_\_

DATE \_\_\_\_\_ BY \_\_\_\_\_  
 PROFILE  
 SCALE TO BE SHOWN  
 NOTE BOOK NO. \_\_\_\_\_

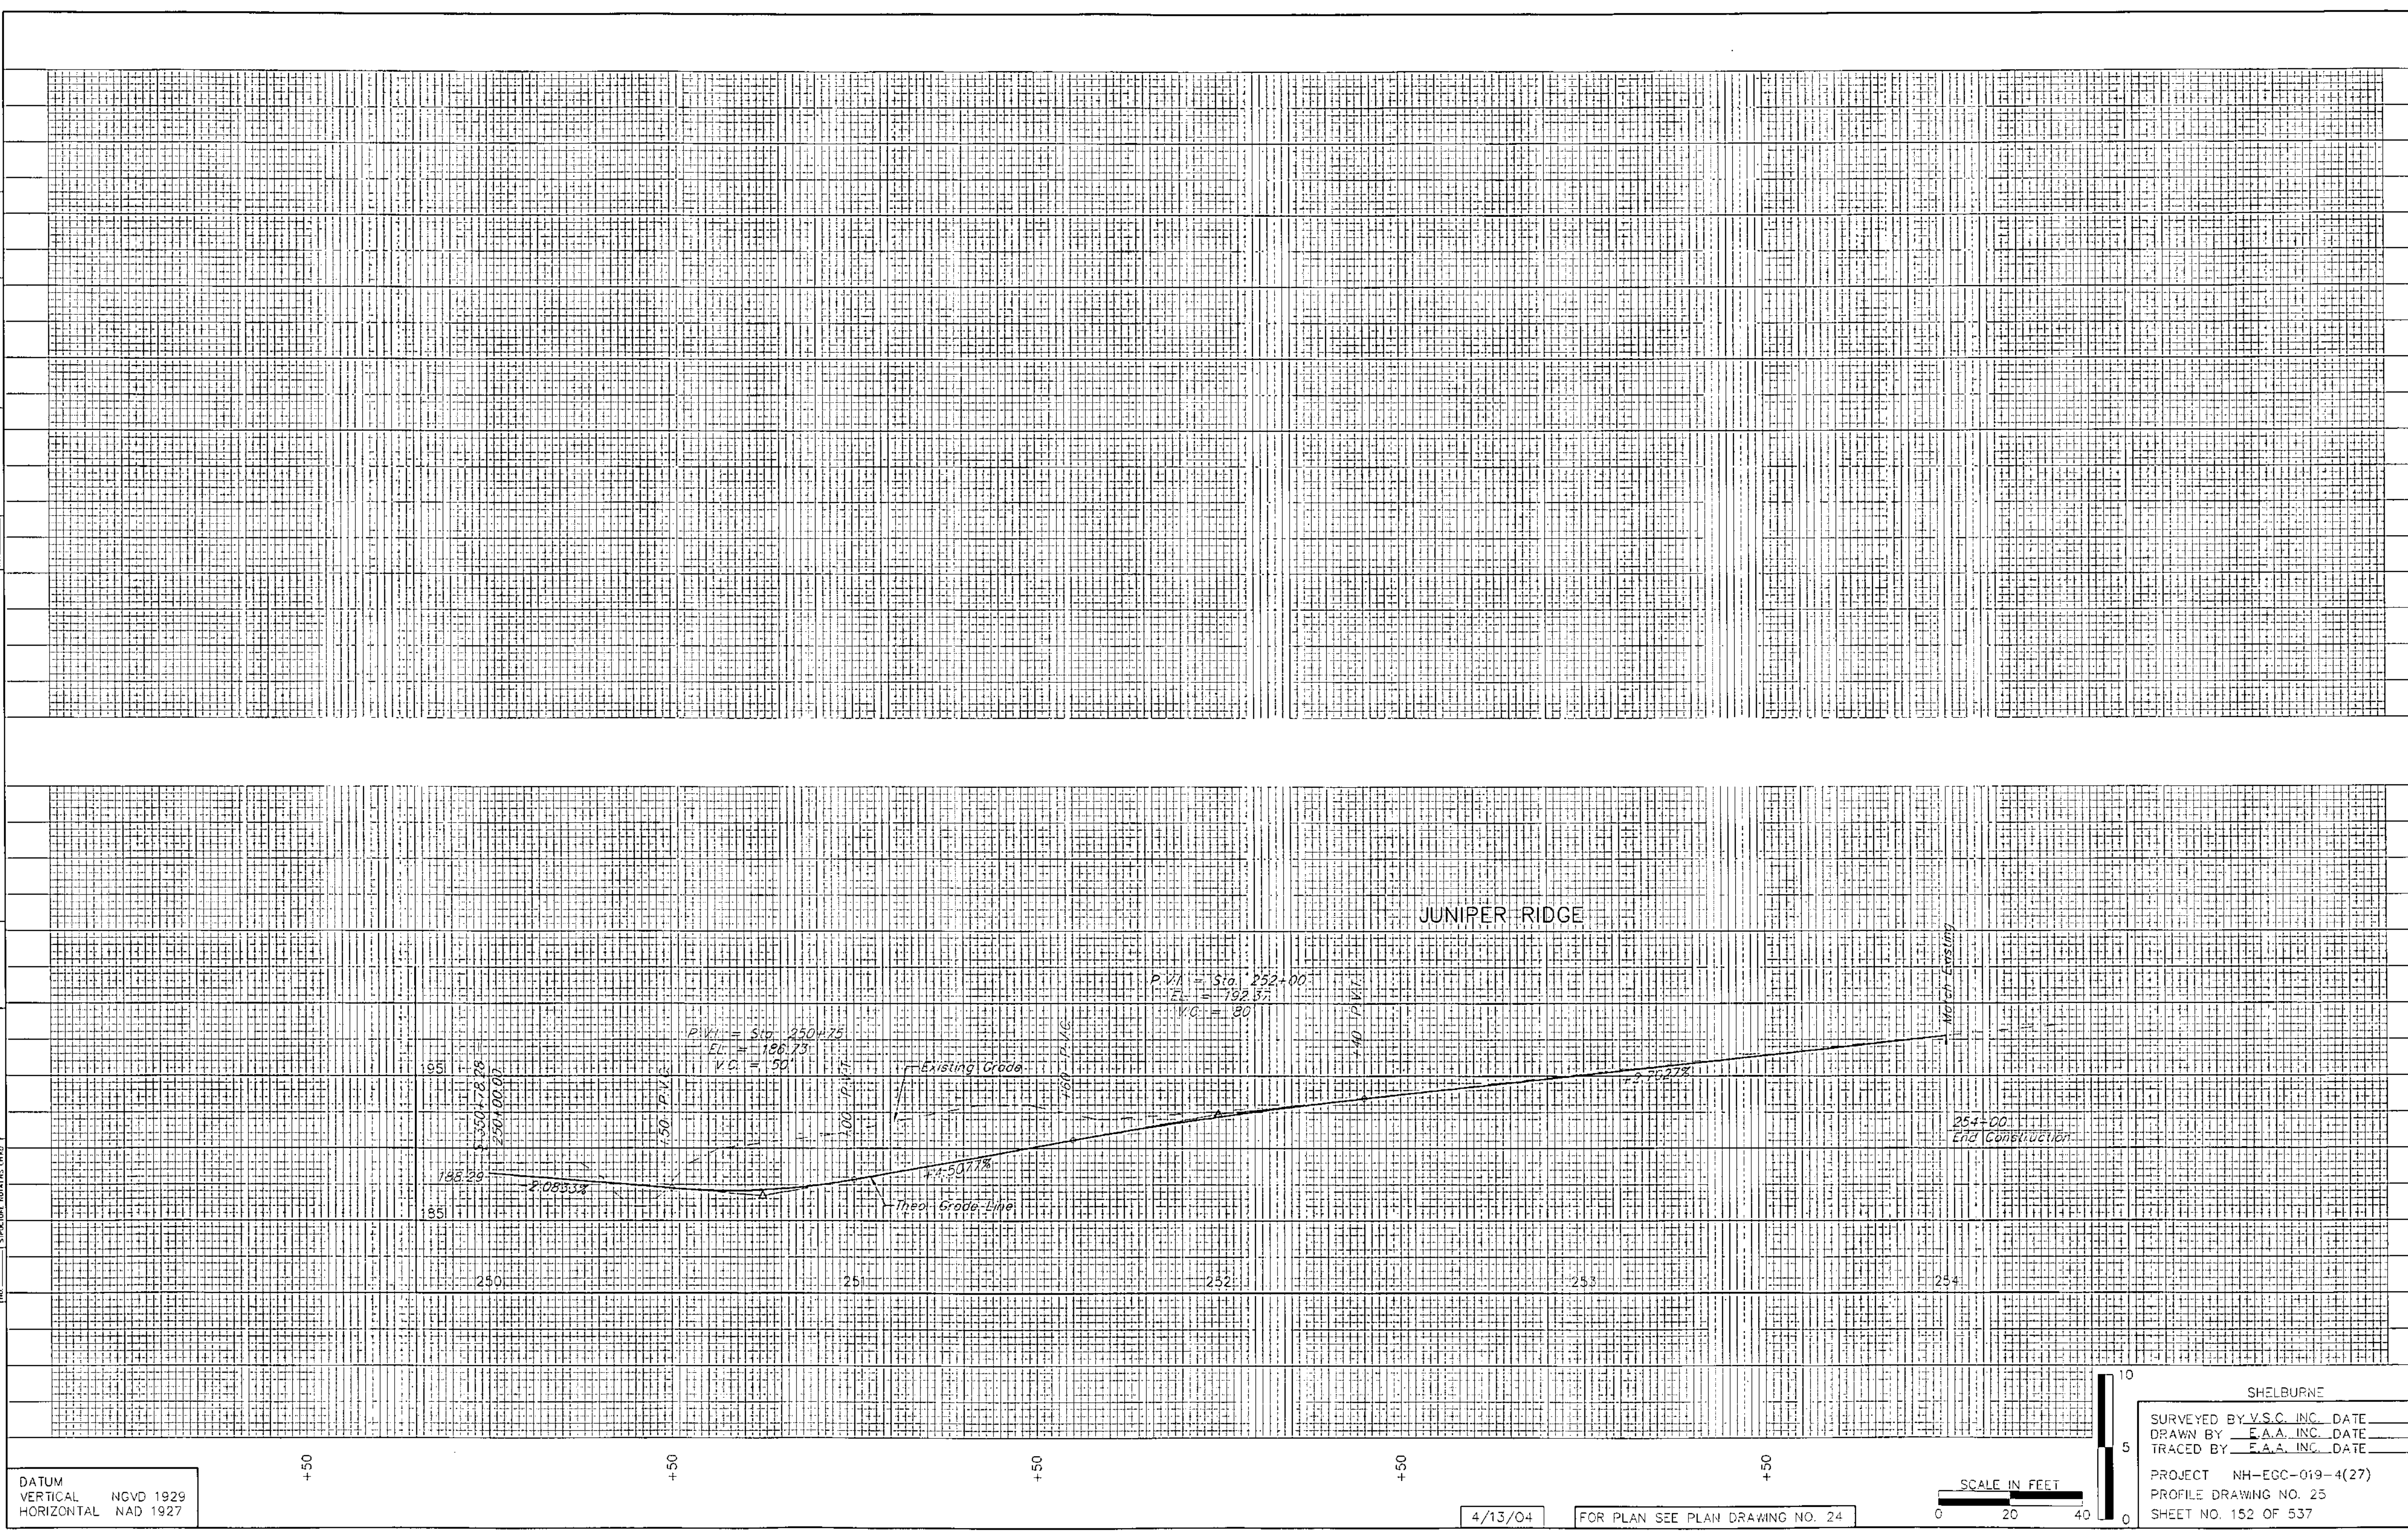

DATUM  
 VERTICAL NGVD 1929  
 HORIZONTAL NAD 1927

4/13/04 FOR PLAN SEE PLAN DRAWING NO. 24

SHELBURNE  
 SURVEYED BY V.S.C. INC. DATE \_\_\_\_\_  
 DRAWN BY E.A.A. INC. DATE \_\_\_\_\_  
 TRACED BY E.A.A. INC. DATE \_\_\_\_\_  
 PROJECT NH-EGC-019-4(27)  
 PROFILE DRAWING NO. 25  
 SHEET NO. 152 OF 537