




U.S. ROUTE 7
SHELburne ROAD

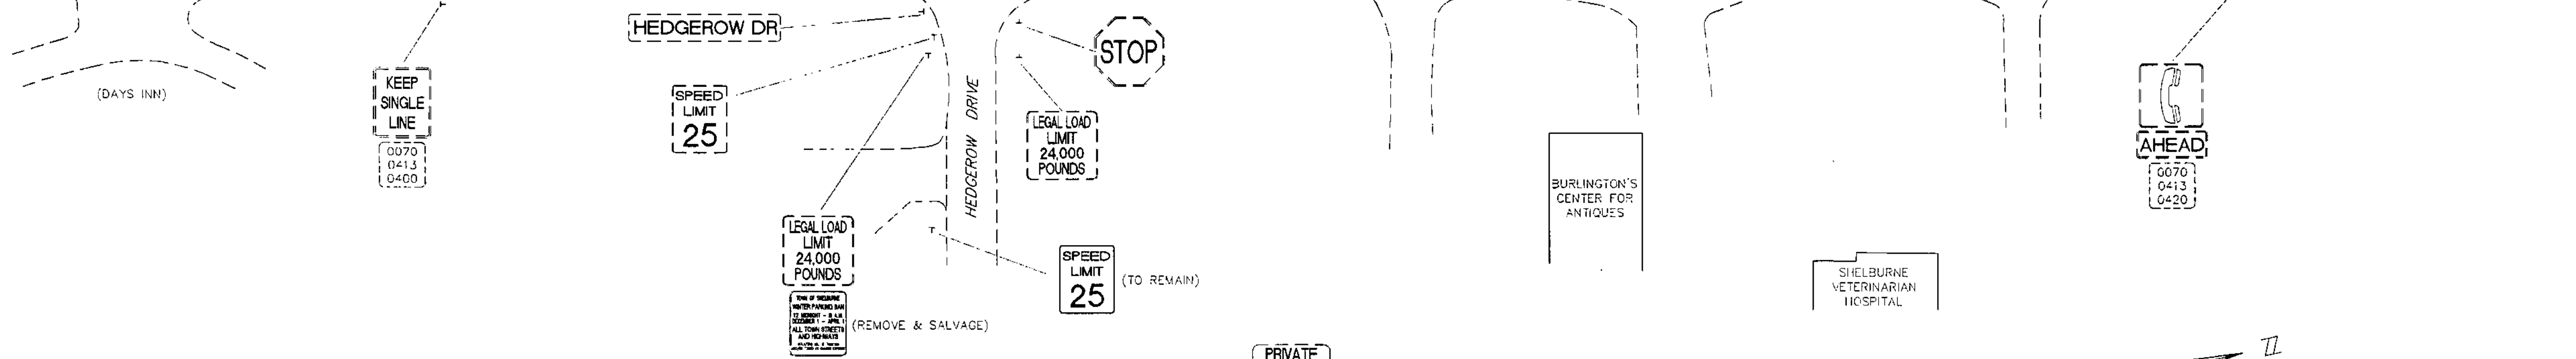

U.S. ROUTE 7
SHELburne ROAD

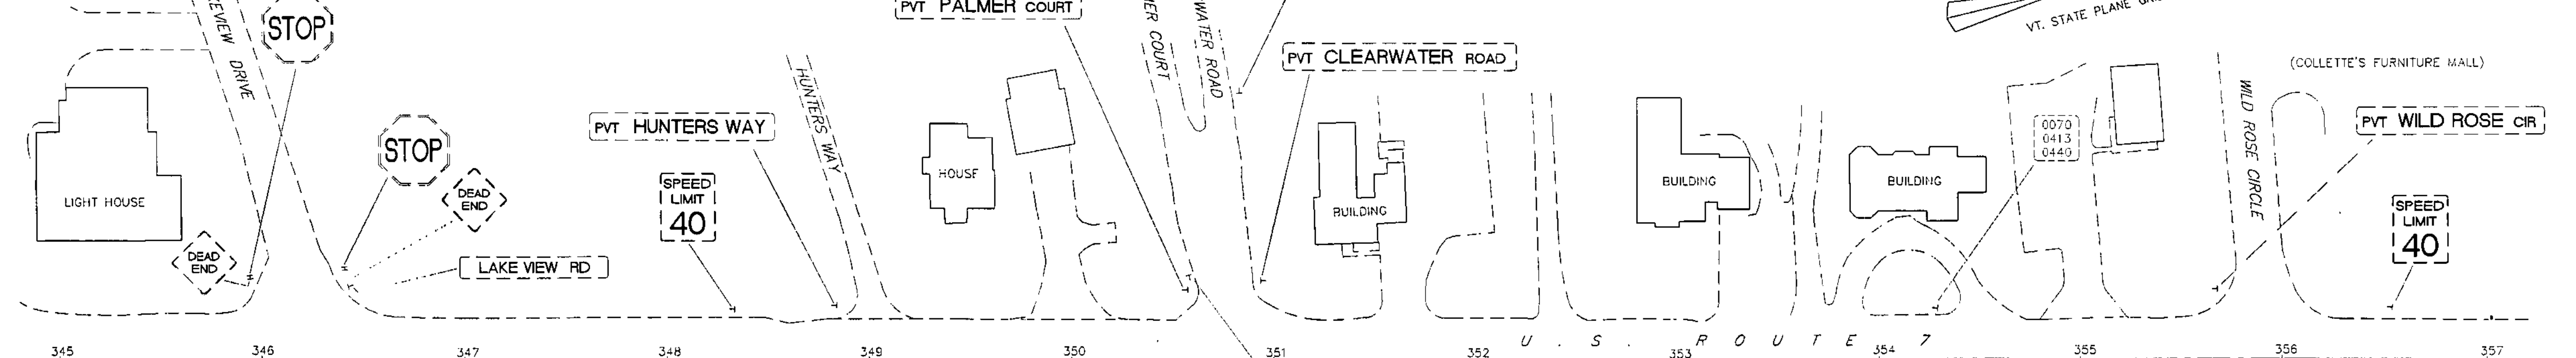

U.S. ROUTE 7
SHELburne ROAD

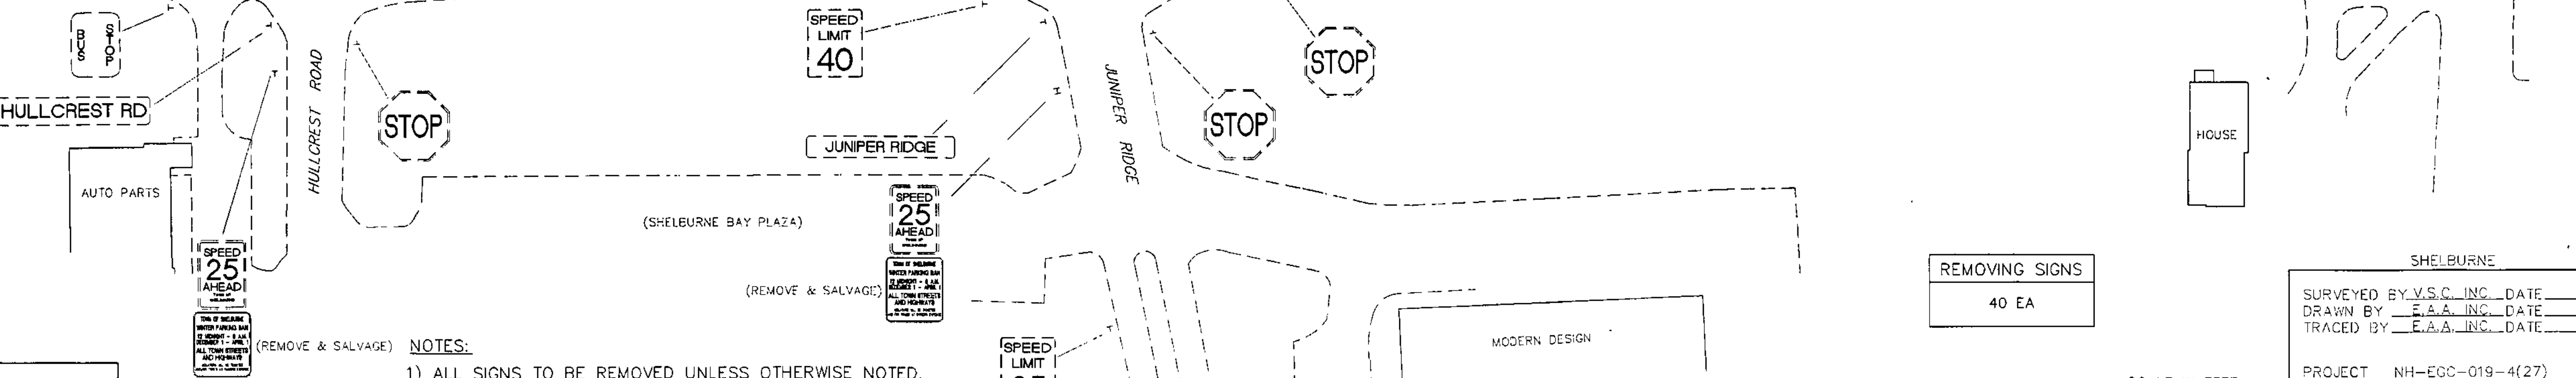

DATUM
VERTICAL NGVD 1929
HORIZONTAL NAD 1927

- NOTES:
- 1) ALL SIGNS TO BE REMOVED UNLESS OTHERWISE NOTED.
 - 2) TIS SIGNS SHALL NOT BE REMOVED FOR MORE THAN 2 WEEKS.

REMOVING SIGNS
40 EA

SHELburne
SURVEYED BY V.S.C. INC. DATE _____
DRAWN BY E.A.A. INC. DATE _____
TRACED BY E.A.A. INC. DATE _____
PROJECT NH-EGC-019-4(27)
SIGN REMOVAL DWG. NO. 4
SHEET NO. 156 OF 537

SCALE IN FEET
0 100 200
4/13/04