


MATCH TO STRIPING DRAWING NO. 9, STA. 309+00

MATCH TO STRIPING DRAWING NO. 11, STA. 315+00

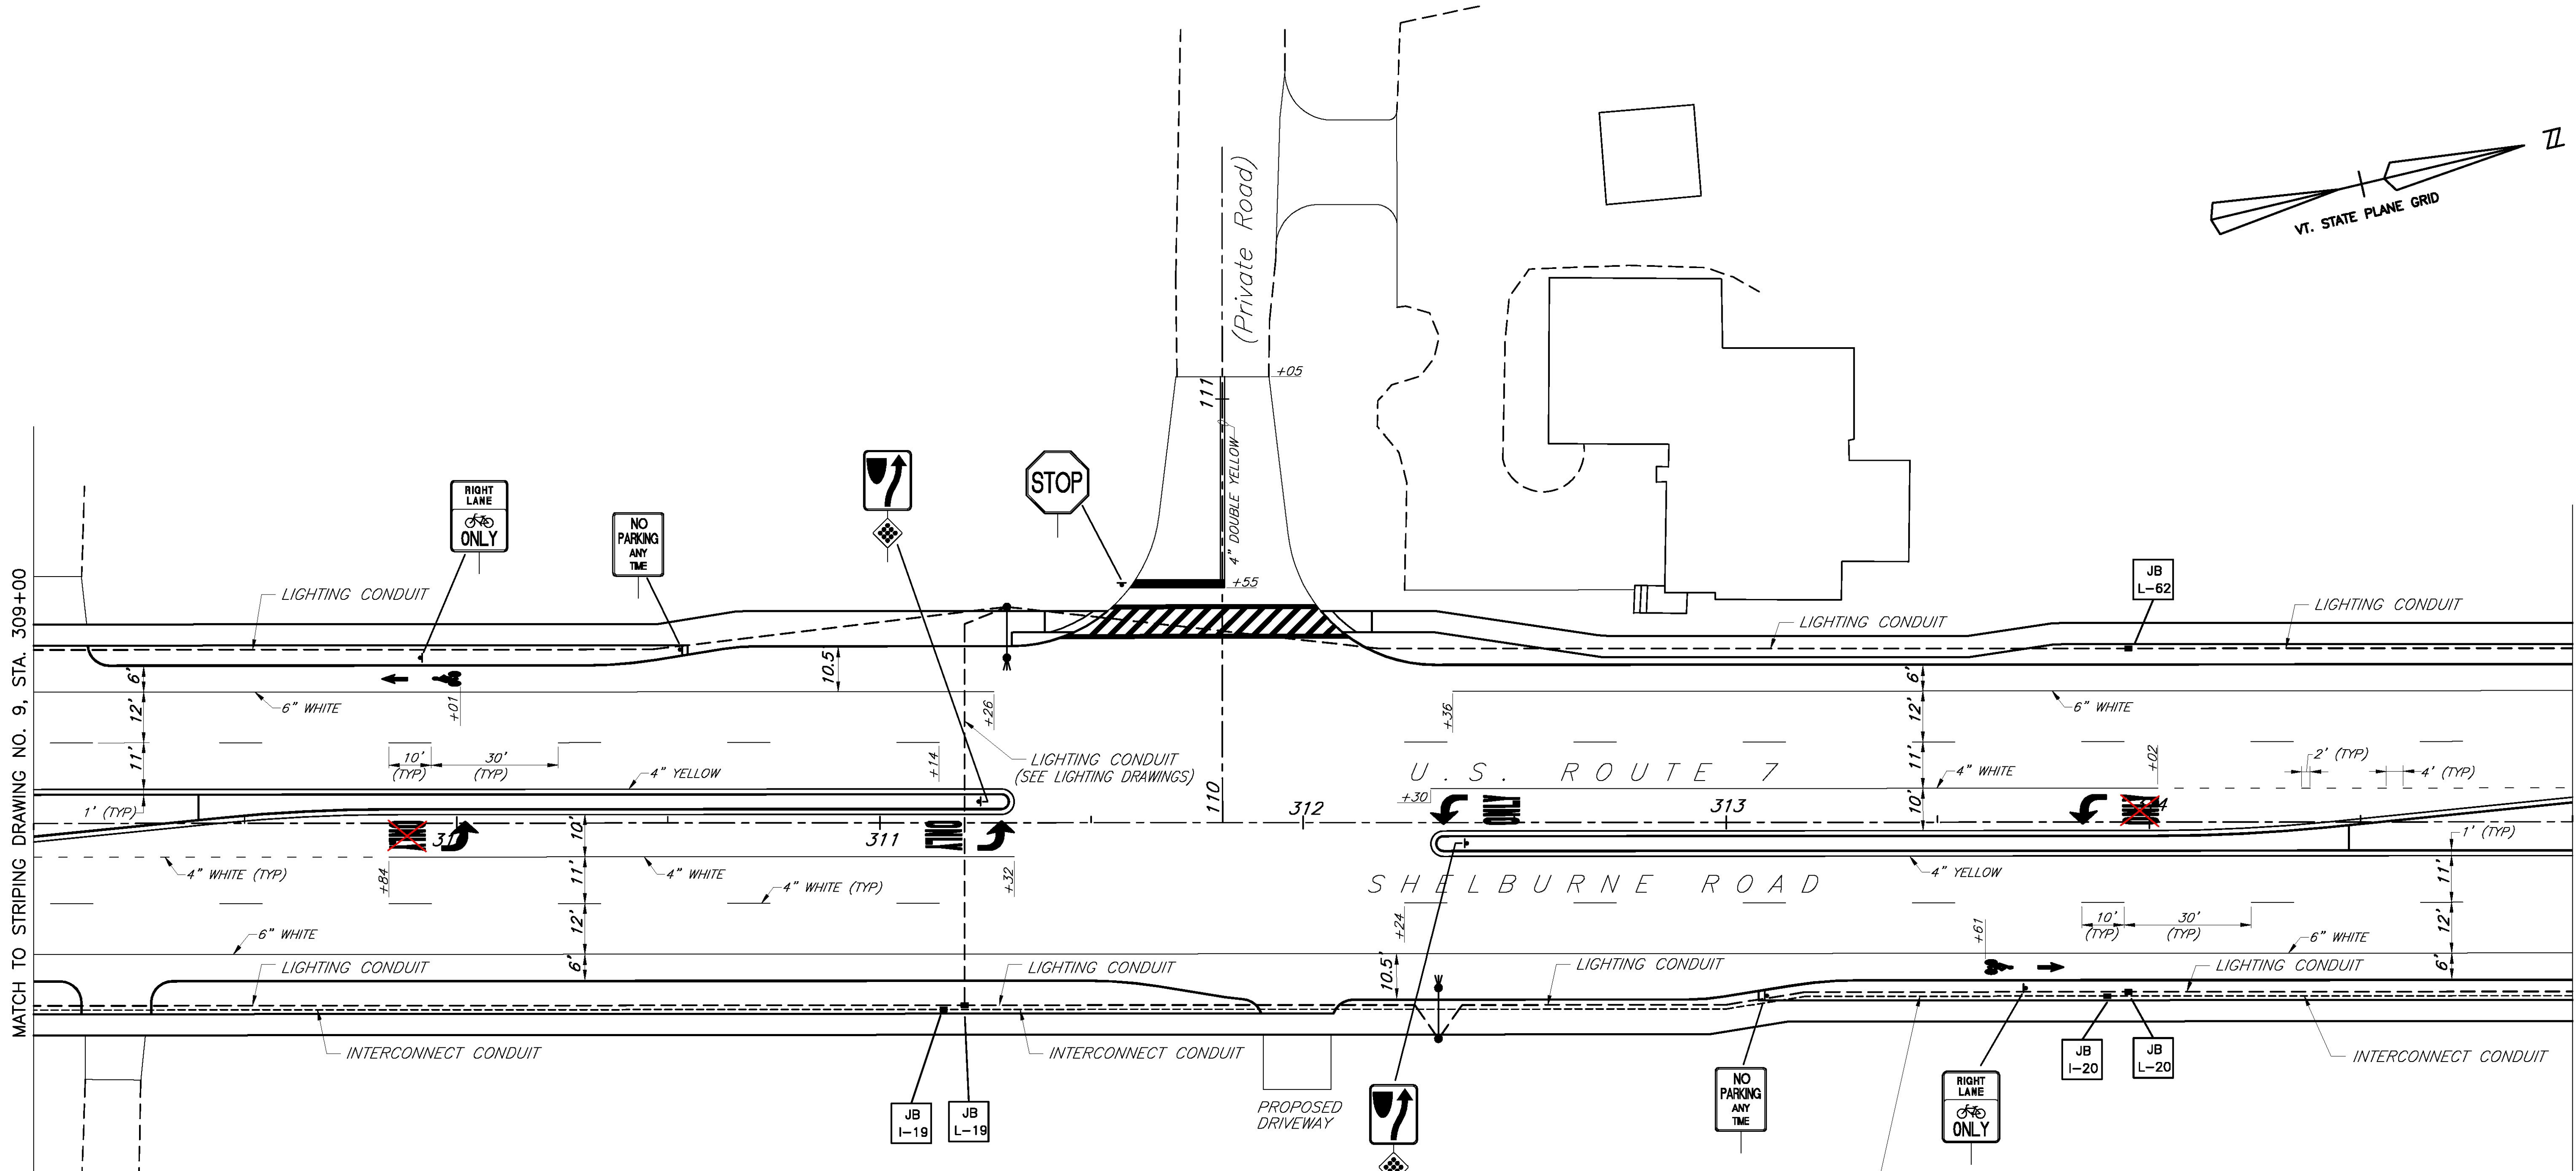

LEGEND	
	STREET LIGHT POLE
	UTILITY POLE
	LUMINAIRE
	STRAIN POLE W/ MAST ARM
	PEDESTRIAN POLE
	PULL BOX OR JUNCTION BOX
	SIGNAL CONDUIT
	INTERCONNECT CABLE CONDUIT
	LIGHTING CONDUIT
	SIGN MOUNTING POST(S)
	OVERHEAD MOUNTED SIGN
	= SIGNAL PULLBOX NUMBER
	= INTERCONNECT JUNCTION BOX NUMBER
	= LIGHTING JUNCTION BOX NUMBER
	= POWER SOURCE PULLBOX NUMBER

**SIGN NOTES:**

THE CONTRACTOR SHALL PROVIDE APPROPRIATE HARDWARE TO TOP MOUNT THE STREET NAME SIGNS, INCIDENTAL TO THE TRAFFIC SIGN ITEMS.

SIGNS ON THE MAST ARMS SHALL BE MOUNTED WITH BLACK HARDWARE ARE TO MATCH THE MAST ARM AND SHALL BE PAID UNDER ITEM 675.20, TRAFFIC SIGNS, TYPE A.

ALL SIGNS AND POSTS ARE NEW UNLESS OTHERWISE NOTED.

CCTA BUS STOP SIGNS TO BE OBTAINED FROM CCTA.

**GENERAL NOTES:**

SEE LIGHTING DRAWINGS NO's. 1 THROUGH 21 FOR LIGHTING CONDUITS, JUNCTION BOXES, WIRING AND SLEEVES.


SEE LIGHTING DRAWINGS NO's. 1 THROUGH 21 FOR INTERCONNECT CONDUITS, JUNCTION BOXES, WIRING AND SLEEVES

SEE SIGNAL DRAWINGS NO's. 1 THROUGH 14 FOR SIGNAL CONDUITS, PULLBOXES, WIRING, POLES AND SLEEVES.

INTERCONNECTING CABLE SHALL BE PLACED IN 2" PVC SCHEDULE 40 CONDUIT

SEE TYPICAL SECTION DRAWING NO. 7 FOR TYPICAL CONDUIT PLACEMENT DETAIL.

RECORD DRAWING REVISIONS		
NO	DATE	DESCRIPTION
1.	7/24/09	FIELD MARK UPS ADDED TO THE PLANS

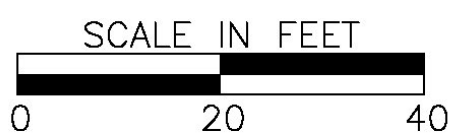

7/20/04

SHELBURNE	
SURVEYED BY	V.S.C. INC. DATE _____
DRAWN BY	E.A.A. INC. DATE _____
TRACED BY	E.A.A. INC. DATE _____
PROJECT	NH-EGC-019-4(27)
SIGN AND STRIPING DRAWING NO.	10
SHEET NO.	167 OF 537

DATUM  
VERTICAL NGVD 1929  
HORIZONTAL NAD 1927