

GENERAL NOTES:

SEE LIGHTING DRAWINGS NO's. 1 THROUGH 21 FOR LIGHTING CONDUITS, JUNCTION BOXES, WIRING AND SLEEVES.

SEE LIGHTING DRAWINGS NO's. 1 THROUGH 21 FOR INTERCONNECT CONDUITS, JUNCTION BOXES, WIRING AND SLEEVES

SEE SIGNAL DRAWINGS NO's. 1 THROUGH 14 FOR SIGNAL CONDUITS, PULLBOXES, WIRING, POLES AND SLEEVES.

INTERCONNECTING CABLE SHALL BE PLACED IN 2" PVC SCHEDULE 40 CONDUIT

SEE TYPICAL SECTION DRAWING NO. 7 FOR TYPICAL CONDUIT PLACEMENT DETAIL.


SIGN NOTES:

THE CONTRACTOR SHALL PROVIDE APPROPRIATE HARDWARE TO TOP MOUNT THE STREET NAME SIGNS, INCIDENTAL TO THE TRAFFIC SIGN ITEMS.

SIGNS ON THE MAST ARMS SHALL BE MOUNTED WITH BLACK HARDWARE ARE TO MATCH THE MAST ARM AND SHALL BE PAID UNDER ITEM 675.20, TRAFFIC SIGNS, TYPE A.


ALL SIGNS AND POSTS ARE NEW UNLESS OTHERWISE NOTED.

CCTA BUS STOP SIGNS TO BE OBTAINED FROM CCTA.

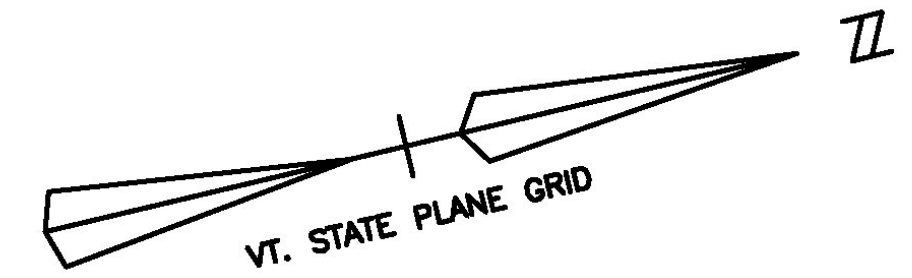

MATCH TO STRIPING DRAWING NO. 14, STA. 339+00

MATCH TO STRIPING DRAWING NO. 16, STA. 345+00

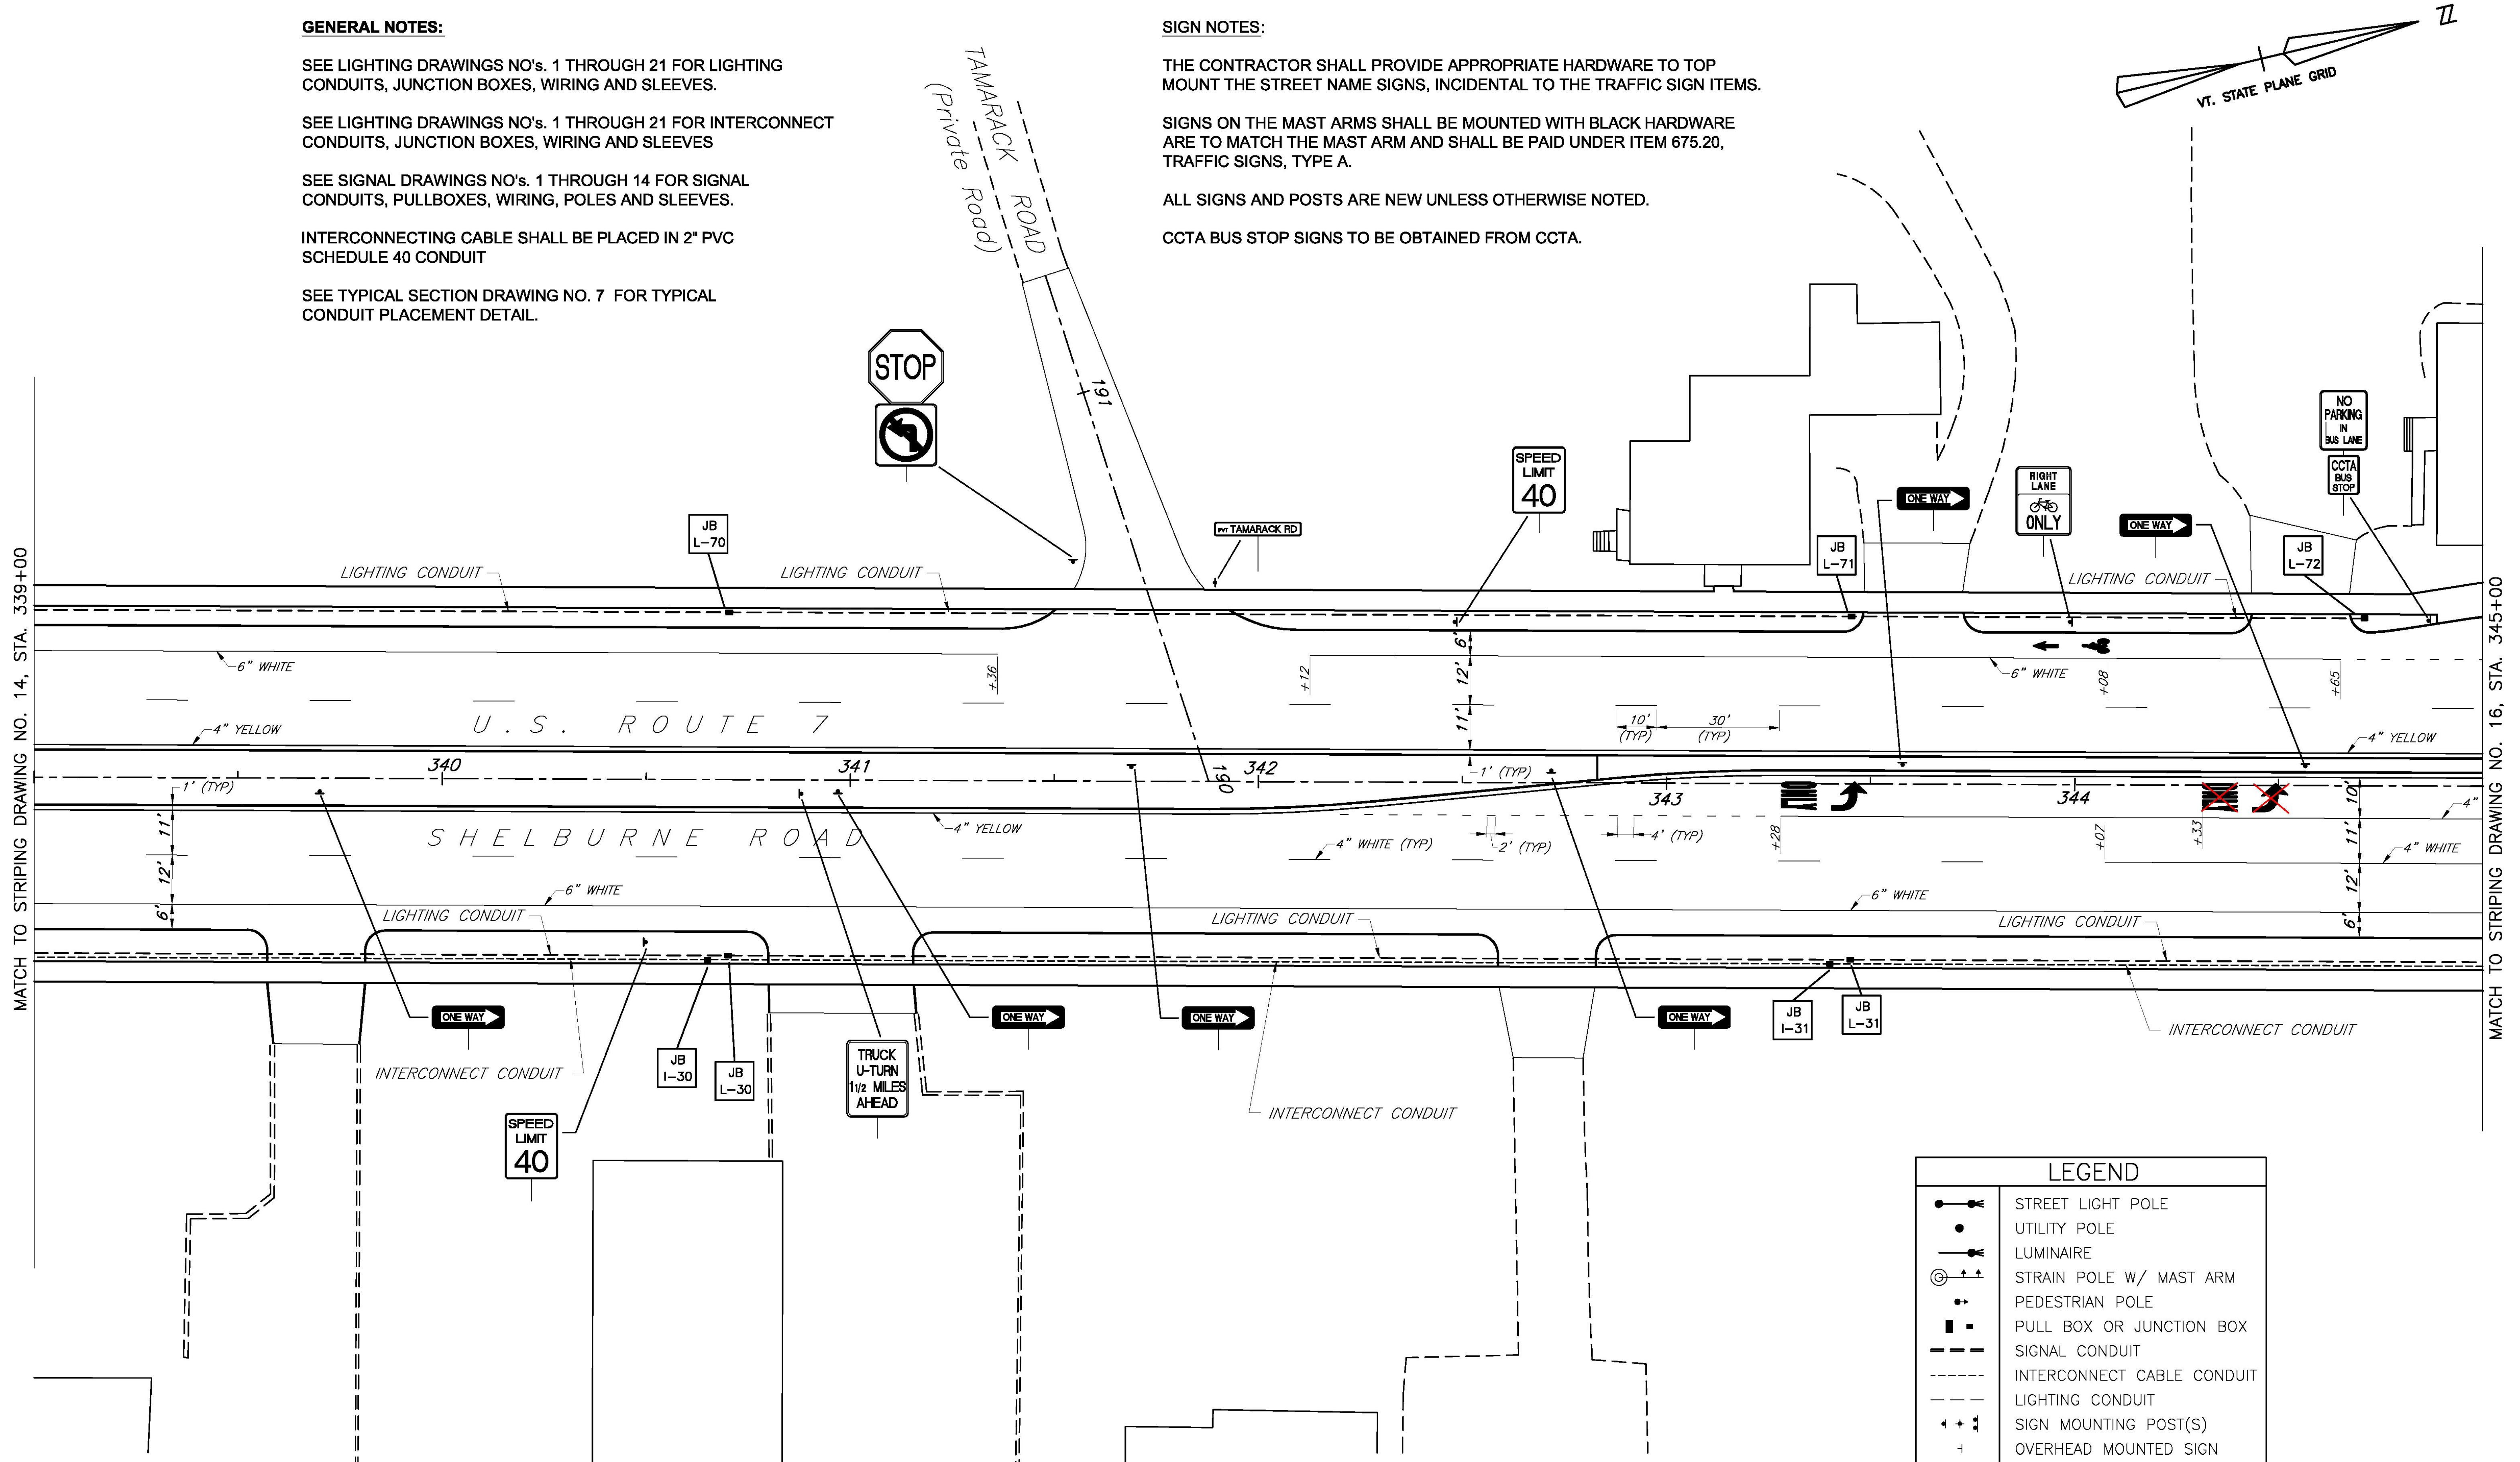

| LEGEND | |
|--------|--------------------------------------|
| | STREET LIGHT POLE |
| | UTILITY POLE |
| | LUMINAIRE |
| | STRAIN POLE W/ MAST ARM |
| | PEDESTRIAN POLE |
| | PULL BOX OR JUNCTION BOX |
| | SIGNAL CONDUIT |
| | INTERCONNECT CABLE CONDUIT |
| | LIGHTING CONDUIT |
| | SIGN MOUNTING POST(S) |
| | OVERHEAD MOUNTED SIGN |
| | ▣ = SIGNAL PULLBOX NUMBER |
| | ▣ = INTERCONNECT JUNCTION BOX NUMBER |
| | ▣ = LIGHTING JUNCTION BOX NUMBER |
| | ▣ = POWER SOURCE PULLBOX NUMBER |

| RECORD DRAWING REVISIONS | | |
|--------------------------|---------|-----------------------------------|
| NO. | DATE | DESCRIPTION |
| 1. | 7/24/09 | FIELD MARK UPS ADDED TO THE PLANS |

7/20/04



SHELburne

SURVEYED BY V.S.C. INC. DATE _____
 DRAWN BY E.A.A. INC. DATE _____
 TRACED BY E.A.A. INC. DATE _____

PROJECT NH-EGC-019-4(27)
 SIGN AND STRIPING DRAWING NO. 15
 SHEET NO. 172 OF 537

DATUM
 VERTICAL NGVD 1929
 HORIZONTAL NAD 1927