

SLEEVE LOCATIONS	
265+11, 28.7' LT.	- 265+53, 29.1' LT.
265+13, 33.0' RT.	- 265+62, 33.5' RT.
265+63, 21.6' LT.	- 265+63, 24.1' RT.
266+46, 30.2' RT.	- 266+58, 49.3' RT.

FROM	TO	ITEM 678.20 (MOD.) INTERCONNECT CONDUIT 3"	ITEM 678.21 ELECTRICAL CONDUIT 2"	ITEM 678.23 WIRED CONDUIT		ITEM 678.30 ELECTRICAL CONDUIT SLEEVE		DESCRIPTION
				2"	2 1/2"	8"	12"	
POWER SOURCE	STANCHION			95				SHELburne LIGHTING
POWER SOURCE	STANCHION					95		SIGNAL / VAOT LIGHTING - POWER
STANCHION	JB L-2		84					SHELburne LIGHTING
STANCHION	PB I-2			80				VAOT LIGHTING - POWER
STANCHION	PB I-2			80				SIGNAL - POWER
JB L-2	JB L-1			32				SHELburne LIGHTING
PB I-2	PB I-1		33				23	SPARE
PB I-2	PB I-1	33						INTERCONNECT
PB I-2	PB I-1			33				VAOT LIGHTING
PB I-2	PB I-1			33				SIGNAL
PB I-1	CONTROLLER	70						INTERCONNECT
PB I-1	CONTROLLER			70				SIGNAL - POWER
PB I-1	PB S-1			80				VAOT LIGHTING - POWER
PB S-1	CONTROLLER			15				SIGNAL
PB S-1	CONTROLLER			15				LOOP #4, #8 / PRE-EMPTION
LOOP #8	PB S-1			5				LOOP #8
CANTILEVER #2	PB S-1		71				50	SPARE
CANTILEVER #2	PB S-1		71					SIGNAL
CANTILEVER #2	PB S-1		71					VAOT LIGHTING
PED POLE	PB S-1		34					SIGNAL
CANTILEVER #4	PB S-1		18					SIGNAL
CANTILEVER #4	PB S-1		18					VAOT LIGHTING
CANTILEVER #4	PB S-1		18					PRE-EMPTION
PB S-1	PB S-2		63				46	SPARE
PB S-1	PB S-2		63					SIGNAL
PB S-1	PB S-2		63					VAOT LIGHTING
PB S-1	PB S-2		63					LOOP #4 / PRE-EMPTION
CANTILEVER #3	PB S-2		16					SIGNAL
CANTILEVER #3	PB S-2		16					VAOT LIGHTING
PED POLE	PB S-2		35					SIGNAL
LOOP #4	PB S-2		13					LOOP #4
PB S-2A	PB S-2		66				41	SPARE
PB S-2A	PB S-2		66					SIGNAL
PB S-2A	PB S-2		66					VAOT LIGHTING
PB S-2A	PB S-2		66					PRE-EMPTION
CANTILEVER #1	PB S-2A		10					SIGNAL
CANTILEVER #1	PB S-2A		10					VAOT LIGHTING
CANTILEVER #1	PB S-2A		10					PRE-EMPTION
TOTAL		103	317	1170	190		160	

INTERCONNECT ITEMS

ITEM 678.25 - PULL BOX - STANDARD

- 5+62, 7' RT. (I-1)
- 5+62, 23' LT. (I-2)

LIGHTING ITEMS




ITEM 678.26 - JUNCTION BOX

- 5+58, 7' RT. (L-1)
- 5+59, 22' LT. (L-2)

SIGNAL ITEMS

ITEM 678.27 - PULL BOX - DOUBLE


- 265+63, 28' LT. (S-2)
- 265+65, 32' RT. (S-1)
- 265+10, 33' LT. (S-2A)

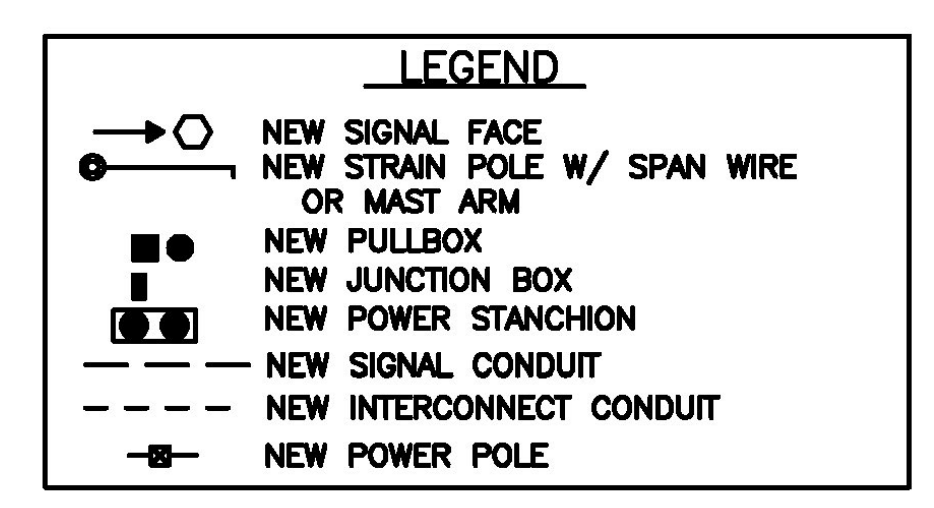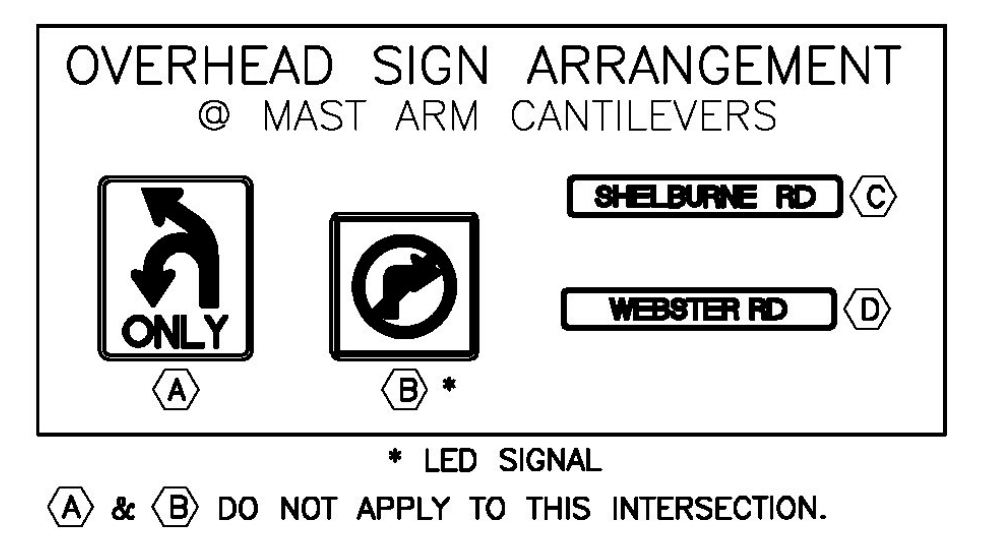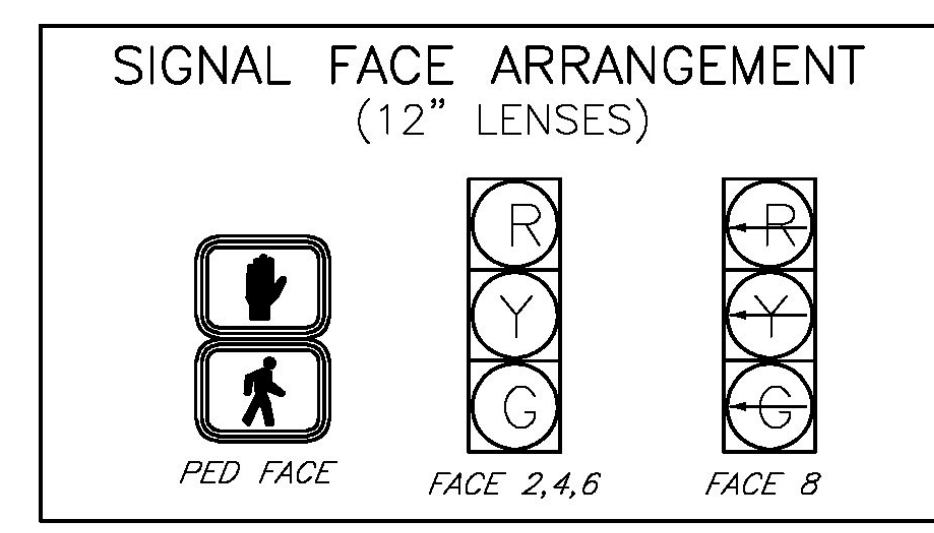

RECORD DRAWING REVISIONS

NO.	DATE	DESCRIPTION
1.	7/24/09	FIELD MARK UPS ADDED TO THE PLANS

NOTE:
 SEE SIGNAL DRAWING NOS. 1 & 2 FOR:
 TRAFFIC SIGNAL & GENERAL NOTES AND
 LIST OF MAJOR EQUIPMENT.

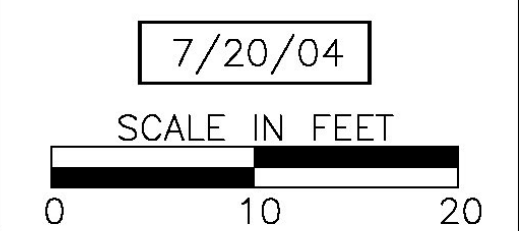

SHELburne
 SURVEYED BY V.S.C. INC. DATE _____
 DRAWN BY E.A.A. INC. DATE _____
 TRACED BY E.A.A. INC. DATE _____
 PROJECT NH-EGC-019-4(27)
 SIGNAL DRAWING NO. 3
 SHEET NO. 221 OF 537

INTERSECTION NO. MS-511 (US 7 - WEBSTER ROAD NORTH)

DATUM
 VERTICAL NGVD 1929
 HORIZONTAL NAD 1927