
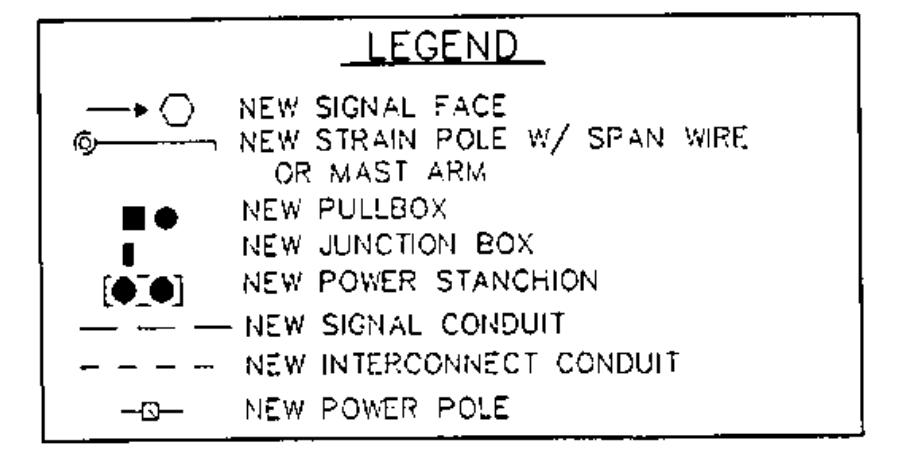
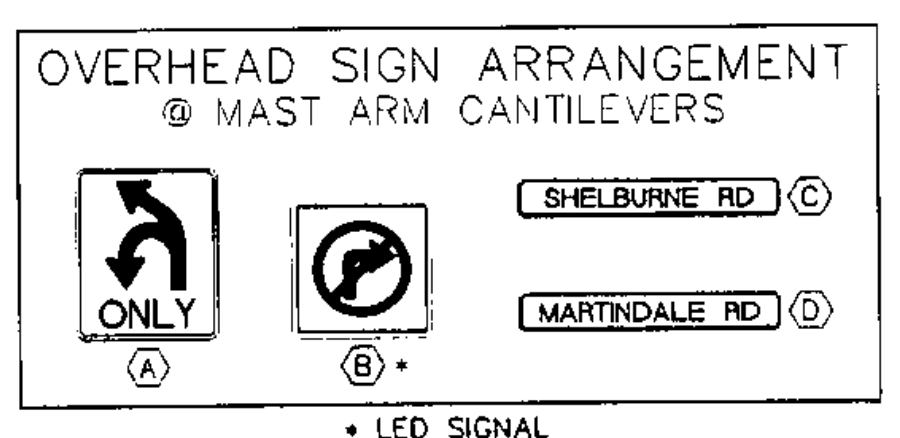
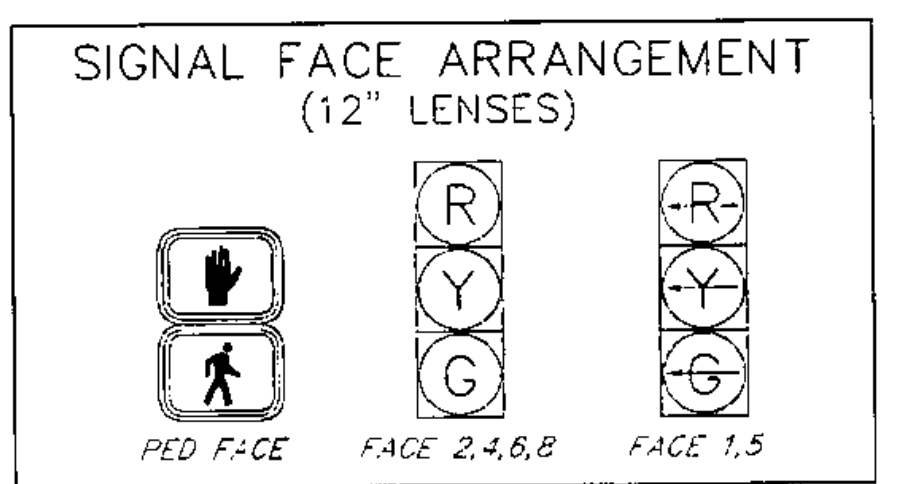



SLEEVE LOCATIONS	
363+83, 51.0' LT. - 364+25, 50.2' LT.	
363+92, 53.9' RT. - 364+37, 54.5' RT.	
364+52, 45.9' RT. - 364+52, 40.5' LT.	

FROM	TO	ITEM 678.20 (MOD.) INTERCONNECT CONDUIT	ITEM 678.21 ELECTRICAL CONDUIT	ITEM 678.23 WIRED CONDUIT		ITEM 678.30 ELECTRICAL CONDUIT SLEEVE		DESCRIPTION
				2"	2 1/2"	8"	12"	
POWER SOURCE STANCHION	STANCHION			48				SHELburne LIGHTING
POWER SOURCE STANCHION	STANCHION			48				SIGNAL / VAOT LIGHTING - POWER
STANCHION CONTROLLER	CONTROLLER			22				SIGNAL - POWER
STANCHION PB S-16	PB S-16			5				VAOT LIGHTING - POWER
JB I-40 CONTROLLER	CONTROLLER	82						INTERCONNECT
JB I-39 PB S-15	PB S-15	47						INTERCONNECT
CANTILEVER #17 PB S-15	PB S-15		17					SPARE
CANTILEVER #17 PB S-15	PB S-15		17					SIGNAL
LIGHT POLE V5 PB S-15	PB S-15		20					VAOT LIGHTING
LOOP #1 PB S-15	PB S-15		20					LOOP #1
PB S-15 PB S-16	PB S-16		63				45	SPARE
PB S-15 PB S-16	PB S-16		63					VAOT LIGHTING
PB S-15 PB S-16	PB S-16		63					SIGNAL
PB S-15 PB S-16	PB S-16		63					LOOP #1
PB S-15 PB S-16	PB S-16	53						INTERCONNECT
LOOP #8 PB S-16	PB S-16		16					LOOP #8
CANTILEVER #19 PB S-16	PB S-16		26					SIGNAL
CANTILEVER #19 PB S-16	PB S-16		26					LIGHTING
CANTILEVER #19 PB S-16	PB S-16		26					PRE-EMPTION
CANTILEVER #19 PB S-16	PB S-16		22					SIGNAL
PB S-16 CONTROLLER	CONTROLLER		22					LOOP #1, #4, #5, #8 / PRE-EMPTION
PB S-16 CONTROLLER	CONTROLLER	22						INTERCONNECT
PB S-16 PB S-17	PB S-17		104				86	SPARE
PB S-16 PB S-17	PB S-17		104					VAOT LIGHTING
PB S-16 PB S-17	PB S-17		104					SIGNAL
PB S-16 PB S-17	PB S-17		104					LOOP #4, #5 / PRE-EMPTION
LOOP #5 PB S-17	PB S-17		20					LOOP #5
CANTILEVER #18 PB S-17	PB S-17		24					VAOT LIGHTING
CANTILEVER #18 PB S-17	PB S-17		24					SIGNAL
PED POLE PB S-17	PB S-17		20					SIGNAL
PB S-17 CANTILEVER #16	CANTILEVER #16		78				42	SPARE
PB S-17 CANTILEVER #16	CANTILEVER #16		78					SIGNAL
PB S-17 CANTILEVER #16	CANTILEVER #16		78					LOOP #4 / PRE-EMPTION
LOOP #4 CANTILEVER #16	CANTILEVER #16		15					LOOP #4
TOTAL		194	262	982	96		173	

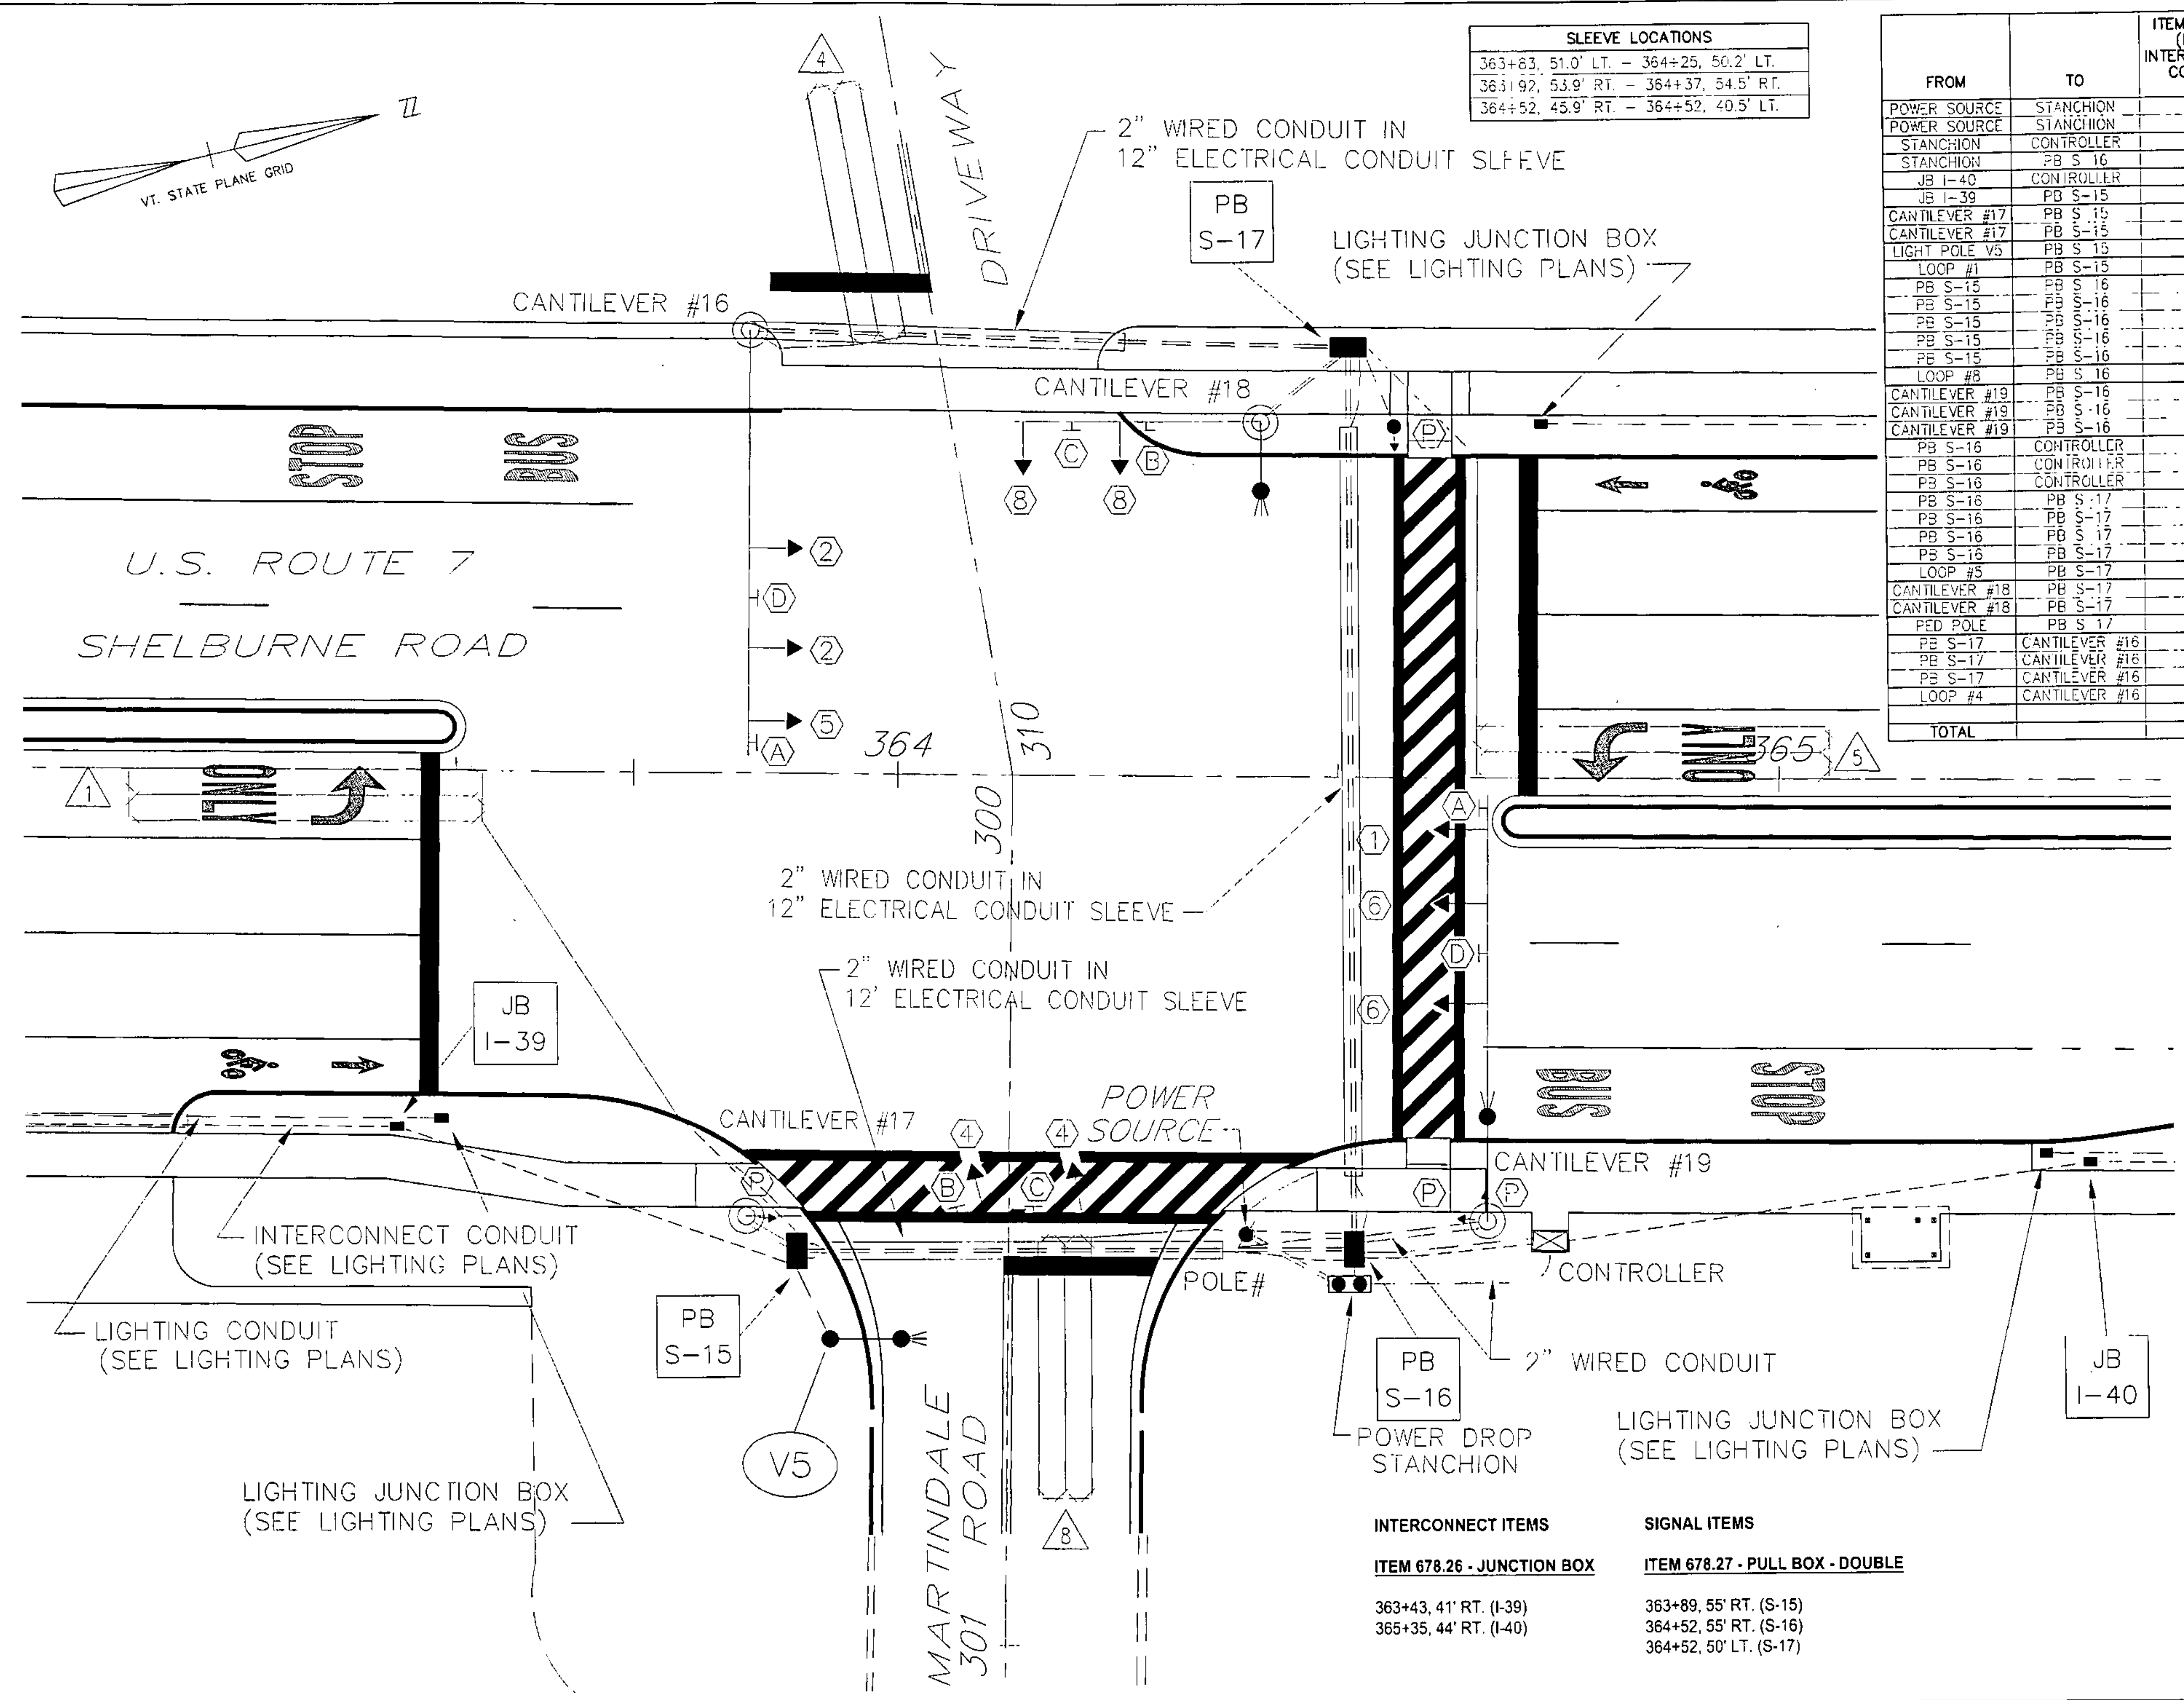

INTERCONNECT ITEMS	SIGNAL ITEMS
ITEM 678.26 - JUNCTION BOX	ITEM 678.27 - PULL BOX - DOUBLE
363+43, 41' RT. (I-39)	363+89, 55' RT. (S-15)
365+35, 44' RT. (I-40)	364+52, 55' RT. (S-16)
	364+52, 50' LT. (S-17)

NOTE:
SEE SIGNAL DRAWING NOS. 1 & 2 FOR:
TRAFFIC SIGNAL & GENERAL NOTES AND
LIST OF MAJOR EQUIPMENT.

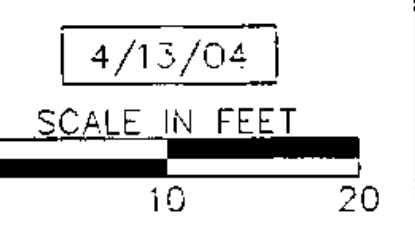

SHELburne
SURVEYED BY V.S.C. INC. DATE _____
DRAWN BY E.A.A. INC. DATE _____
TRACED BY E.A.A. INC. DATE _____
PROJECT NH-EGC-019-4(27)
SIGNAL DRAWING NO. 11
SHEET NO. 229 OF 537

DATUM
VERTICAL NGVD 1929
HORIZONTAL NAD 1927

INTERSECTION NO. MS-513 (US 7 - MARTINDALE ROAD)